

For KCC Use:
 Effective Date: 11-508
 District # _____
 SGA? Yes No

KANSAS CORPORATION COMMISSION
 OIL & GAS CONSERVATION DIVISION

Form C-1
 October 2007
 Form must be Typed
 Form must be Signed
 All blanks must be Filled

NOTICE OF INTENT TO DRILL

Must be approved by KCC five (5) days prior to commencing well

Expected Spud Date: November 7, 2008
 month day year

OPERATOR: License# 31093
 Name: Becker Oil Corporation
 Address 1: P. O. Box 1150
 Address 2: _____
 City: Ponca City State: OK Zip: 74602
 Contact Person: Clyde M. Becker, Jr.
 Phone: 303-816-2013

CONTRACTOR: License# 33549 4958
 Name: Landmark Drilling LLC Maillard, J.V. Inc *per opet. 10-27-08*

Well Drilled For: Oil Gas
 Enh Rec Storage Disposal
 Seismic; # of Holes _____
 Other: _____
 If OWWO: old well information as follows:

Well Class: Infield Pool Ext. Wildcat Other

Type Equipment: Mud Rotary Air Rotary Cable

Operator: _____
 Well Name: _____
 Original Completion Date: _____ Original Total Depth: _____

Directional, Deviated or Horizontal wellbore? Yes No
 If Yes, true vertical depth: _____
 Bottom Hole Location: _____
 KCC DKT #: _____

Spot Description: S/2 NW NE NW Sec. 25 Twp. 23 S. R. 24 E W
 (a/a/a/a) 450 feet from N / S Line of Section
1,630 feet from E / W Line of Section

Is SECTION: Regular Irregular?
 (Note: Locate well on the Section Plat on reverse side)
 County: Hodgeman

Lease Name: Schauvilliege Well #: 1
 Field Name: _____

Is this a Prorated / Spaced Field? Yes No
 Target Formation(s): Mississippian

Nearest Lease or unit boundary line (in footage): 450'
 Ground Surface Elevation: 2371 feet MSL

Water well within one-quarter mile: Yes No
 Public water supply well within one mile: Yes No

Depth to bottom of fresh water: 200' 130'
 Depth to bottom of usable water: 670'

Surface Pipe by Alternate: I II
 Length of Surface Pipe Planned to be set: 280'

Length of Conductor Pipe (if any): _____
 Projected Total Depth: 4770'

Formation at Total Depth: Cherokee Sand

Water Source for Drilling Operations:
 Well Farm Pond Other: _____

DWR Permit #: _____
 (Note: Apply for Permit with DWR)

Will Cores be taken? Yes No
 If Yes, proposed zone: _____

AFFIDAVIT

The undersigned hereby affirms that the drilling, completion and eventual plugging of this well will comply with K.S.A. 55 et. seq.
 It is agreed that the following minimum requirements will be met:

1. Notify the appropriate district office **prior** to spudding of well;
2. A copy of the approved notice of intent to drill **shall be** posted on each drilling rig;
3. The minimum amount of surface pipe as specified below **shall be set** by circulating cement to the top; in all cases surface pipe **shall be set** through all unconsolidated materials plus a minimum of 20 feet into the underlying formation.
4. If the well is dry hole, an agreement between the operator and the district office on plug length and placement is necessary **prior to plugging**;
5. The appropriate district office will be notified before well is either plugged or production casing is cemented in;
6. If an ALTERNATE II COMPLETION, production pipe shall be cemented from below any usable water to surface within **120 DAYS** of spud date.
 Or pursuant to Appendix "B" - Eastern Kansas surface casing order #133,891-C, which applies to the KCC District 3 area, alternate II cementing must be completed within 30 days of the spud date or the well shall be plugged. **In all cases, NOTIFY district office** prior to any cementing.

I hereby certify that the statements made herein are true and correct to the best of my knowledge and belief.

Date: 10/23/08 Signature of Operator or Agent: Clyde M Becker Jr Title: President

RECEIVED
 KANSAS CORPORATION COMMISSION

OCT 29 2008

CONSERVATION DIVISION
 WICHITA, KS

For KCC Use ONLY
 API # 15 - 083-21577-0000
 Conductor pipe required None feet
 Minimum surface pipe required 200 feet per ALT. I II
 Approved by: per 10-31-08
 This authorization expires: 10-31-09
 (This authorization void if drilling not started within 12 months of approval date.)
 Spud date: _____ Agent: _____

- Remember to:**
- File Drill Pit Application (form CDP-1) with Intent to Drill;
 - File Completion Form ACO-1 within 120 days of spud date;
 - File acreage attribution plat according to field proration orders;
 - Notify appropriate district office 48 hours prior to workover or re-entry;
 - Submit plugging report (CP-4) after plugging is completed (within 60 days);
 - Obtain written approval before disposing or injecting salt water.
 - If this permit has expired (See: authorized expiration date) please check the box below and return to the address below.
- Well Not Drilled - Permit Expired Date: _____
 Signature of Operator or Agent: _____

25
 23
 24
 E
 W

IN ALL CASES PLOT THE INTENDED WELL ON THE PLAT BELOW

Plat of acreage attributable to a well in a prorated or spaced field

If the intended well is in a prorated or spaced field, please fully complete this side of the form. If the intended well is in a prorated or spaced field complete the plat below showing that the well will be properly located in relationship to other wells producing from the common source of supply. Please show all the wells and within 1 mile of the boundaries of the proposed acreage attribution unit for gas wells and within 1/2 mile of the boundaries of the proposed acreage attribution unit for oil wells.

API No. 15 - 083-21577-0000
 Operator: Becker Oil Corporation
 Lease: Schauvilliege
 Well Number: 1
 Field: _____
 Number of Acres attributable to well: _____
 QTR/QTR/QTR/QTR of acreage: S/2 - NW - NE - NW


Location of Well: County: Hodgeman
450 feet from N / S Line of Section
1,630 feet from E / W Line of Section
 Sec. 25 Twp. 23 S. R. 24 E W

Is Section: Regular or Irregular


If Section is Irregular, locate well from nearest corner boundary.
 Section corner used: NE NW SE SW

PLAT

(Show location of the well and shade attributable acreage for prorated or spaced wells.)
 (Show footage to the nearest lease or unit boundary line.)

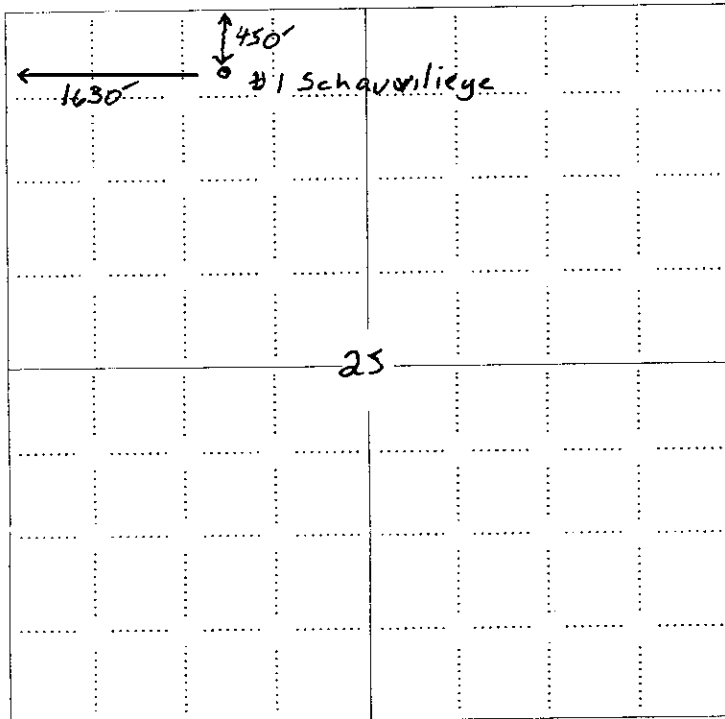

RECEIVED
 KANSAS CORPORATION COMMISSION
 OCT 29 2008
 CONSERVATION DIVISION
 WICHITA, KS

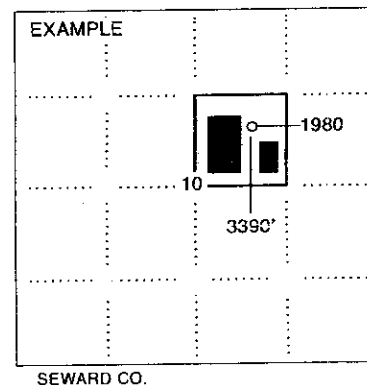


NOTE: In all cases locate the spot of the proposed drilling location.


In plotting the proposed location of the well, you must show:

1. The manner in which you are using the depicted plat by identifying section lines, i.e. 1 section, 1 section with 8 surrounding sections, 4 sections, etc.
2. The distance of the proposed drilling location from the south / north and east / west outside section lines.
3. The distance to the nearest lease or unit boundary line (in footage).
4. If proposed location is located within a prorated or spaced field a certificate of acreage attribution plat must be attached: (CO-7 for oil wells; CG-8 for gas wells).

15-083-21577-0000

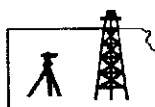

ROBINSON SERVICES
Oil Field & Construction Staking
P.O. Box 2324
Garden City, Kansas 67846
Office/Fax: (620) 276-6159
Cell: (620) 272-1499

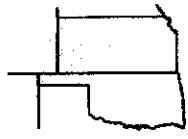

s102008-r
PLAT NO.

7981
INVOICE NO.

Becker Oil Company
OPERATOR
Hodgeman County, KS
COUNTY

25 23s 24w
Sec. Twp. Rng.

Schauvillage #1-25
LEASE NAME
450' FNL - 1630' FWL
LOCATION SPOT


SCALE: **1" = 1000'**
DATE STAKED: **Oct. 20th, 2008**
MEASURED BY: **Harris S.**
DRAWN BY: **Gabe Q.**
AUTHORIZED BY: **Clyde B. & Doug B.**



GR. ELEVATION: **2370.9'**

Directions: From the North side of Jetmore, Ks at the intersection of Hwy 156 & Hwy 283 - Now go 5 miles South on Hwy 283 to the SE corner of section 25-23s-24w - Now go 1 mile West on H Rd - Now go 1 mile North on 217 RD - Now go 0.3 mile East on unknown trail - Now go 0.1 mile South on unknown trail - Now go 269' East through pasture into staked location.
Final ingress must be verified with land owner or Becker Oil Company

*This drawing does not constitute a monumented survey or a land survey plat
This drawing is for construction purposes only*

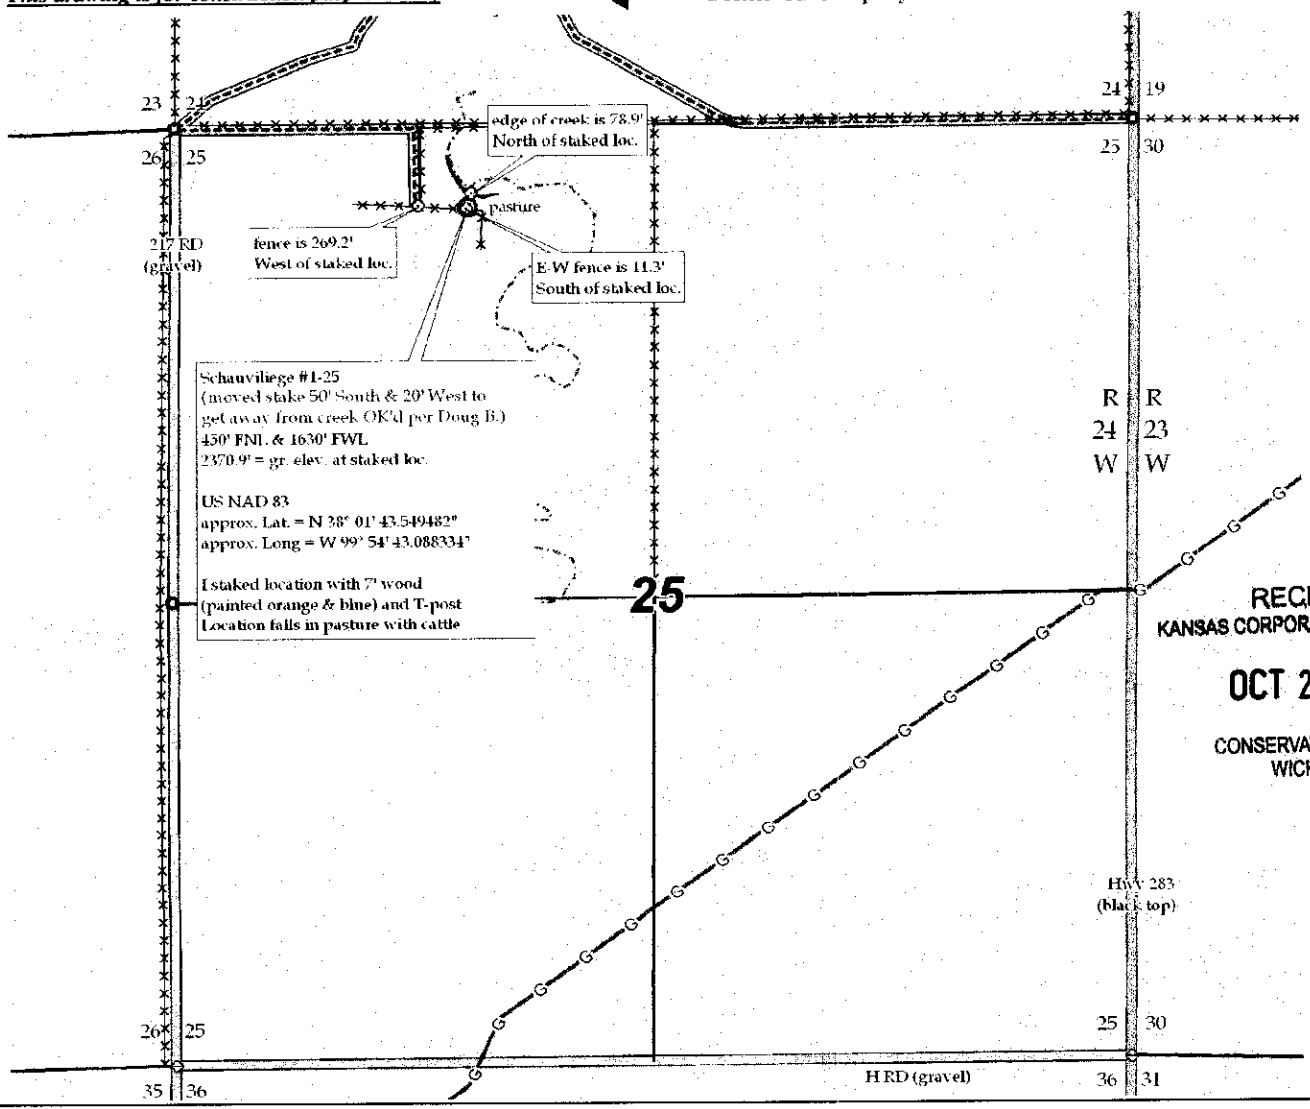

Schauvillage #1-25
(moved stake 50' South & 20' West to get away from creek OK'd per Doug B.)
450' FNL. & 1630' FWL
2370.9' = gr. elev. at staked loc.
US NAD 83
approx. Lat. = N 38° 01' 43.549482"
approx. Long = W 99° 54' 43.088334"
I staked location with 7' wood (painted orange & blue) and T-post
Location falls in pasture with cattle

R R
24 23
W W

RECEIVED
KANSAS CORPORATION COMMISSION
OCT 29 2008
CONSERVATION DIVISION
WICHITA, KS

Hwy 283
(black top)

HRD (gravel)

**KANSAS CORPORATION COMMISSION
OIL & GAS CONSERVATION DIVISION
APPLICATION FOR SURFACE PIT**

Form CDP-1
April 2004
Form must be Typed

Submit in Duplicate

Operator Name: Becker Oil Corporation		License Number: 31093	
Operator Address: P. O. Box 1150		Ponca City OK 74602	
Contact Person: Clyde M. Becker, Jr.		Phone Number: 303-697-7609	
Lease Name & Well No.: Schauviliege 1		Pit Location (QQQQ): S/2 NW NE/4 NW	
Type of Pit: <input type="checkbox"/> Emergency Pit <input type="checkbox"/> Burn Pit <input type="checkbox"/> Settling Pit <input checked="" type="checkbox"/> Drilling Pit <input type="checkbox"/> Workover Pit <input type="checkbox"/> Haul-Off Pit <i>(If WP Supply API No. or Year Drilled)</i>		Pit is: <input checked="" type="checkbox"/> Proposed <input type="checkbox"/> Existing If Existing, date constructed: _____ Pit capacity: 1,800 (bbls)	
Is the pit located in a Sensitive Ground Water Area? <input type="checkbox"/> Yes <input checked="" type="checkbox"/> No		Chloride concentration: _____ mg/l <i>(For Emergency Pits and Settling Pits only)</i>	
Is the bottom below ground level? <input checked="" type="checkbox"/> Yes <input type="checkbox"/> No		Artificial Liner? <input type="checkbox"/> Yes <input checked="" type="checkbox"/> No	
How is the pit lined if a plastic liner is not used?		_____	
Pit dimensions (all but working pits): <u>60</u> Length (feet) <u>60</u> Width (feet) <input type="checkbox"/> N/A: Steel Pits Depth from ground level to deepest point: <u>3</u> (feet) <input type="checkbox"/> No Pit			
If the pit is lined give a brief description of the liner material, thickness and installation procedure.		Describe procedures for periodic maintenance and determining liner integrity, including any special monitoring.	
Distance to nearest water well within one-mile of pit <u>2285</u> <u>4,500</u> feet Depth of water well <u>60</u> feet		Depth to shallowest fresh water <u>60</u> ⁴¹ feet. / Source of information: <u>JR-K6S</u> <input type="checkbox"/> measured <input type="checkbox"/> well owner <input type="checkbox"/> electric log <input checked="" type="checkbox"/> KDWR	
Emergency, Settling and Burn Pits ONLY: Producing Formation: _____ Number of producing wells on lease: _____ Barrels of fluid produced daily: _____ Does the slope from the tank battery allow all spilled fluids to flow into the pit? <input type="checkbox"/> Yes <input type="checkbox"/> No		Drilling, Workover and Haul-Off Pits ONLY: Type of material utilized in drilling/workover: <u>chemical mud</u> Number of working pits to be utilized: <u>2</u> Abandonment procedure: <u>allow to evaporate, backfill and replace top soil</u> Drill pits must be closed within 365 days of spud date.	
I hereby certify that the above statements are true and correct to the best of my knowledge and belief.		RECEIVED KANSAS CORPORATION COMMISSION OCT 29 2008 CONSERVATION DIVISION WICHITA, KS	
_____ Date		_____ Signature of Applicant or Agent	
KCC OFFICE USE ONLY			
Date Received: <u>10/29/08</u> Permit Number: _____		Permit Date: <u>10/31/08</u> Lease Inspection: <input checked="" type="checkbox"/> Yes <input type="checkbox"/> No	

15-083-21577-0000

Mail to: KCC - Conservation Division, 130 S. Market - Room 2078, Wichita, Kansas 67202