# For KCC Use: Effective Date: District # / Pos TNo

# KANSAS CORPORATION COMMISSION OIL & GAS CONSERVATION DIVISION

Form C-1
October 2007
Form must be Typed
Form must be Signed
All blanks must be Filled

### NOTICE OF INTENT TO DRILL

Must be approved by KCC five (5) days prior to commencing well

Expected Spud Date: November 13, 2008		Spot Description: 30'S 60'W of	
month day	year	C N/2 N/2 SW Sec. 17 Twp. 15 S	i, <u>R.</u> _19 _ ∐E⊠W
4767	(	(Q/Q/Q/Q) 2,280 feet from N	/ X S Line of Section
OPERATOR: License#		1,260 feet from E	/ X W Line of Section
Name: _ Nicille Exploration, inc.		Is SECTION: Regular Irregular?	
Address 1: PO 783188		(Note: Locate well on the Section Plat on re	everse side)
Address 2: City: Wichita State: KS Zip: 6	7278 _ 3188	County: Ellis	
Contact Person: Justin Clegg		Lease Name: Pitts 17CD	Well #: 1
Phone: 316-691-9500		Field Name: Wildcat	
1/			Yes No
CONTRACTOR: License# 33575		Is this a Prorated / Spaced Field?  Target Formation(s): Reagan Sand	
Name: WW Drilling, LLC		larget Formation(s):	
Well Drilled For: Well Class: Typ	e Equipment:	Target Formation(s): Reagan Sano  Nearest Lease or unit boundary line (in footage): 360'  Ground Surface Elevation: 1974	feet MSL
XOil	Tide of Boton	Ground Sunace Elevation.	☐Yes No ✓
Gas Storage Pool Ext.	Air Rotary	Water well within one-quarter mile: Public water supply well within one mile:	Yes X No
Disposal	Cable	Depth to bottom of fresh water:	
Seismic : # of Holes Other	-	Depth to bottom of usable water: 460	
Other:			
		Surface Liberty Attentions [72].	
If OWWO: old well information as follows:		Length of Surface Pipe Planified to be set. None	
Operator:		Length of Conductor Pipe (ii arry).	
Weil Name:		Projected Total Depth: 3700'  Formation at Total Depth: Reagan Sand	
Original Completion Date: Original Total	al Depth:	Formation at Total Depth:	
	∏Yes⊠No	Water Source for Drilling Operations:	
Directional, Deviated or Horizontal wellbore?	البينا السا	Well Farm Pond Other: X	
If Yes, true vertical depth:		DWR Permit #: (Note: Apply for Permit with DWR	
Bottom Hole Location: KCC DKT #:		Will Cores be taken?	Yes X No
KCC DKT #:		If Yes, proposed zone:	
		II 165, proposed 2016.	RECEIVED
	AFFID	AVIT	SAS CORPORATION COMMISSION
	AFFIDA	2 1 T T T	GAG GOAL GALL
The undersigned hereby affirms that the drilling, comp	Sietion and eventual pluggii	ng or this well wan comply wan to an account	NOV 0 5 2008
It is agreed that the following minimum requirements			1101 0 0 2000
Notify the appropriate district office <i>prior</i> to spi     A copy of the approved notice of intent to drill spi		illing rig; circulating cement to the top; in all cases surface pipe	CONSERVATION DIVISION Shall by Salita, KS
4. It sho wall in dry halo, an agreement between th	ne operator and the district	Office on plug length and placement is necessary pri	lor to plugging;
6. If an ALTERNATE II COMPLETION, production	n pipe shall be cemented its	801_C which annies to the KCC District 3 area, alte	
Or pursuant to Appendix "B" - Eastern Kansas	date or the well shall be Dit	ugged. In all cases, NOTIFY district office prior to	any cementing.
must be completed within 30 days of the space	true and correct to the heef	of my knowledge and belief.	
I hereby certify that the statements made herein are	Tue and correct to the desi	CIS S	Specialist
Date: November 4, 2008 Signature of Operator	or Agent:	Title: GIS C	pecialist
Dale.		Remember to:	17
For KCC Use ONLY		- File Drill Pit Application (form CDP-1) with Intent to I	
no 250110000		- File Completion Form ACO-1 within 120 days of spu	d date;
API # 15 - 051 - 250 - 10-000		- File acreage attribution plat according to field prorati	on orders;
Conductor pipe required	feet	- Notify appropriate district office 48 hours prior to wo	rkover or re-entry;
Minimum surface pipe required 480	feet per ALT.	- Submit plugging report (CP-4) after plugging is com	pleted (within 60 days);
Approved by: Pub-11-10-08		- Obtain written approval before disposing or injecting	
11-11-17		<ul> <li>If this permit has expired (See: authorized expiration check the box below and return to the address below</li> </ul>	M.
(This authorization expires: // (This authorization void if drilling not started within 12 mg	onths of approval date.)		
( mad additional total ) desired		Well Not Drilled - Permit Expired Date: Signature of Operator or Agent:	
Spud date: Agent:		Signature of Operator of Agent.	لکِّا

# IN ALL CASES PLOT THE INTENDED WELL ON THE PLAT BELOW

Plat of acreage attributable to a well in a prorated or spaced field

If the intended well is in a prorated or spaced field, please fully complete this side of the form. If the intended well is in a prorated or spaced field complete the plat below showing that the well will be properly located in relationship to other wells producing from the common source of supply. Please show all the wells and within 1 mile of the boundaries of the proposed acreage attribution unit for gas wells and within 1/2 mile of the boundaries of the proposed acreage attribution unit for oil wells.

proposed dorouge amount	
API No. 15 - 051-25846-0000	Location of Well: County: Ellis
Operator: Ritchie Exploration, Inc.	Location of Vietness Country.
Lease: Pitts 17CD	2,280 feet from N / S Line of Section
1	2,280 feet from N / S Line of Section 1,260 feet from E / W Line of Section
Well Number: 1	Sec. 17 Twp. 15 S. R. 19 E X W
Field: Wildcat	Sec. 17 1Wp. 19 0. 11.
Number of Acres attributable to well:  QTR/QTR/QTR/QTR of acreage: C - N/2 - N/2 - SW	Is Section: Regular or Irregular
QTH/QTH/QTH of dolodgor.	If Section is irregular, locate well from nearest corner boundary.  Section corner used: NE NW SE SW

#### **PLAT**


(Show location of the well and shade attributable acreage for prorated or spaced wells.) (Show footage to the nearest lease or unit boundary line.)

[ · · · · · · · · · · · · · · · · · · ·				:				
   					•••••			
				ļ 				
		: :		     117				EXAMPLE
126	O'FWL	\$ {.		1	:	:	:	
			·	,,,,,,,,,,,,,,,,,,,,,,,,,,,,,,,,,,,,,,		.,,		
		2280	:				:	
		FSC	:					
	;						i	SEWARD

RECEIVED KANSAS CORPORATION COMMISSION

NOV 0 5 2008

CONSERVATION DIVIS. WICHITA, KS

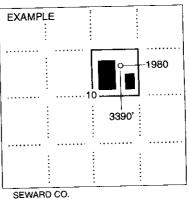

NOTE: in all cases locate the spot of the proposed drilling locaton.

### In plotting the proposed location of the well, you must show:

- 1. The manner in which you are using the depicted plat by identifying section lines, i.e. 1 section, 1 section with 8 surrounding sections, 4 sections, etc.
- 2. The distance of the proposed drilling location from the south / north and east / west outside section lines.
- 3. The distance to the nearest lease or unit boundary line (in footage).
- 4. If proposed location is located within a prorated or spaced field a certificate of acreage attribution plat must be attached: (C0-7 for oil wells; CG-8 for gas wells).



g110308-i


#### ROBINSON SERVICES

Oil Field & Construction Staking

P.O. Box 2324

Garden City, Kansas 67846 Office/Fax: (620) 276-6159

Cell: (620) 272-1499

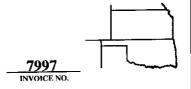

#1 Pitts 17CD Ritchie Exploration, Inc LEASE NAME OPERATOR 2280' FSL - 1260' FWL 19w <u>17</u> <u> 15s</u> Ellis County, KS LOCATION SPOT Twp COUNTY


1" =1000' SCALE:\_ Oct. 30th, 2008 DATE STAKED: Harris S. MEASURED BY: Gabe Q. DRAWN BY: Justin C. AUTHORIZED BY:

This drawing does not constitute a monumented survey or a land survey plat

GR. ELEVATION: 1973.6'

From the center of Antonino, Ks at the Directions: intersection of 210th Ave & Antonino Rd - Now go 2 miles South on 210th Ave - Now go 4 miles West on Norfolk Rd to the NW corner of section 17-15s-19w & ingress stake South into -Now go 0.5 mile South on unknown trail - Now go approx. 360' South through CRP - Now go 1260' East through CRP into staked location.

Final ingress must be verified with land owner or

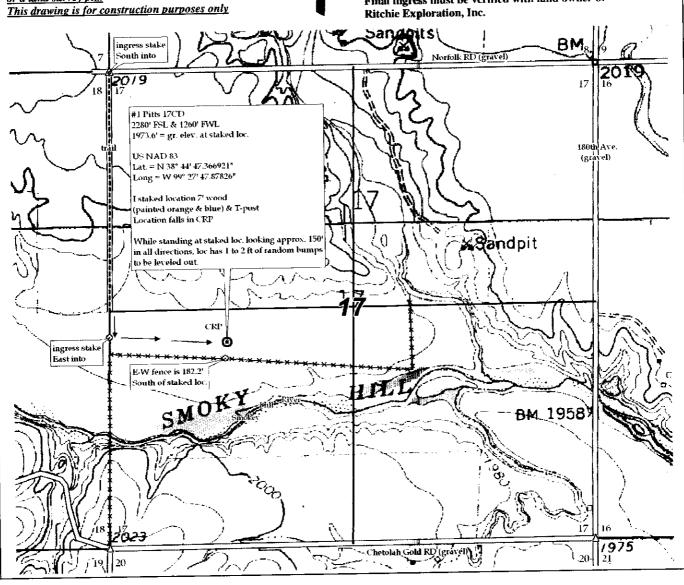



g110308-i

PLAT NO.


#### ROBINSON SERVICES

Oil Field & Construction Staking

P.O. Box 2324

Garden City, Kansas 67846 Office/Fax: (620) 276-6159

Cell: (620) 272-1499

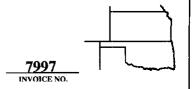

SCALE: 1" =1000'

DATE STAKED: Oct. 30th, 2008

MEASURED BY: Harris S.

DRAWN BY: Gabe Q.


AUTHORIZED BY: Justin C.

This drawing does not constitute a monumented survey

This drawing does not constitute a monumented survey or a land survey plat

GR. ELEVATION: 1973.6

**Directions:** From the center of Antonino, Ks at the intersection of 210<sup>th</sup> Ave & Antonino Rd - Now go 2 miles South on 210<sup>th</sup> Ave - Now go 4 miles West on Norfolk Rd to the NW corner of section 17-15s-19w & ingress stake South into - Now go 0.5 mile South on unknown trail - Now go approx. 360' South through CRP - Now go 1260' East through CRP into staked location.

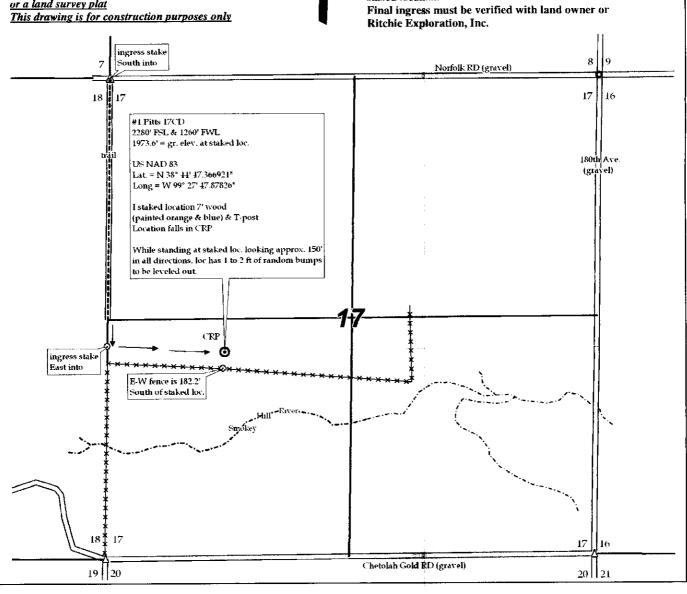

# KANSAS CORPORATION COMMISSION OIL & GAS CONSERVATION DIVISION

Form CDP-1 April 2004 Form must be Typed

## APPLICATION FOR SURFACE PIT

Submit in Duplicate

Operator Name: Ritchie Exploration, Inc.			License Number: 4767			
Operator Address: PO 783188			Wichita KS 67278			
Contact Person: Justin Clegg			Phone Number: 316-691-9500			
Lease Name & Well No.: Pitts 17CD	1		Pit Location (QQQQ):			
Type of Pit:    Emergency Pit	Pit is:	Existing	30'S 60'W N/2 N/2 SW  Sec. 17 Twp. 15 R. 19 East West			
Settling Pit Drilling Pit  Workover Pit Haul-Off Pit  (If WP Supply API No. or Year Drilled)	Pit capacity:	nstructed: (bbls)				
Is the pit located in a Sensitive Ground Water  Is the bottom below ground level?  Yes No	Area? Yes Artificial Liner?		Chloride concentration: mg/l  (For Emergency Pits and Settling Pits only)  How is the pit lined if a plastic liner is not used?  Cottonseed Hulls / Bentonite			
Pit dimensions (all but working pits):	20 Length (fe	,	Width (feet) N/A: Steel Pits  6 (feet) No Pit			
Distance to nearest water well within one-mi	le of pit	Depth to shall				
2803 feet Depth of water well 59 feet		measured well owner electric log KDWR				
Emergency, Settling and Burn Pits ONLY:  Producing Formation:  Number of producing wells on lease:  Barrels of fluid produced daily:		Drilling, Workover and Haul-Off Pits ONLY:  Type of material utilized in drilling/workover: Fresh / Chemical Mud  Number of working pits to be utilized: 3  Abandonment procedure: Backfill				
Does the slope from the tank battery allow all spilled fluids to flow into the pit? Yes No		Drill pits must be closed within 365 days of spud date.  RECEIVEL  KANSAS CORPORATION COMMI				
November 4, 2008  Date	itements are true and	correct to the be	Signature of Applicant or Agent  NOV 0 5 2008  CONSERVATION DIVISION WICHITA, KS			
Date Received: 11 5 08 Permit No		OFFICE USE	ONLY Steel Pit RFAC RFAS  mit Date: 15 08 Lease Inspection: Yes No			



Kathleen Sebelius, Governor Thomas E. Wright, Chairman Michael C. Moffet, Commissioner Joseph F. Harkins, Commissioner

November 3, 2008

Ritchie Exploration, Inc. PO Box 783188 Wichita, KS 67278-3188

RE: Drilling Pit Application Pitts 17CD Lease Well No. 1 SW/4 Sec. 17-15S-19W Ellis County, Kansas

Dear Sir or Madam:

District staff has inspected the above referenced location and has determined that the reserve pit shall be constructed <u>without slots</u>, the bottom shall be flat and reasonably level, and the free fluids must be removed. The fluids are to be removed from the reserve pit as soon as practical after drilling operations have ceased. **Keep pits away from the river.** 

If production casing is set all completion fluids shall be removed from the working pits daily. NO completion fluids or non-exempt wastes shall be placed in the reserve pit.

The fluids should be taken to an authorized disposal well. Please call the District Office at (785) 625-0550 when the fluids have been removed. Please file form CDP-5 (August 2004), Exploration and Production Waste Transfer, within 30 days of fluid removal. Conservation division forms are available through our office and on the KCC web site: www.kcc.state.ks.us/conservation/forms.

A copy of this letter should be posted in the doghouse along with the approved Intent to Drill. If you have any questions or concerns please feel free to contact the undersigned at the above address.

Sincerely,

Kathy Haynes

**Environmental Protection and Remediation Department** 

cc: district