## RECEIVED

SEP 1 6 2010

Form C-1

# KANSAS CORPORATION COMMISSION OIL & GAS CONSERVATION DIVISION

March 2010

Form must be Typed

| expected Spud Date:   | September 21, 20  | )10   | Spot Description:   |   |
|---|---|---|---|---|
|   | month da  | ay year   | SE . NW Sec. 33 Twp. 28   | SR 22 □F▼   |
| /   | 5225  |   | (Q/Q/Q/Q) 2,248 feet from X N   |   |
| PERATOR: License#<br>ame: Quinque Operating   |   |   | 1,759 feet from E   | W Line of Secti   |
| ame: Quinque Operating<br>ddress 1: 908 N.W. 71st   |   |   | Is SECTION: Regular Inregular?  | M Fille of geon   |
| dress 1:  |   |   | <del>_</del> <del></del>  |   |
| ty- Oklahoma City   | State: OK   | Zip: <u>73116</u> +   | - (Note: Locate well on the Section Plat on a   | reverse side)   |
| ontact Person: Catherin   |   |   | County.   | 4 22  |
| one: (405) 840-9876 ext   | . 129   |   | Lease Name: Feikert Farms   | Well #: _ <del>1*33</del>   |
| ONTRACTOR: License#   | 5929  |   | Field Name: Wildcat   | <u> </u>  |
| DNTRACTOR: License#<br>ame: Duke Drilling Co., In   |   |   | Is this a Prorated / Spaced Field?  | Yes ∑N  |
| airie. <u>- cons coming con, m</u>  | <u></u>   |   | Target Formation(s): Morrow, Mississippian  | _/  |
| Well Drilled For:   | Well Class:   | Type Equipment:   | Nearest Lease or unit boundary line (in footage): 1759  |   |
| ⊠Oil ⊟Enh i   | Rec Infield   | Mud Rotary  | Ground Surface Elevation: 2473  | feet MS   |
| X Gas Stora   | age Pool Ext.   | Air Rotary  | Water well within one-quarter mile:   | ×Yes ⊥  |
| Dispo   | سنا   | Cable   | Public water supply well within one mile:   | ☐Yes 🔀 I  |
| Seismic ; #   | of Holes Other  | <del></del>   | Depth to bottom of fresh water: 186 200   |   |
| Other:  | -   |   | Depth to bottom of usable water: _500'  | <del></del>   |
| THE OWNED AND WALL  | information as follows:   |   | Surface Pipe by Alternate:  |   |
| LIN OVVVO. DID Well   | HIJOHITEUUH AS IDIIOWS.   |   | Length of Surface Pipe Planned to be set: 575'  |   |
| Operator:   |   |   | Length of Conductor Pipe (if any):  |   |
|   |   |   | _ Projected Total Depth:  |   |
| Iginal Completion Da  | ate: Origin   | al Total Depth:   |   |   |
| andinant Parintal as He   | wiwe odal wallbara?   | ☐Yes X No   | Water Source for Drilling Operations:   |   |
| rectional, Deviated or Ho   | orizontai welibore?   | TesINO  | Weil Farm Pond Other:   |   |
| ·   |   |   |   |   |
| Yes, true vertical depth: _   |   |   | DWR Permit #: 4339 /  |   |
| Yes, true vertical depth: _<br>ottom Hole Location:   |   |   | DWR Permit #: 4339 / (Note: Apply for Permit with DWR   |   |
| Yes, true vertical depth: _ bittom Hole Location: CC DKT #:  ne undersigned hereby  | affirms that the drilling,  | AF<br>completion and eventual p   | DWR Permit #: 4339 /  |   |
| Yes, true vertical depth: _ ottom Hole Location: CC DKT #: he undersigned hereby is agreed that the follow 1. Notify the appropri 2. A copy of the appropri 3. The minimum amo through all uncons 4. If the well is dry ho 5. The appropriate dis 6. If an ALTERNATE Or pursuant to App must be completed   | affirms that the drilling, ving minimum requireme ate district office <i>prior</i> to be over notice of intent to sufface pipe as so olidated materials plus able, an agreement betwee strict office will be notified II COMPLETION, produce and it within 30 days of the serior within 30 days of the serior will be not the serior within 30 days of the serior will be not the serior within 30 days of the serior will be not the serior within 30 days of the serior will be not the serior within 30 days of the serior will be not the serior willess will be not the serior will be not the serior will be not the | AF completion and eventual p ents will be met: o spudding of well; drill shall be posted on ead pecified below shall be se a minimum of 20 feet into t een the operator and the die ed before well is either plug ection pipe shall be cement isas surface casing order a pud date or the well shall be   | OWR Permit #: 4339  (Note: Apply for Permit with DWR  Will Cores be taken? If Yes, proposed zone:  FIDAVIT  lugging of this well will comply with K.S.A. 55 et. seq.  ch drilling rig; If by circulating cement to the top; in all cases surface pipe ne underlying formation.  strict office on plug length and placement is necessary printinged or production casing is cemented in; led from below any usable water to surface within 120 DAY  133,891-C, which applies to the KCC District 3 area, alterning led in all cases, NOTIFY district office prior to a   | shall be set or to plugging; 'S of spud date, nate II cementing   |
| Yes, true vertical depth:   | affirms that the drilling, ving minimum requirement at a district office prior to oved notice of intent as so unit of surface pipe as so olidated materials plus able, an agreement betwee strict office will be notificall COMPLETION, produce of the second       | completion and eventual pents will be met: o spudding of well; drill shall be posted on each pecified below shall be set a minimum of 20 feet into the operator and the direction pipe shall be cement as surface casing order spud date or the well shall be are true and to the best of   | DWR Permit #: _4339 // (Note: Apply for Permit with DWR   Will Cores be taken? If Yes, proposed zone:  FIDAVIT lugging of this well will comply with K.S.A. 55 et. seq.  th drilling rig; t by circulating cement to the top; in all cases surface pipe ne underlying formation.  strict office on plug length and placement is necessary pringed or production casing is cemented in; ed from below any usable water to surface within 120 DAY   133,891-C, which applies to the KCC District 3 area, alten the plugged. In all cases, NOTIFY district office prior to a my knowledge and Relief.  | shall be set or to plugging; 'S of spud date, nate It cementing ny cementing.   |
| Yes, true vertical depth:   | affirms that the drilling, ving minimum requireme ate district office <i>prior</i> to be over notice of intent to sufface pipe as so olidated materials plus able, an agreement betwee strict office will be notified II COMPLETION, produce and it within 30 days of the serior within 30 days of the serior will be not the serior within 30 days of the serior will be not the serior within 30 days of the serior will be not the serior within 30 days of the serior will be not the serior within 30 days of the serior will be not the serior willess will be not the serior will be not the serior will be not the | completion and eventual pents will be met: o spudding of well; drill shall be posted on each pecified below shall be set a minimum of 20 feet into the operator and the direction pipe shall be cement as surface casing order spud date or the well shall be are true and to the best of   | OWR Permit #: 4339  (Note: Apply for Permit with DWR  Will Cores be taken? If Yes, proposed zone:  FIDAVIT  lugging of this well will comply with K.S.A. 55 et. seq.  th drilling rig; t by circulating cement to the top; in all cases surface pipe ne underlying formation.  strict office on plug length and placement is necessary price greated or production casing is cemented in; eed from below any usable water to surface within 120 DAY  2133,891-C, which applies to the KCC District 3 area, alten be plugged. In all cases, NOTIFY district office prior to a my knowledge and selief.  Title: Regula  | shall be set or to plugging; 'S of spud date. nate II cementing ny cementing.   |
| Yes, true vertical depth: _ ottom Hole Location: CC DKT #: ne undersigned hereby is agreed that the follow 1. Notify the appropri 2. A copy of the appro 3. The minimum amo through all uncons: 4. If the well is dry ho 5. The appropriate di: 6. If an ALTERNATE Or pursuant to Appropriate di: 7. Or pursuant to Appropriate di: 8. Or pursuant to Appropriate di: 9/15/2010     | affirms that the drilling, ving minimum requirement ate district office <i>prior</i> to eved notice of intent to count of surface pipe as solidated materials plus able, an agreement betwee strict office will be notified iff COMPLETION, produced if within 30 days of the statements made herein Signature of Operations.   | completion and eventual pents will be met: o spudding of well; drill shall be posted on each pecified below shall be set a minimum of 20 feet into the enthe operator and the died before well is either plugation pipe shall be cement has surface casing order spud date or the well shall the are true and to the best of rator or Agent:    | OWR Permit #: 4339  (Note: Apply for Permit with DWR  Will Cores be taken? If Yes, proposed zone:  FIDAVIT  lugging of this well will comply with K.S.A. 55 et. seq.  th drilling rig; If by circulating cement to the top; in all cases surface pipe the underlying formation.  Strict office on plug length and placement is necessary printing from below any usable water to surface within 120 DAY  133,891-C, which applies to the KCC District 3 area, alterning the plugged. In all cases, NOTIFY district office prior to a my knowledge and fielief.  Remember to:  Remember to:  | shall be set or to plugging; 'S of spud date. nate Il cementing ny cementing.   |
| Yes, true vertical depth: _ ottom Hole Location: CC DKT #: the undersigned hereby is agreed that the follow 1. Notify the appropri 2. A copy of the appropri 3. The minimum amo through all uncons: 4. If the well is dry ho 5. The appropriate di: 6. If an ALTERNATE Or pursuant to Appropriate di: 7. Or pursuant to Appropriate di: 8. Or pursuant to Appropriate di: 9/15/2010 | affirms that the drilling, ving minimum requirement at a district office prior to oved notice of intent as so unit of surface pipe as so olidated materials plus able, an agreement betwee strict office will be notificall COMPLETION, produce of the second       | completion and eventual pents will be met: o spudding of well; drill shall be posted on each pecified below shall be set a minimum of 20 feet into the enthe operator and the died before well is either plugation pipe shall be cement has surface casing order spud date or the well shall the are true and to the best of rator or Agent:    | OWR Permit #: _4339  (Note: Apply for Permit with DWR    Will Cores be taken? If Yes, proposed zone:  FIDAVIT  lugging of this well will comply with K.S.A. 55 et. seq.  th drilling rig; the production casing is cemented in; ed from below any usable water to surface within 120 DAY  2133,891-C, which applies to the KCC District 3 area, alten be plugged. In all cases, NOTIFY district office prior to a my knowledge and selief.  Title: Regula  Remember to:  File Certification of Compliance with the Kansas Surface   | shall be set or to plugging; 'S of spud date. nate Il cementing ny cementing.   |
| res, true vertical depth:   | affirms that the drilling, ving minimum requireme ate district office <i>prior</i> to oved notice of intent to out of surface pipe as solicidated materials plus as ite, an agreement betwee strict office will be notified II COMPLETION, produce of the second of | completion and eventual pents will be met: o spudding of well; drill shall be posted on each pecified below shall be set a minimum of 20 feet into the ten the operator and the died before well is either plug action pipe shall be cement as surface casing order appud date or the well shall be are true and to the best of rator or Agent: | OWR Permit #: 4339  (Note: Apply for Permit with DWR  Will Cores be taken? If Yes, proposed zone:  FIDAVIT  lugging of this well will comply with K.S.A. 55 et. seq.  th drilling rig; If by circulating cement to the top; in all cases surface pipe the underlying formation.  Strict office on plug length and placement is necessary printing from below any usable water to surface within 120 DAY  133,891-C, which applies to the KCC District 3 area, alterning the plugged. In all cases, NOTIFY district office prior to a my knowledge and fielief.  Remember to:  Remember to:  | shall be set or to plugging; 'S of spud date. nate Il cementing ny cementing.  tory   |
| res, true vertical depth:   | affirms that the drilling, ving minimum requirement at edistrict office prior to oved notice of intent to surface pipe as solidated materials plus able, an agreement betwee strict office will be notificall COMPLETION, produce of the surface of th      | completion and eventual pents will be met: o spudding of well; dirill shall be posted on each pecified below shall be set a minimum of 20 feet into the operator and the died before well is either plugiction pipe shall be cement as surface casing order appud date or the well shall be are true and to the best of rator or Agent:         | OWR Permit #: _4339  (Note: Apply for Permit with DWR    Will Cores be taken? If Yes, proposed zone:  FIDAVIT  lugging of this well will comply with K.S.A. 55 et. seq.  th drilling rig; the production casing is cemented in; ed from below any usable water to surface within 120 DAY et 133,891-C, which applies to the KCC District 3 area, altern the plugged. In all cases, NOTIFY district office prior to a my knowledge and selief.  Remember to:  File Certification of Compliance with the Kansas Surface Act (KSONA-1) with Intent to Drill;   | shall be set or to plugging; 'S of spud date. nate Il cementing ny cementing.  tory   |
| Yes, true vertical depth:   | affirms that the drilling, ving minimum requirement ate district office prior to oved notice of intent to count of surface pipe as so the, an agreement between strict office will be notified if COMPLETION, produce of the second of the secon      | completion and eventual pents will be met: o spudding of well; drill shall be posted on each pecified below shall be set a minimum of 20 feet into the ten the operator and the died before well is either plug action pipe shall be cement as surface casing order appud date or the well shall be are true and to the best of rator or Agent: | Will Cores be taken? If Yes, proposed zone:  FIDAVIT  lugging of this well will comply with K.S.A. 55 et. seq.  ch drilling rig; It by circulating cement to the top; in all cases surface pipe in eunderlying formation.  strict office on plug length and placement is necessary pringed or production casing is cemented in; ed from below any usable water to surface within 120 DAY et. 133,891-C, which applies to the KCC District 3 area, altern the plugged. In all cases, NOTIFY district office prior to a my knowledge and fielief.  Remember to:  File Certification of Compliance with the Kansas Surface Act (KSONA-1) with Intent to Drill; File Drill Pit Application (form CDP-1) with Intent to Drill; File Completion Form ACO-1 within 120 days of spud date. File acreage attribution plat according to field proration of the completion form ACO-1 within 120 days of spud date.  | shall be set or to plugging; 'S of spud date. nate Il cementing ny cementing.  tory  c Owner Notification sate; orders;   |
| Yes, true vertical depth:   | affirms that the drilling, ving minimum requirement ate district office prior to over notice of intent to surface pipe as so olidated materials plus a olie, an agreement between strict office will be notifice. If COMPLETION, produce notice will be notifice of intention       | completion and eventual pents will be met: o spudding of well; drill shall be posted on ead pecified below shall be se a minimum of 20 feet into the end before well is either plug action pipe shall be cement asas surface casing order a pud date or the well shall be are true and to the best of rator or Agent:  feet feet per ALT.       | Will Cores be taken? If Yes, proposed zone:  FIDAVIT  lugging of this well will comply with K.S.A. 55 et. seq.  ch drilling rig; If by circulating cement to the top; in all cases surface pipe in eunderlying formation.  strict office on plug length and placement is necessary pringed or production casing is cemented in; ed from below any usable water to surface within 120 DAY et. 133,891-C, which applies to the KCC District 3 area, alterning the plugged. In all cases, NOTIFY district office prior to a my knowledge and selief.  Remember to:  - File Certification of Compliance with the Kansas Surface Act (KSONA-1) with Intent to Drill; - File Drill Pit Application (form CDP-1) with Intent to Drill; - File Completion Form ACO-1 within 120 days of spud date.  Notify appropriate district office 48 hours prior to workov   | shall be set or to plugging; 'S of spud date. nate Il cementing ny cementing.  tory  a Owner Notification sate; orders; eer or re-entry;  |
| Yes, true vertical depth:   | affirms that the drilling, ving minimum requirement ate district office prior to oved notice of intent to count of surface pipe as solidated materials plus a site, an agreement between strict office will be notified if COMPLETION, producted "B" - Eastern Karris within 30 days of the statements made herein  Signature of Operation of Signature of Operation      | completion and eventual pents will be met: o spudding of well; drill shall be posted on each pecified below shall be set a minimum of 20 feet into the entitle operator and the died before well is either plugation pipe shall be cement as surface casing order spud date or the well shall be are true and to the best of rator or Agent:    | Will Cores be taken? If Yes, proposed zone:  FIDAVIT  lugging of this well will comply with K.S.A. 55 et. seq.  ch drilling rig; If by circulating cement to the top; in all cases surface pipe to underlying formation.  strict office on plug length and placement is necessary pringed or production casing is cemented in; ed from below any usable water to surface within 120 DAY 1133,891-C, which applies to the KCC District 3 area, alten the plugged. In all cases, NOTIFY district office prior to a my knowledge and selief.  Remember to:  File Certification of Compliance with the Kansas Surface Act (KSONA-1) with Intent to Drill; File Drill Pit Application (form CDP-1) with Intent to Drill; File Completion Form ACO-1 within 120 days of spud da File acreage attribution plat according to field proration of Notify appropriate district office 48 hours prior to workow Submit plugging report (CP-4) after plugging is complete  | shall be set or to plugging; 'S of spud date. nate It cementing ny cementing.  tory  a Owner Notification site; orders; er or re-entry; ed (within 60 days);                                  |
| Yes, true vertical depth:   | affirms that the drilling, ving minimum requirement ate district office prior to oved notice of intent to do unt of surface pipe as so olidated materials plus a site, an agreement between strict office will be notified II COMPLETION, product "B" - Eastern Kard within 30 days of the statements made herein  Signature of Operation of the statement      | completion and eventual pents will be met: o spudding of well; drill shall be posted on each pecified below shall be set a minimum of 20 feet into the entitle operator and the died before well is either plugation pipe shall be cement as surface casing order spud date or the well shall be are true and to the best of rator or Agent:    | Will Cores be taken? If Yes, proposed zone:  FIDAVIT  lugging of this well will comply with K.S.A. 55 et. seq.  ch drilling rig; If by circulating cement to the top; in all cases surface pipe to underlying formation.  strict office on plug length and placement is necessary pringed or production casing is cemented in; ed from below any usable water to surface within 120 DAY 1133,891-C, which applies to the KCC District 3 area, alten the plugged. In all cases, NOTIFY district office prior to a my knowledge and selief.  Remember to:  File Certification of Compliance with the Kansas Surface Act (KSONA-1) with Intent to Drill; File Drill Pit Application (form CDP-1) with Intent to Drill; File Completion Form ACO-1 within 120 days of spud dates a complete of the properties of the plugging is complete.  Notify appropriate district office 48 hours prior to workow.  Submit plugging report (CP-4) after plugging is complete.  Obtain written approval before disposing or injecting salts. | shall be set or to plugging; 'S of spud date. nate It cementing ny cementing.  tory  e Owner Notification site; orders; er or re-entry; ed (within 60 days); t water.                         |
| Yes, true vertical depth:   | affirms that the drilling, ving minimum requirement ate district office prior to oved notice of intent to count of surface pipe as solidated materials plus a site, an agreement between strict office will be notified if COMPLETION, producted "B" - Eastern Karris within 30 days of the statements made herein  Signature of Operation of Signature of Operation      | completion and eventual pents will be met: o spudding of well; drill shall be posted on each pecified below shall be set a minimum of 20 feet into the entitle operator and the died before well is either plugation pipe shall be cement as surface casing order spud date or the well shall be are true and to the best of rator or Agent:    | Will Cores be taken? If Yes, proposed zone:  FIDAVIT  lugging of this well will comply with K.S.A. 55 et. seq.  ch drilling rig; If by circulating cement to the top; in all cases surface pipe to underlying formation.  strict office on plug length and placement is necessary pringed or production casing is cemented in; ed from below any usable water to surface within 120 DAY 1133,891-C, which applies to the KCC District 3 area, alten the plugged. In all cases, NOTIFY district office prior to a my knowledge and selief.  Remember to:  File Certification of Compliance with the Kansas Surface Act (KSONA-1) with Intent to Drill; File Drill Pit Application (form CDP-1) with Intent to Drill; File Completion Form ACO-1 within 120 days of spud da File acreage attribution plat according to field proration of Notify appropriate district office 48 hours prior to workow Submit plugging report (CP-4) after plugging is complete  | shall be set or to plugging; 'S of spud date. nate II cementing ny cementing.  tory  e Owner Notification ate; orders; eer or re-entry; ed (within 60 days); t water. orized expiration date) |

130 S. Market - Room 2078, Wichita, Kansas 67202

For KCC Use:

Effective Date:

| For KCC Use ONLY | 1 |
|------------------|---|
| API # 15         |   |

#### IN ALL CASES PLOT THE INTENDED WELL ON THE PLAT BELOW


In all cases, please fully complete this side of the form. Include items 1 through 5 at the bottom of this page.

| Operator: Quinque Operating Company  | Location of Well: County: Ford   |
|--|--|
| Lease: Feikert Farms   |  |
| Well Number: 1-33  | feet from E / X W Line of Section  |
| Field: Wildcat   | Sec. <u>33 Twp. 28 S. R. 22 </u> E X W   |
| Number of Acres attributable to well: 160  QTR/QTR/QTR/QTR of acreage: SE _ NW | Is Section: Regular or Irregular   |
|  | If Section is Irregular, locate well from nearest corner boundary.  Section corner used: NE NW SE SW |

#### **PLAT**

Show location of the well. Show footage to the nearest lease or unit boundary line. Show the predicted locations of lease roads, tank batteries, pipelines and electrical lines, as required by the Kansas Surface Owner Notice Act (House Bill 2032).

You may attach a separate plat if desired.

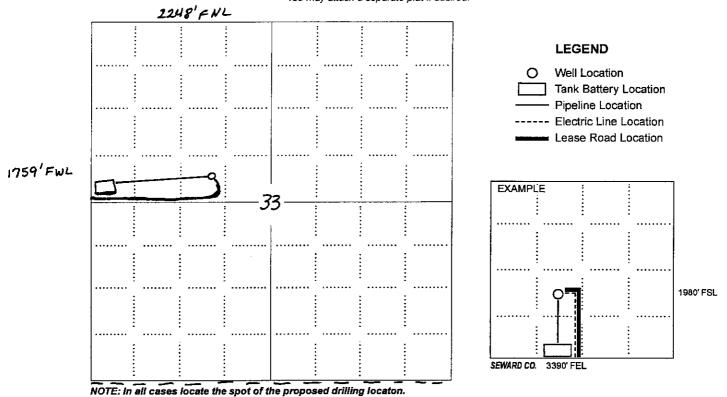

### In plotting the proposed location of the well, you must show:

- 1. The manner in which you are using the depicted plat by identifying section lines, i.e. 1 section, 1 section with 8 surrounding sections, 4 sections, etc.
- 2. The distance of the proposed drilling location from the south / north and east / west outside section lines.
- 3. The distance to the nearest lease or unit boundary line (in footage).
- 4. If proposed location is located within a prorated or spaced field a certificate of acreage attribution plat must be attached: (C0-7 for oil wells; CG-8 for gas wells).
- 5. The predicted locations of lease roads, tank batteries, pipelines, and electrical lines.

15-057-20699-00-00




**Quinque Operating** 

## Pro-Stake LLC

Oil Field & Construction Site Staking

### P.O. Box 2324

Garden City, Kansas 67846 Office/Fax: (620) 276-6159

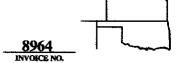

<u>c091510-r</u>

Cell: (620) 272-1499

Feikert Farms #1-33

LEASE NAME


Ford County, KS 28s COUNTY

2248' FNL - 1759' FWL LOCATION SPOT

1"=1000' SCALE: Sept. 14th, 2010 DATE STAKED: Ben R. MEASURED BY: Gabe Q DRAWN BY: David H. AUTHORIZED BY: This drawing does not constitute a monumented survey or a GR. ELEVATION: 2472.8'

Directions: From the SE side of Kingsdown, Ks at the intersection of Hwy 54 & Kingsdown-Ford RD North - Now go 2.3 miles North on Kingsdown-Ford RD - Now go 1 mile East on Wilburn RD to the SW corner of section 33-28s-22w - Now go 0.6 mile North on 126 RD to ingress stake East into - Now go approx. 1930' East through wheat stubble - Now go 322' NW through mile stubble into staked location.

Final ingress must be verified with land owner or

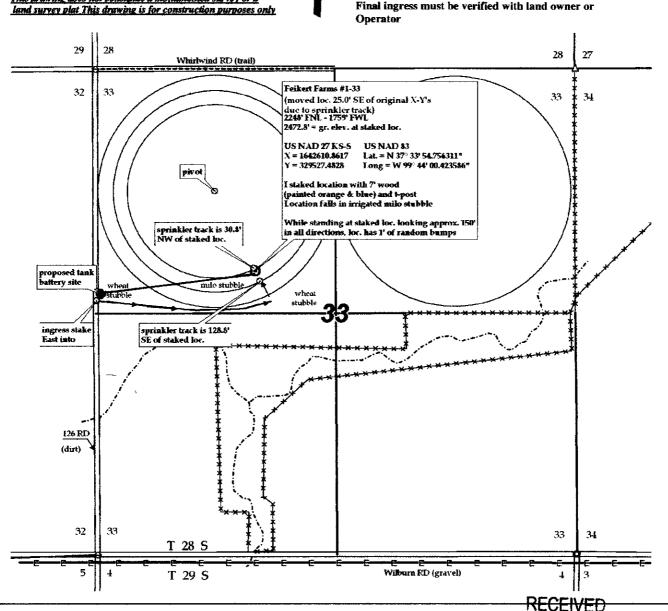

SEP 1 S 2010

**KCC WICHITA** 

## 15-057-20699-00-01



### Pro-Stake LLC

Oil Field & Construction Site Staking

P.O. Box 2324



c091510-r

Garden City, Kansas 67846 Office/Fax: (620) 276-6159 Cell: (620) 272-1499


INVOICE NO.

**Quinque Operating** Feikert Farms #1-33 OPERATOR LEASE NAME Ford County, KS 2248' FNL - 1759' FWL <u> 33</u> **28s** COUNTY LOCATION SPOT GR. FLEVATION: 2472.8' 1" =1000' SCALE: Sept. 14th, 2010 DATE STAKED:

Ben R. MEASURED BY: Gabe Q. DRAWN BY: AUTHORIZED BY: David H.

This drawing does not constitute a monumented survey or a land survey plat This drawing is for construction purposes only **Directions:** From the SE side of Kingsdown, Ks at the intersection of Hwy 54 & Kingsdown-Ford RD North - Now go 2.3 miles North on Kingsdown-Ford RD - Now go 1 mile East on Wilburn RD to the SW corner of section 33-28s-22w - Now go 0.6 mile North on 126 RD to ingress stake East into - Now go approx. 1930' East through wheat stubble - Now go 322' NW through mile stubble into staked location.

Final ingress must be verified with land owner or Operator

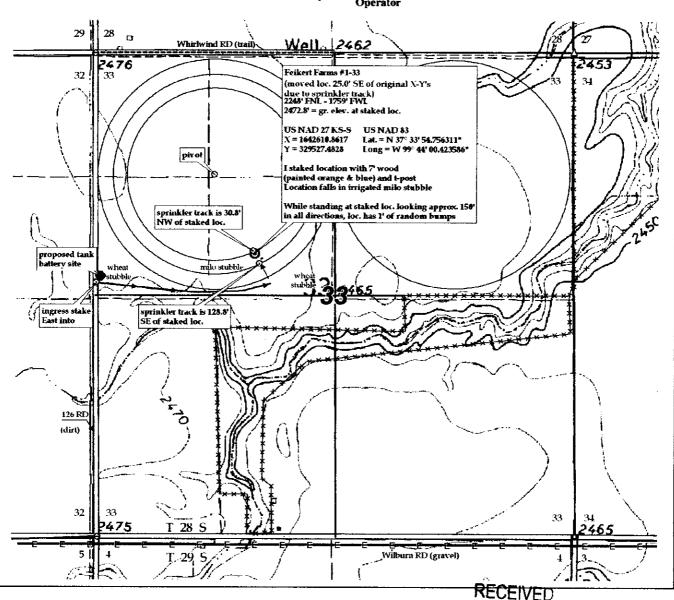

SEP 1 6 2010

**KCC WICHITA** 

# KANSAS CORPORATION COMMISSION OIL & GAS CONSERVATION DIVISION

Form CDP-1 May 2010 Form must be Typed

### **APPLICATION FOR SURFACE PIT**

Submit in Duplicate

| Operator Name: Quinque Operating Company  |                                |   | License Number: 5225   |  |
|---|--------------------------------|---|--|--|
| Operator Address: 908 N.W. 71st S   | St.                            | Oklahoma City OK 73116  |  |  |
| Contact Person: Catherine Smith   |                                |   | Phone Number: (405) 840-9876 ext. 129  |  |
| Lease Name & Well No.: Feikert Farn   | ns 1-3                         | 33  | Pit Location (QQQQ):   |  |
| Type of Pit:  |                                |   | <u>SE _ NW</u>   |  |
| Emergency Pit Burn Pit  | X Proposed Existing            |   | Sec. 33 Twp. 28 R. 22 East X West  |  |
| Settling Pit X Drilling Pit   | If Existing, date constructed: |   | 2,248 Feet from X North / South Line of Section                                |  |
| Workover Pit Haul-Off Pit   |                                |   | 1,759 Feet from East / X West Line of Section                                  |  |
| (If WP Supply API No. or Year Drilled)  | Pit capacity: 9,400            | (bbls)  | Ford County  |  |
| Is the pit located in a Sensitive Ground Water Area? Yes X No   |                                | No  | Chloride concentration: mg/l  (For Emergency Pits and Settling Pits only)      |  |
| Is the bottom below ground level?  Yes X No   | Artificial Liner?              | No  | How is the pit lined if a plastic liner is not used? Native Clay               |  |
| Pit dimensions (all but working pits):  | 25 Length (fe                  | et) 125   | Width (feet) N/A: Steel Pits   |  |
| Depth fro   | om ground level to de          | epest point:  | 5 [ No Pit   |  |
|   |                                |   | dures for periodic maintenance and determining cluding any special monitoring. |  |
| ,   |                                | Daily Inspection  |  |  |
|   |                                | Daily Inspection  |  |  |
|   |                                |   |  |  |
| Distance to nearest water well within one-mile  | of pit:                        | Depth to shallowest fresh water 180 feet.                       |  |  |
| est 2300 feet Death of water well 172 feet  |                                | Source of information:  measured well owner electric log X KDWR |  |  |
| feet Depth of water well feet  Emergency, Settling and Burn Pits ONLY:                                  |                                | Drilling, Workover and Haul-Off Pits ONLY:                      |  |  |
| Producing Formation:  |                                | Type of material utilized in drilling/workover:Native Clay      |  |  |
| Number of producing wells on lease:   |                                | Number of working pits to be utilized:                          |  |  |
| Barrels of fluid produced daily:  |                                | Abandonment procedure: Dry by evaporation                       |  |  |
| Does the slope from the tank battery allow all spilled fluids to flow into the pit?   Yes  No           |                                | Drill pits must be closed within 365 days of spud date.         |  |  |
| I hereby certify that the above statements are true and correct to the best of my knowledge and belief. |                                |   |  |  |
| 1 - 0 - 2   |                                |   |  |  |
| 9/15/2010 Catheur   |                                |   | ne Smit  |  |
| Date Signature of Applicant or Agent  |                                |   | mature or Applicant or Agent   |  |
| KCC OFFICE USE ONLY Liner Steel Pit X RFAC X RFAS   |                                |   |  |  |
| Date Received: 9-16-10 Permit Number:Perm   |                                |   |  |  |
|   |                                |   |  |  |

Mail to: KCC - Conservation Division, 130 S. Market - Room 2078, Wichita, Kansak Free IVED

SEP 1 6 2010



Mark Parkinson, Governor Thomas E. Wright, Chairman Joseph F. Harkins, Commissioner Ward Loyd, Commissioner

September 20, 2010

Quinque Operating Company 908 NW 71<sup>st</sup> St Oklahoma City, OK 73116

RE: Drilling Pit Application

Feikert Farms Lease Well No. 1-33

NW/4 Sec. 33-28S-22W Ford County, Kansas

Dear Sir or Madam:

District staff has inspected the above referenced location and has determined that the reserve pit shall be constructed <u>without slots</u>, the bottom shall be flat and reasonably level and the free fluids must be removed. The fluids are to be removed from the reserve pit as soon as the Hutchinson Salt section has been drilled through and displacement of the fluids into the reserve pit has occurred. The fluids should be removed again after drilling operations have ceased.

If production casing is set all completion fluids shall be removed from the working pits daily. NO completion fluids or non-exempt wastes shall be placed in the reserve pit.

The fluids should be taken to an authorized disposal well. Please call the District Office at (620) 225-8888 when the fluids have been removed. Please file form CDP-5 (August 2004), Exploration and Production Waste Transfer, within 30 days of fluid removal. Conservation division forms are available through our office and on the KCC web site: www.kcc.state.ks.us/conservation/forms.

A copy of this letter should be posted in the doghouse along with the approved Intent to Drill.

If you have any questions or concerns please feel free to contact the undersigned at the above address.

Sincerely,

Kathy Haynès

Department of Environmental Protection and Remediation

cc: File

## 15-057-20699-000

KANSAS CORPORATION COMMISSION OIL & GAS CONSERVATION DIVISION

Form KSONA-1
July 2010
Form Must Be Typed
Form must be Signed
All blanks must be Filled

# CERTIFICATION OF COMPLIANCE WITH THE KANSAS SURFACE OWNER NOTIFICATION ACT

This form must be submitted with all Forms C-1 (Notice of Intent to Drill); CB-1 (Cathodic Protection Borehole Intent); T-1 (Request for Change of Operator Transfer of Injection or Surface Pit Permit); and CP-1 (Well Plugging Application).

Any such form submitted without an accompanying Form KSONA-1 will be returned.

| 5005   |   |
|--|---|
| OPERATOR: License # 5225   | Well Location:  |
| Name: Quinque Operating Company  Address 1: 908 N.W. 71st St.  | SE NW. Sec. 33 Twp. 28 S. R. 22 East West   |
|  | Enikort Forms 1 22  |
| Address 2:OV 73116   | Lease Name: Felkert Fairtis Well #: 1-33  |
| City: Oklanoma City State: Ok Zip: 73116 +   | If filing a Form T-1 for multiple wells on a lease, enter the legal description of<br>the lease below:  |
| Address 2:  City: Oklahoma City State: OK Zip: 73116 +  Contact Person: Catherine Smith  Phone: ( 405 ) 840-9876 Fax: ( 405 ) 840-2011  Email Address: csmith@huntingtonenergy.com | — uie iease below.  |
| Phone: ( 405 ) 640-9676 Fax: ( 405 ) 640-2011  |   |
| Email Address: csmitn@nuntingtonenergy.com   | _   |
| Surface Owner Information:   |   |
| Name: Larry Feikert  | When filing a Form T-1 involving multiple surface owners, attach an additional  |
| Name:         Larry Feikert           Address 1:         321 S. Main, Box 144           Address 2:   | sheet listing all of the information to the left for each surface owner. Surface owner information can be found in the records of the register of deeds for the   |
| Address 2:   | county, and in the real estate property tax records of the county treasurer.  |
| City: Bucklin State: KS Zip: 67834 +   | <u> </u>  |
| Select one of the following:   |   |
| owner(s) of the land upon which the subject well is or will  | ice Act (House Bill 2032), I have provided the following to the surface be located: 1) a copy of the Form C-1, Form CB-1, Form T-1, or Form orm being filed is a Form C-1 or Form CB-1, the plat(s) required by this ax, and email address. |
| KCC will be required to send this information to the surface   | ). I acknowledge that, because I have not provided this information, the ce owner(s). To mitigate the additional cost of the KCC performing this dling fee, payable to the KCC, which is enclosed with this form.                           |
| If choosing the second option, submit payment of the \$30.00 hand form and the associated Form C-1, Form CB-1, Form T-1, or Form   | dling fee with this form. If the fee is not received with this form, the KSONA-1 CP-1 will be returned.   |
| I hereby certify that the statements made herein are true and corre  | ect to the best of my knowledge and belief.   |
| Date: 9/15/2010 Signature of Operator or Agent:  | there Smith Title: Regulatory   |
|  | RECEIVED  |
|  | RECEIVED SEP 1 6 2010   |

Mail to: KCC - Conservation Division, 130 S. Market - Room 2078, Wichita, Kansas 6748CC WICHITA