

WATER WELL RECORD Form WWC-5

Original Record Correction Change in Well Use

Division of Water Resources App. No.

Well ID

1 LOCATION OF WATER WELL: County: Fraction Section Number Township Number Range Number

2 WELL OWNER: Last Name: First: Street or Rural Address where well is located

3 LOCATE WELL WITH 'X' IN SECTION BOX: 4 DEPTH OF COMPLETED WELL: 5 Latitude: Longitude: Datum: Source for Latitude/Longitude:

7 WELL WATER TO BE USED AS: 1. Domestic: 5. Public Water Supply: well ID 10. Oil Field Water Supply: lease


Was a chemical/bacteriological sample submitted to KDHE? Water well disinfected?

8 TYPE OF CASING USED: STEEL JOINTS: Glued Clamped Welded Threaded Casing diameter: TYPE OF SCREEN OR PERFORATION MATERIAL:

9 GROUT MATERIAL: Neat cement Cement grout Bentonite Other Grout Intervals: Nearest source of possible contamination:

Table with columns: FROM, TO, LITHOLOGIC LOG, FROM, TO, LITHO. LOG (cont.) or PLUGGING INTERVALS

11 CONTRACTOR'S OR LANDOWNER'S CERTIFICATION: This water well was constructed, reconstructed, or plugged

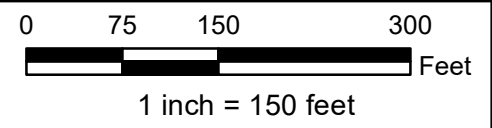

- = Approximate Site Boundary
 - = Approximate Palco Site Boundary
 - ◆ = Proposed Monitoring Well
 - ◆ = Palco Monitoring Well
 - = City Park Well
- ALL LOCATIONS AND BOUNDARIES ARE APPROXIMATE

DWG#: 1974080
 DATE: 09-23-19
 DRAWN BY: CN
 PROJ.MANGR: KW

415 Ash St.
 Wamego, Kansas
 KDHE #: C4-075-72929

PROPOSED MONITORING WELL LOCATIONS