

WATER WELL RECORD Form WWC-5

Original Record Correction Change in Well Use

Division of Water Resources App. No.

Well ID **MW08R**

1 LOCATION OF WATER WELL:
 County: Wyandotte Fraction 1/4 NW 1/4 SW 1/4 SW 1/4 Section Number 27 Township Number T 10 S Range Number R 25 E W W

2 WELL OWNER: Last Name Cibrik First Jerome Street or Rural Address where well is located (if unknown, distance and direction from nearest town or intersection): If at owner's address, check here:
 Business Union Carbide Corporation Address 3126 Brikerhoff Road
 Address PO Box 8361 City: South Charleston State: WV ZIP 25303 Kansas City, KS. 66115

3 LOCATE WELL WITH "X" IN SECTION BOX:
 N

 W SW SE E
 S
 1 mile

4 DEPTH OF COMPLETED WELL: 30 ft.
 Depth(s) Groundwater Encountered: 1) 15 ft. 2) ft. 3) ft. or 4) Dry Well
 WELL'S STATIC WATER LEVEL: ft.
 below land surface, measured on (mo-day-yr).....
 above land surface, measured on (mo-day-yr).....
 Pump test data: Well water was ft. after hours pumping gpm
 Well water was ft. after hours pumping gpm
 Estimated Yield: gpm
 Bore Hole Diameter: 10 in. to 2 ft. and 6 in. to 70 ft.

5 Latitude: 39.145308 (decimal degrees)
Longitude: -94.671123 (decimal degrees)
 Horizontal Datum: WGS 84 NAD 83 NAD 27
 Source for Latitude/Longitude:
 GPS (unit make/model:) (WAAS enabled? Yes No)
 Land Survey Topographic Map
 Online Mapper:
6 Elevation: 745 ft. Ground Level TOC
 Source: Land Survey GPS Topographic Map
 Other PILOT SITE SURVEY

7 WELL WATER TO BE USED AS:
 1. Domestic: Household Lawn & Garden Livestock Irrigation Feedlot Industrial
 2. Public Water Supply: well ID
 3. Dewatering: how many wells?
 4. Aquifer Recharge: well ID
 5. Monitoring: well ID MW-08R
 6. Environmental Remediation: well ID
 Air Sparge Soil Vapor Extraction Recovery Injection
 7. Oil Field Water Supply: lease
 8. Test Hole: well ID
 Cased Uncased Geotechnical
 9. Geothermal: how many bores?
 a) Closed Loop Horizontal Vertical
 b) Open Loop Surface Discharge Inj. of Water
 10. Other (specify):


Was a chemical/bacteriological sample submitted to KDHE? Yes No If yes, date sample was submitted:
 Water well disinfected? Yes No

8 TYPE OF CASING USED: Steel PVC Other CASING JOINTS: Glued Clamped Welded Threaded
 Casing diameter 2 in. to 20 ft., Diameter in. to ft., Diameter in. to ft.
 Casing height above land surface 0 in. Weight 70 lbs./ft. Wall thickness or gauge No. Sch. 40
TYPE OF SCREEN OR PERFORATION MATERIAL:
 Steel Stainless Steel Fiberglass PVC Other (Specify)
 Brass Galvanized Steel Concrete tile None used (open hole)
SCREEN OR PERFORATION OPENINGS ARE:
 Continuous Slot Mill Slot Gauze Wrapped Torch Cut Drilled Holes Other (Specify)
 Louvered Shutter Key Punched Wire Wrapped Saw Cut None (Open Hole)
SCREEN-PERFORATED INTERVALS: From 20 ft. to 30 ft. From ft. to ft. From ft. to ft.
GRAVEL PACK INTERVALS: From 18 ft. to 30 ft. From ft. to ft. From ft. to ft.

9 GROUT MATERIAL: Neat cement Cement grout Bentonite Other
 Grout Intervals: From 15 ft. to 2 ft., From ft. to ft., From ft. to ft.
Nearest source of possible contamination:
 Septic Tank Lateral Lines Pit Privy Livestock Pens Insecticide Storage
 Sewer Lines Cess Pool Sewage Lagoon Fuel Storage Abandoned Water Well
 Watertight Sewer Lines Seepage Pit Feedyard Fertilizer Storage Oil Well/Gas Well
 Other (Specify)
 Direction from well? Distance from well? ft.

10 FROM	TO	LITHOLOGIC LOG	FROM	TO	LITHO. LOG (cont.) or PLUGGING INTERVALS
0	30	Blind Drilled			

11 CONTRACTOR'S OR LANDOWNER'S CERTIFICATION: This water well was constructed, reconstructed, or plugged under my jurisdiction and was completed on (mo-day-year) 8-22-2016 and this record is true to the best of my knowledge and belief.
 Kansas Water Well Contractor's License No. 577 This Water Well Record was completed on (mo-day-year) 8-22-2016 under the business name of Cascade Drilling Signature [Signature]

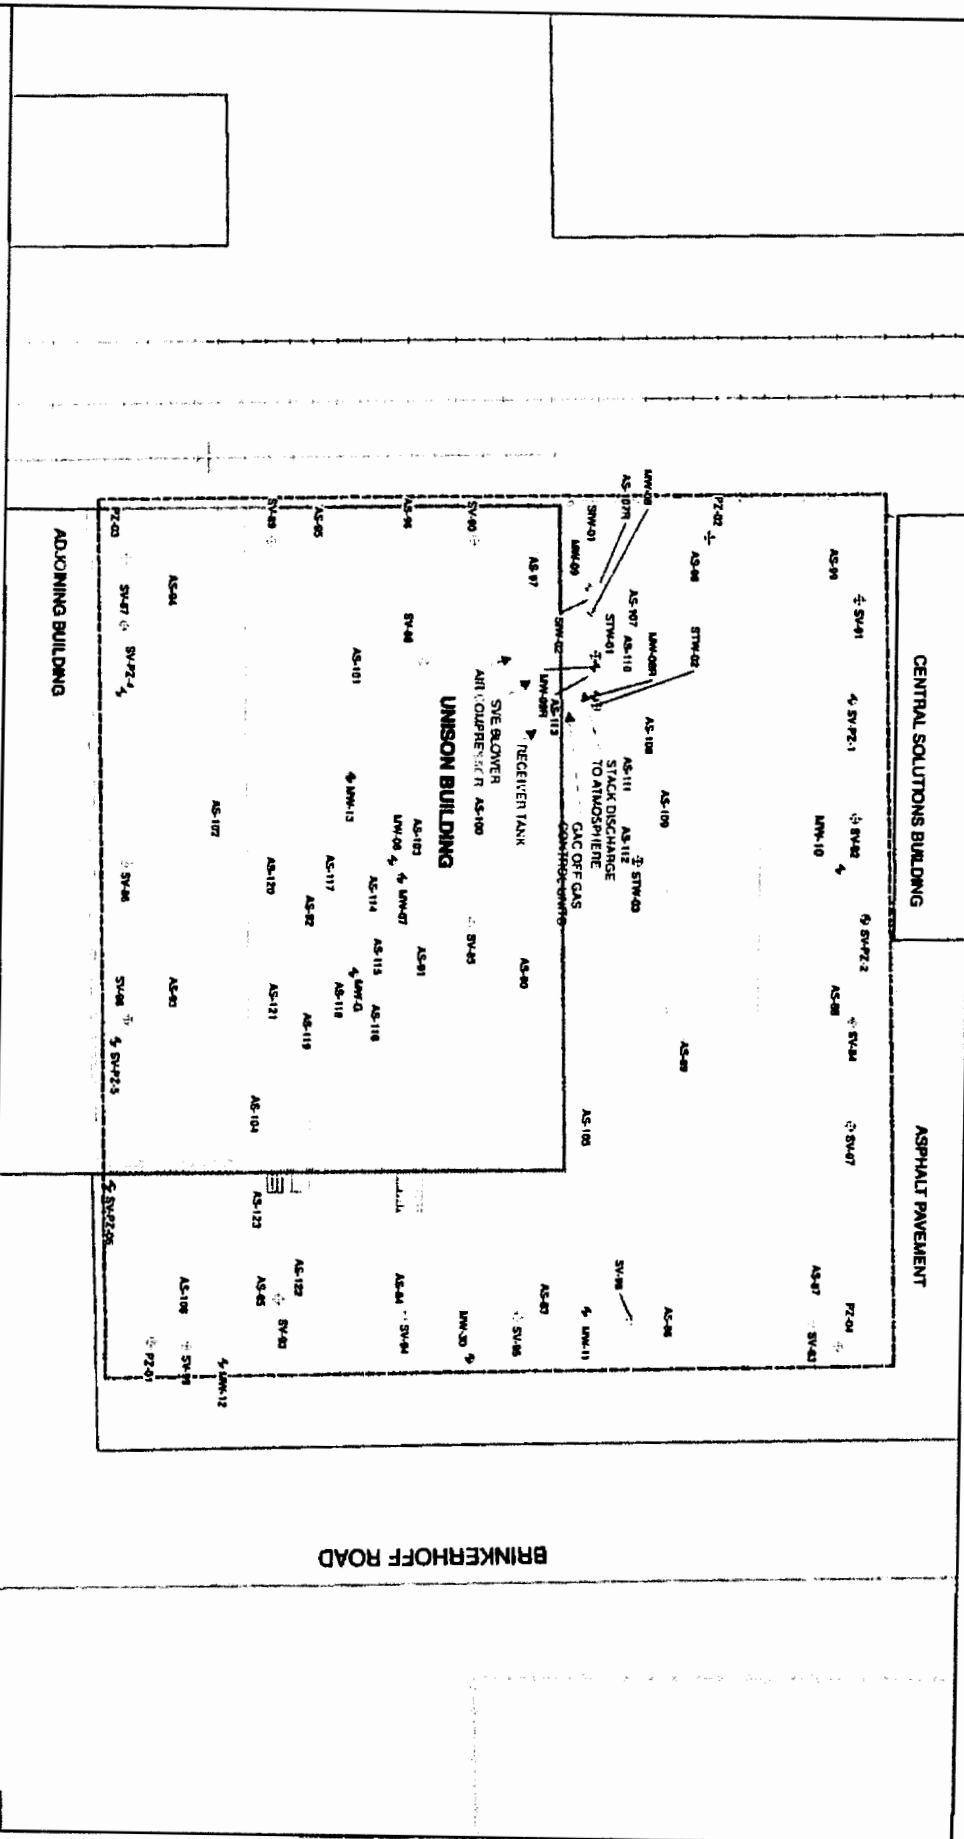

- Legend**
- Abandoned Monitoring Well Location
 - Air Sparging Well Location
 - Monitoring Well Location
 - Piezometer
 - SoyGold Test Well
 - SVE Well Locations
 - SVE Piezometer
 - Site Limits
- Fence

