
WATER WELL R		WWC-5		sion of Water		MW110	
Original Record  1 LOCATION OF W		ge in Well Use Fraction		urces App. No.		Well ID Range Number	
County: Wyandott	ne ¼ se ¼ ne ¼						
2 WELL OWNER: Last Name: First: Street or Rural Address where well is located (if unknown, distance and							
Business: Union Carbide Corporation   direction from nearest town or intersection): If at owner's address, check here:							
Address: 2001 Union Carbide Drive Bidg 2000 Address: 3150 Chysler RD							
City: South Charleston State: WV ZIP: 25303							
3 LOCATE WELL	4 DEPTH OF COM	MPLETED WELL:	95.1 n	5 Latitud	39,14559	94(decimal degrees)	
WITH "X" IN SECTION BOX:	Depth(s) Groundwater Encountered: 1)14' ft.				Longitude: 94.612797 (decimal degrees)		
N N	2) ft. 3) ft., or 4) 🗌 Dry Well					4 □ NAD 83 □ NAD 27	
	WELL'S STATIC WATER LEVEL:				Source for Latitude/Longitude:  GPS (unit make/model:apple lphone)		
NW NE	above land surface, measured on (mo-day-yr)			■ GPS	(WAAS enabled?  Yes No)		
	Pump test data: Well water was ft.			☐ Land Survey ☐ Topographic Map			
W E	after hours pumping gpm			Online Mapper:			
SW SE	Well water was						
						☐ Ground Level ☐ TOC	
S    mile	Bore Hole Diameter:			Source: ☐ Land Survey ☐ GPS ☐ Topographic Map ☐ Other			
7 WELL WATER TO BE USED AS:							
1. Domestic:		ater Supply: well ID		10. □ Oil F	ield Water Supply: Je	ease	
☐ Household	6. 🔲 Dewaterii	ng: how many wells?		11. Test Ho	le: well ID	***************************************	
Lawn & Garden	7. 🔲 Aquifer R 8. 🔣 Monitorir	110	☐ Cased ☐ Uncased ☐ Geotechnical				
☐ Livestock 2. ☐ Irrigation	8. Monitorir	1.10	12. Geothermal: how many bores?				
3. Feedlot	9. Environmental Remediation: well ID  Air Sparge  Soil Vapor Extraction			a) Closed Loop ☐ Horizontal ☐ Vertical b) Open Loop ☐ Surface Discharge ☐ Inj. of Water			
4. 🔲 Industrial	Recovery	☐ Injection					
Was a chemical/bacteriological sample submitted to KDHE?  Yes No If yes, date sample was submitted:							
Water well disinfected? ☐ Yes ■ No							
8 TYPE OF CASING USED: Steel PVC Other							
Casing diameter 2 in. to 85 ft., Diameter in. to ft., Diameter in. to ft.  Casing height above land surface flush in. Weight 70 lbs./ft. Wall thickness or gauge No. Sch 40							
TYPE OF SCREEN OR PERFORATION MATERIAL:							
☐ Steel ☐ Stainless Steel ☐ Fiberglass ■ PVC ☐ Other (Specify)							
☐ Brass ☐ Galvanized Steel ☐ Concrete tile ☐ None used (open hole)							
SCREEN OR PERFORATION OPENINGS ARE:  ☐ Continuous Slot  Mill Slot  ☐ Gauze Wrapped  ☐ Torch Cut  ☐ Drilled Holes  ☐ Other (Specify)							
☐ Continuous Slot							
SCREEN-PERFORATED INTERVALS: From . 85 ft. to . 95 ft. from							
GRAVEL PACK INTERVALS: From96 ft. to95 ft. to							
9 GROUT MATERIAL: ☐ Neat cement ☐ Cement grout ■ Rentonite ■ Other bentonite grout							
Grout Intervals: From							
☐ Septic Tank ☐ Lateral Lines ☐ Pit Privy ☐ Livestock Pens ☐ Insecticide Storage							
☐ Sewer Lines ☐ Cess Pool ☐ Sewage Lagoon ☐ Fuel Storage ☐ Abandoned Water Well							
☐ Watertight Sewer Lines ☐ Seepage Pit ☐ Feedyard ☐ Fertilizer Storage ☐ Oil Well/Gas Well ☐ Other (Specify)							
Direction from well?							
10 FROM TO	LITHOLO	GIC LOG	FROM			PLUGGING INTERVALS	
0 10' b	lack clay						
10' 96' g	rey sand					7	
			<del>  </del>				
			Notes:				
11 CONTRACTOR'S OR LANDOWNER'S CERTIFICATION: This water well was constructed, reconstructed, or plugged under my jurisdiction and was completed on (mo-day-year) .7-8-2020 and this record is true to the best of my knowledge and belief.							
Kansas Water Well Contractor's License No. 597. This Water Well Record was completed on (mo-day-year) 7-8-2020.  under the business name of Cascade Drilling LLP. Signature of Cascade Drilling LLP.							
under the business name	of Cascade Drilling	LLP	Sig	nature5	teve Johnson	····	
and i write copy alor	ing with a rec of \$5.00 for car	circonstructed well to. Kails	as Department o	or Health and En	vironment, Bureau of Wi	ater, GW 15 Section,	
1000 SW Jackson St., Suite 420, Topeka, Kansas 66612-1367. Mail one to Water Well Owner and retain one for your records. Telephone 785-296-5524.  Visit us at http://www.kdheks.gov/waterwell/index.html  KSA 82a-1212  Revised 7/10/2015							
						ALVISUE HILUIAUIU	

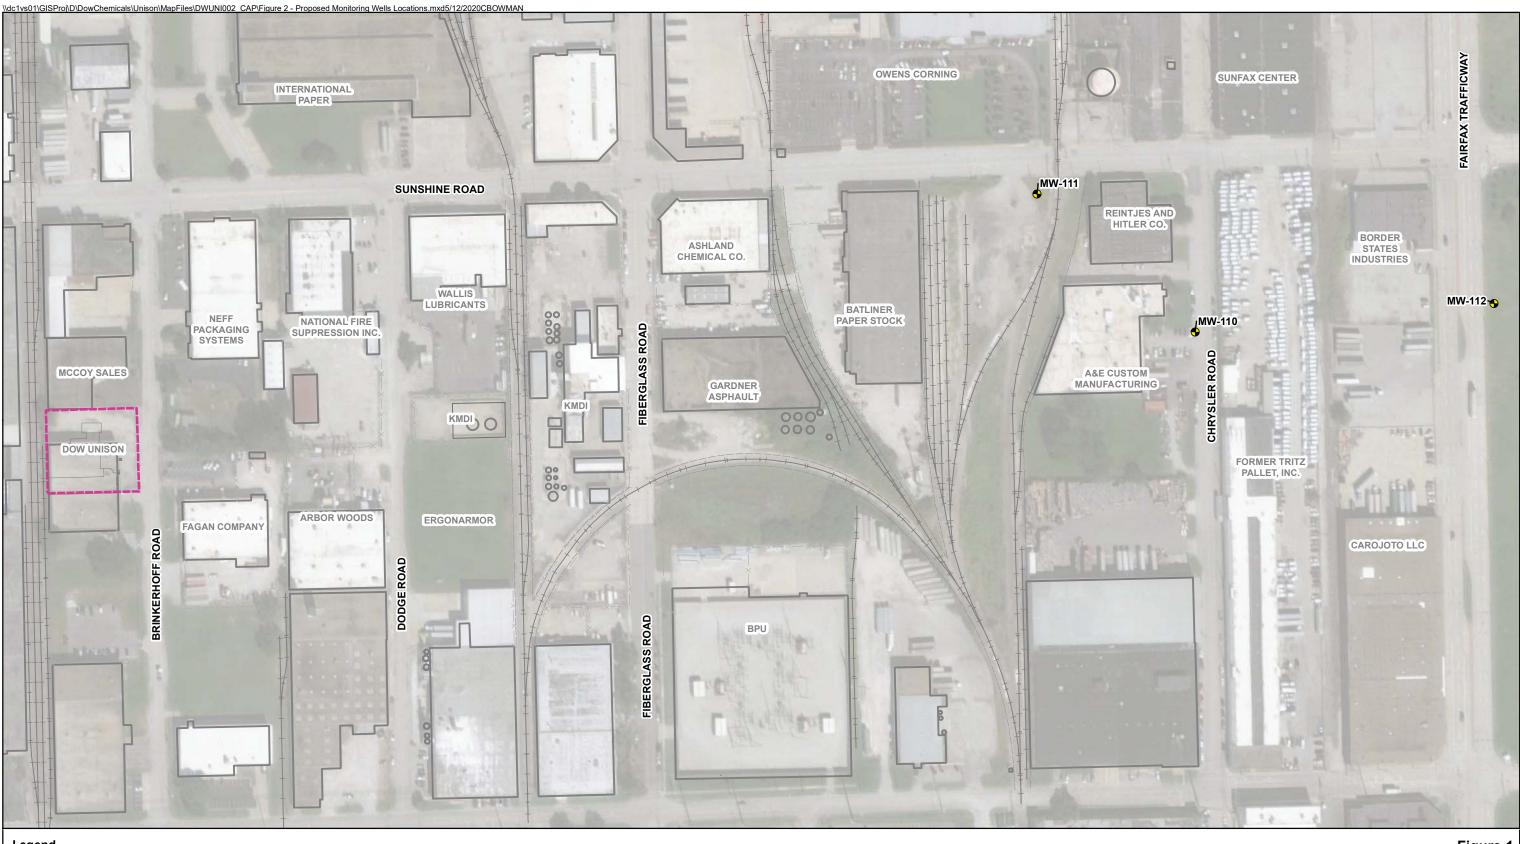

## Legend

- New Monitoring Well Location
- -- 3126 Brinkerhoff Property Limits
- Existing Railroad

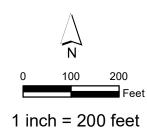


Figure 1 **Proposed Monitoring Wells Locations**Former Unison Transformer Services, Inc. Facility

Kansas City, Kansas

