
	ATER WELL RECORD Form WWC-5 Torginal Record Correction Change in Well Ust				Division of Water Resources App. No. Well ID MW				MW2		
1 LOC	LOCATION OF WATER WELL: Fraction					Section Numb	er Township Nur				
	County Wyandotte NE ¼ NE ¼ NW ¼ NW ¼ 31 T 10 S R 25 X E W 2 WELL OWNER: Last Name: First; Street or Rural Address where well is located (if unknown, distance and direction										
Business: KDHE (3801 Leavenworth Road)): If at owner's ac	ldress, check he	re:
Addre	Address:										
and the second se	City Topeka State: KS ZIP: 66612 3 LOCATE WELL 4 DEPTH OF COMPLETED WELL: 35 ft 5 Latitude: 39.14234 (decimal degrees)										
1	WITH "X" IN Depth(s) Groundwater Encountered: 1) ft Longitude 94.67343 (decimal degrees)										
	N WELL'S STATIC WATER LEVEL: 22.59 ft. Source for Latitude/Longitude:										
	X Image: Sector with the sector withe sector with the sector with the sector wit)			
	Pump test data: Well water was ft X Land Survey Topographic Map										
WE afterhours pumping gpm Online Mapper											
sw	sw sp after hours pumping gpm 6 Elevation 903.66 ft Ground Level										
Estimated Yield:gpm Bore Hole Diameter: 7.25 in to ft, and					Source X Land Survey GPS Topographic Map						
	Bore Hole Diameter: 7.25 in toft, andin toft										
7 WELI	WATER TO			W 6							
I Domestic:				: Water Supply tering: how m				11 Test Hole: we	Water Supply: leas	e	
	& Garden		· ·	er Recharge: w					Uncased	Geotechnica	ŧl
2 Irrigat		-		oring: well ID ental Remediat			1	 Geothermal: Ho a) Closed Loo 	ć		 .l
	3 Feedlot Air Sparge Soil Vapor Extractior b) Open Loop Surface Discharge Inj. of Water							Inj. of Water			
			Recov					Other (spe			
		Yes X		ted to KDHE	? Yes X	INO	lf yes, da	ite sample was su			
8 TYPE	OF CASING	USED:			Other				ed Clampled	Welded	X Threaded
	eter 2 t above land su		20 ft, 0.29 in	Diameter	ın.	το	π,	thickness or gaug	in. to	π,	
TYPE OF S		PERFORA ess Steel	_		X PVC						
Brass		nized Steel		berglass oncrete tile	None used (op	en hole		Other (Specify)			
	R PERFORA										
	uous Slot red Shutter	X Mill SI		Gauze W Wire Wra		rch Cut w Cut		ed Holes e (Open Hole)	Other (Specify	()	
1	RFORATED				to <u>35</u> ft,	From	f	. to	ft, From	ft. to	ft,
	MATERIAL:		t cement		to 35 ft, nt grout X Be	From		r Concrete: 0-1'	ft, From	ft. to	ft,
Grout interva	uls: From	<u> </u>	to <u>18</u>				ft, Fro		toft,		
Nearest sour	-	e contamiı آ		l Lines	Pit Privy			stock Pens	Insecticide	Storage	
		ľ			Sewage Lago	on		Storage		d Water Well	
	tight Sewer Lin (Specity)	es [Seepa	ge Pit	Feedyard		Ferti	lizer Storage	🔲 Oil Well /	Gas Well	
Direction from		,,,,,,,,,,,,,,,,,,,,,,,,,,,,,,,,,,,,,,	*****************	********	Distance from	well?	~40	****	ft		
10 FROM 0	TO l	Concrete	LI	THOLOGIC	CLOG	1	FROM	ТО	LITHO. LOG (co	nt.) or PLUGGIN	IG INTERVALS
1	7	Clay, silt, s	andy fill		······································						
7	<u>15</u> 20	Clay Clay, sand									
20	26	Clay									
26 27	27 35	Sand Clay									
Target of monitoring well is shallow groundwater, <20' of grout was installed at the direction of KDHE.											
11 CONTRACTOR'S OR LANDOWNER'S CERTIFICATION: This water well was X constructed, reconstructed or plugged under my											
jurisdiction License No	and was comp 5 757				3 and this record was completed on (ind belief. Kansas	Water	tractor's
4	under the business name of Larsen & Associates, Inc. Signature										
1000 SW Jackson St., Suite 420, Topeka, Kansas 66612-1367. Mail one to Water Well Owner and retain one for your records. Telephone 785-296-5524.											
Visit us	Visit us at http://www.kdheks.gov/waterwell/index.html KSA 82a-1212 Revised 7/10/2015										

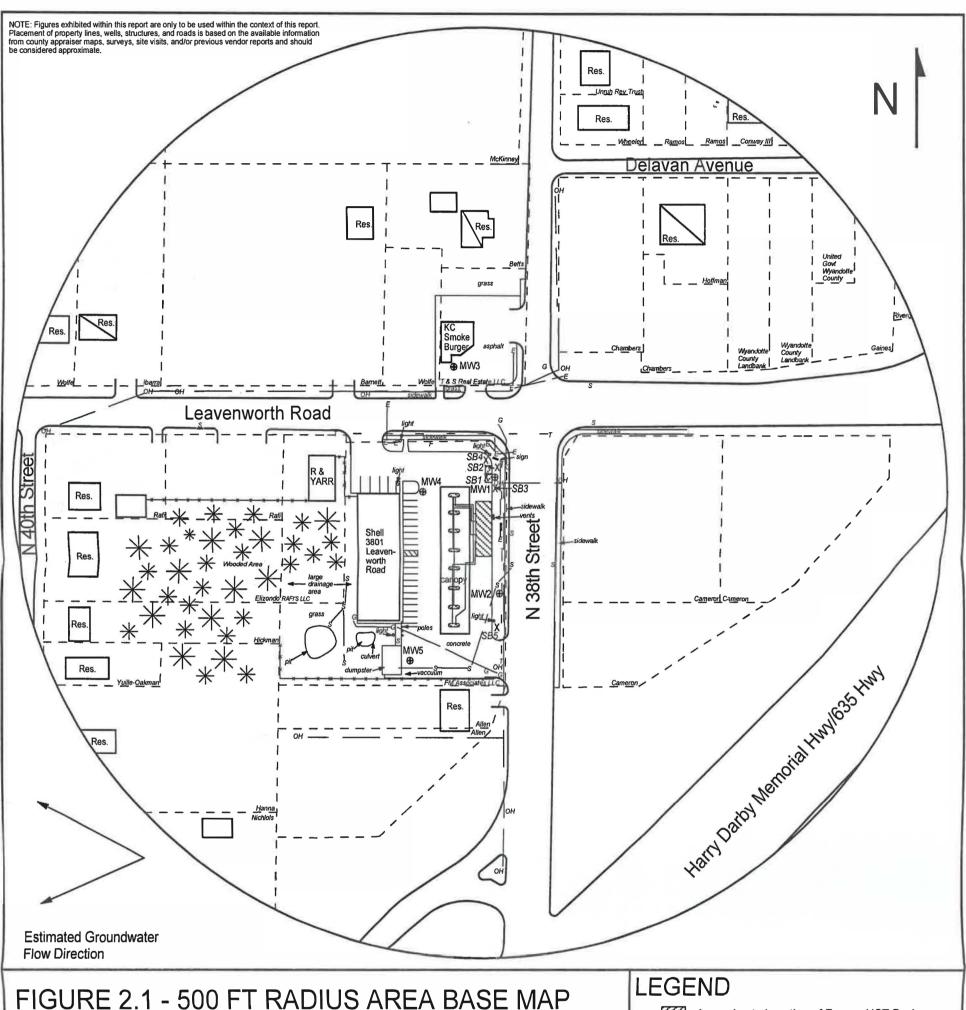

t, 10 Rge, 25E Sec. 31 & 30 Wyandoffe County & ASSOCIATES, INC.	PROJECT: 3801 Leavenworth Road 3801 Leavenworth Road Kansas City, KS KDHE ID: U4-105-15250 Date: 1/19/23	Approximate Location of Former UST Basins Approximate Location of Active UST Basin & Pump Islands Approximate Location of Property Line Approximate Location of Property Line New Monitoring Well (Installed 1/9-11/23) X Soil Boring (Drilled 1/9-11/23) F Fire Hydrant <u> Gas Lines (1.5 - 3 ft bgs)</u> <u> OH</u> Overhead Lines (25'-40' high)
1311 E 25th St., Suite B 785-841-8707 office Lawrence, KS 66046 785-865-4282 fax	0 100 ft	

DENNIS L HANDKE 1820 NW 59th Terrace TOPEKA, KANSAS 66618 785-286-4047 Home

t. 10 Rgc, 25 E Sec, 31 & 30 Wyandotte County J

January 30, 2023

Jess Chapman Larsen & Assoc. 1311 E. 25th St., Suite B Topeka, Kansas 66046

RE: Monitor Well Elevation Survey 3801 Leavenworth Road, Kansas City, Kansas Proj. 23-00B Leavenworth Road Project KDHE ID U4-105-15250

ς.

Bench M		l Sq. on NW c	orner of concrete stor		rm inlet on North side of parking lot.		
Elev.: 90		Iorth 5158.91	West 4097.37		(from SE Cor. Sec. 31-10-25E)		
MW-1	rim	903.71	North	5119.09	NE1/4,NE1/4,NW1/4,NW1/4		
	top pipe	903.29	West	4028.38	Lat = 39.14269 Long = 94.67341		
MW-2	rim	903.95	North	4993.27	NE1/4,NE1/4,NW1/4,NW1/4		
	top pipe	903.66	West	4033.53	Lat = 39.14234 Long = 94.67343		
MW-3	rim	905.47	North	5253.88	SE1/4,SE1/4,SW1/4,SW1/4 (Sec. 30-10-25E)		
	top pipe	905.10	West	4088.13	Lat = 39.14306 Long = 94.67361		
MW-4	rim	901.70	North	5119.24	NE1/4,NE1/4,NW1/4,NW1/4		
	top pipe	901.36	West	4117.94	Lat = 39.14269 Long = 94.67372		
MW-5	rim	903.38	North	4919.91	NE1/4,NE1/4,NW1/4,NW1/4		
	top pipe	903.22	West	4130.95	Lat = 39.14215 Long = 94.67378		

Lat & Long derived from Parkville 7.5' quad map. WGS84.

Elevation derived from WY 16 control point. NAVD 83.

If you have any questions, please feel free to call me. Thank you for the opportunity to be

