

WATER WELL RECORD Form WWC-5

Division of Water Resources App. No.

[]

Well ID

MW11

Original Record Correction Change in Well Use

1 LOCATION OF WATER WELL: County: Riley Fraction NW 1/4 SE 1/4 NE 1/4 NW 1/4 Section Number 17 Township Number T 10 S Range Number R 8 E W

2 WELL OWNER: Last Name: Darrah First: Chris Street or Rural Address where well is located: 473 E Poyntz, Manhattan, Kansas

3 LOCATE WELL WITH 'X' IN SECTION BOX: N W E S 1 mile. 4 DEPTH OF COMPLETED WELL: 20 ft. 5 Latitude: 39.18586 Longitude: 96.54962

7 WELL WATER TO BE USED AS: 1. Domestic: Household, Lawn & Garden, Livestock, Irrigation, Feedlot, Industrial. 5. Public Water Supply. 6. Dewatering. 7. Aquifer Recharge. 8. Monitoring: MW11. 9. Environmental Remediation. 10. Oil Field Water Supply. 11. Test Hole. 12. Geothermal. 13. Other.


Was a chemical/bacteriological sample submitted to KDHE? No. Water well disinfected? No.

8 TYPE OF CASING USED: PVC. CASING JOINTS: Threaded. Casing diameter: 2 in. to 10 ft. TYPE OF SCREEN OR PERFORATION MATERIAL: PVC. SCREEN OR PERFORATION OPENINGS ARE: Mill Slot. SCREEN-PERFORATED INTERVALS: 10 ft. to 20 ft. GRAVEL PACK INTERVALS: 8 ft. to 20 ft.

9 GROUT MATERIAL: Bentonite. Grout Intervals: 0.5 ft. to 6 ft. Nearest source of possible contamination: Fuel Storage.

Table with 6 columns: 10 FROM, TO, LITHOLOGIC LOG, FROM, TO, LITHO. LOG (cont.) or PLUGGING INTERVALS. Rows include Topsoil, Silty Clay (CL), dk brown, Grades to Sandy Clay (CH) dk brown.

11 CONTRACTOR'S OR LANDOWNER'S CERTIFICATION: This water well was constructed, reconstructed, or plugged under my jurisdiction and was completed on (mo-day-year) 7/3/17.

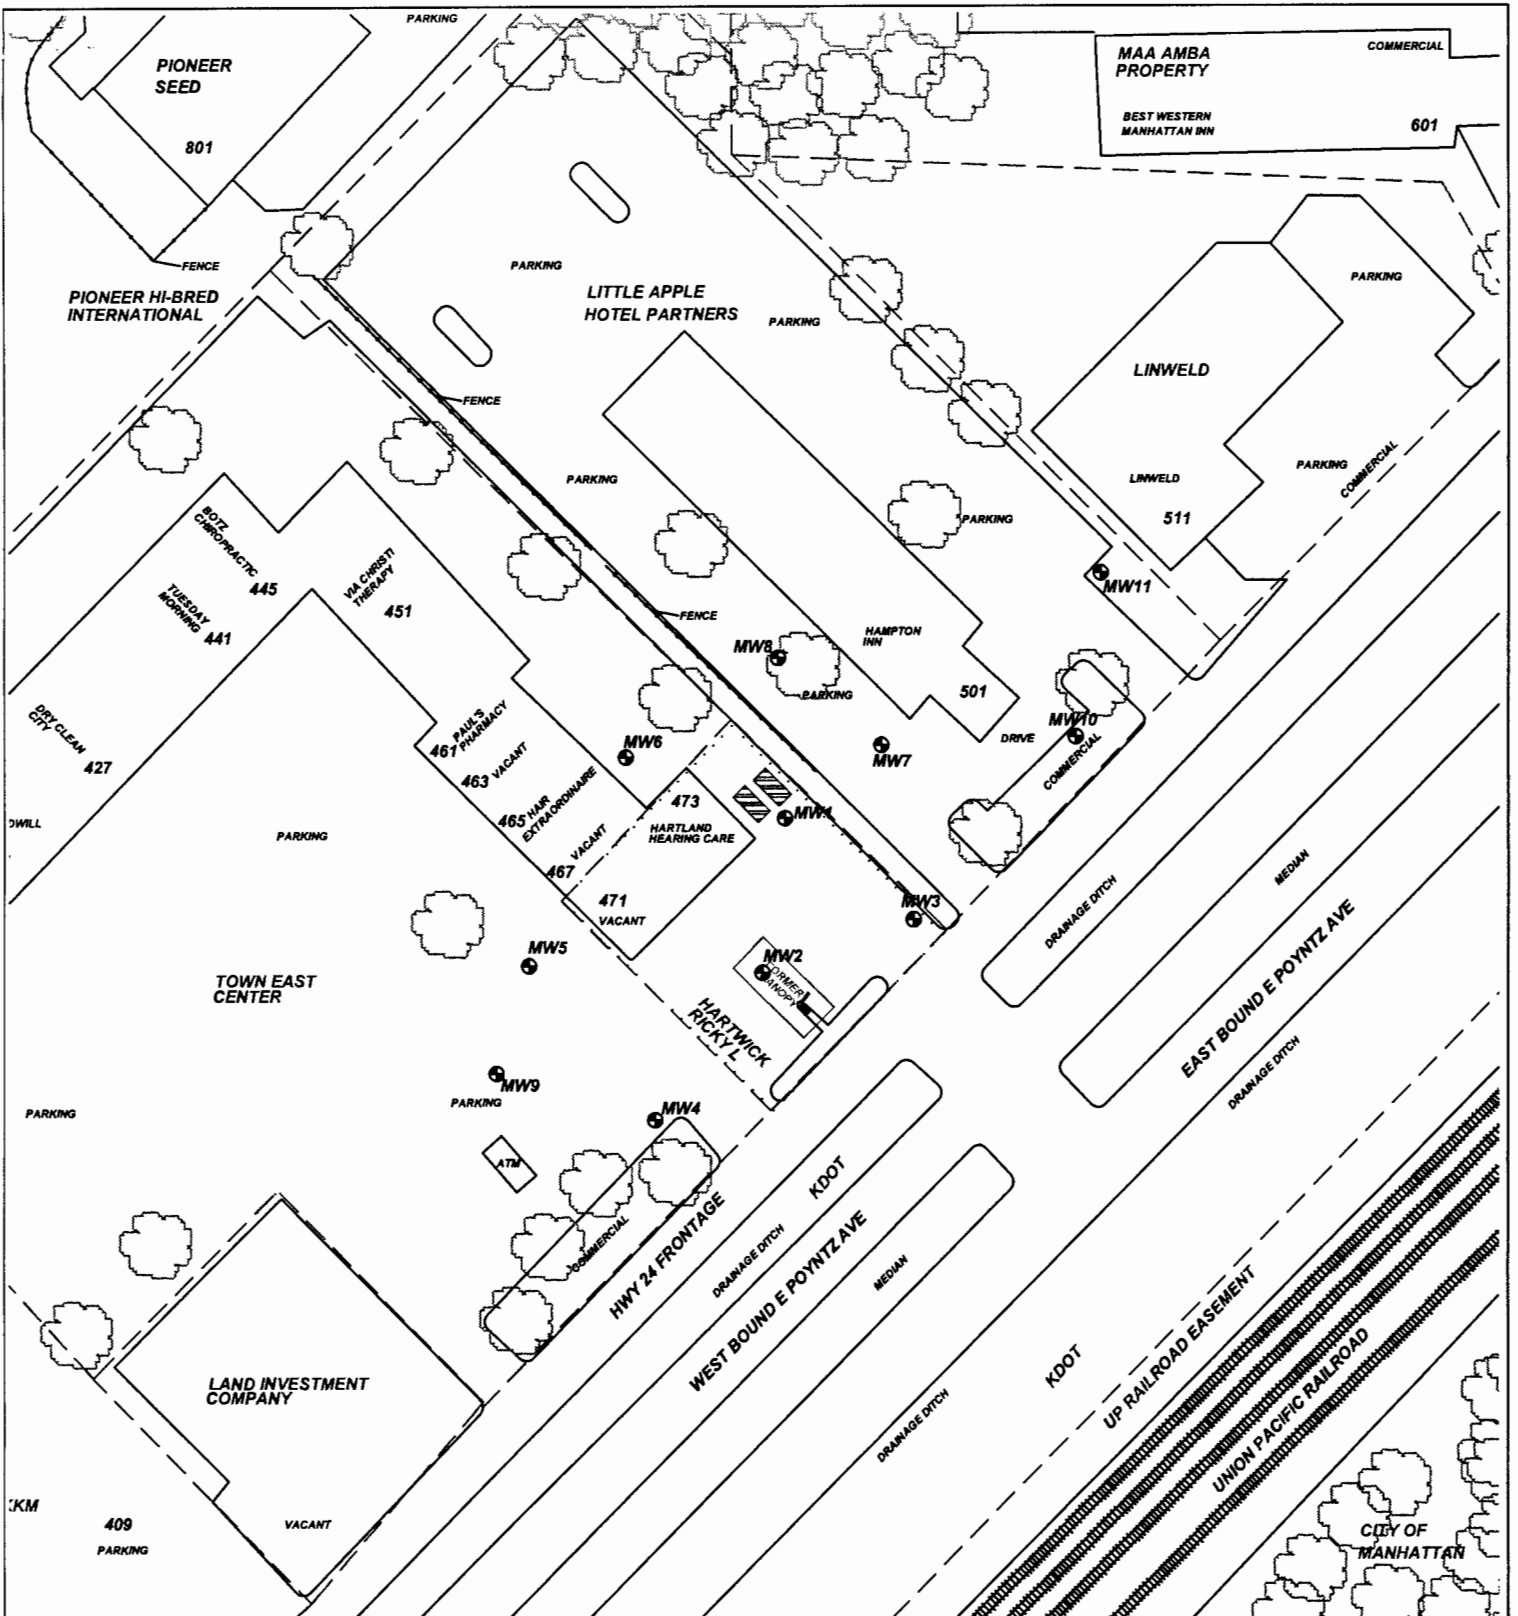

PROJECT: **DARA'S FASTLANE #3**

ADDRESS: **473 EAST POYNTZ**

LOCATION: **MANHATTAN, KS**

DRAWN BY: **B. STALNAKER** DATE: **8/15/16**

REVISED BY: **B. STALNAKER** DATE: **8/7/17**


AEI JOB #: **TF493** KOHE JOB #: **U4-075-14844**

TITLE: **FIGURE 2.1
AREA BASE MAP
350' RADIUS**

AEI ASSOCIATED ENVIRONMENTAL INC.

LEGEND:

- = (2) 10,000 G. GASOLINE USTs ABANDONED IN PLACE
- = FORMER CANOPY & PUMP ISLAND
- = MONITOR WELL
- = PARCEL BOUNDARY

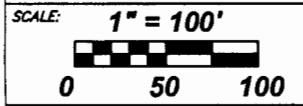

NOTES:
No basements observed within 500'.