
			WWC-5 ge in Well Use			of Water		]	MMW-85	
		OF WATER WELL:				s App. No.	T 11 27 1	Well ID		
	ounty: Riley		Fraction	1/ 0=1/		Number	Township Numl		nge Number	
			SE 1/4 SW 1/4 SW			18	T 10 S	R &	B E D W	
		CR: Last Name:	First:	Street of	r Rural A	ddress whe	ere well is located	(if unknown	, distance and	
	Business: ONE Gas, Inc.  Address: 15 Fast Fifth Street  direction from nearest town or intersection): If at owner's address, check here:									
	Address: 15 East Fifth Street Address: 515 S. 11th Street, Manhattan									
	City: Tulsa State: OK ZIP: 74103									
			ZII. 74 103							
3 LOCATE WELL WITH "X" IN 4 DEPTH OF COMPLETED WELL:29 ft. 5 Latitude:39.1756676										
	SECTION BOX: Depth(s) Groundwater Encountered: 1)									
Sie	N N	2) ft.	3) ft., or 4)	☐ Drv We	11	Horizontal	Datum: WGS 84	1 M NATA	(decimal degree	
		WELL'S STATIC WA	TER LEVEL:	ft.					83 LI NAD 2	
	below land surface, measured on (mo-day-					yr)				
NV	V NE		measured on (mo-da	y-yr)	Gr 5 (unit make/model					
1 1 1	Pump test data: Well water was					····· (WAAS enabled? ☐ Yes No)  ■ Land Survey ☐ Topographic Map				
w   -						☐ Online Mapper:				
1 1		Welly	ater was	ft.			wapper:	•••••		
sw	SE	after hours	pumping	gpm						
	Estimated Yield:gnm				6 Elevation: 1019.53 ft. Ground Level Too					
	S Bore Hole Diameter:8 in. to29				ft. and Source: Land Survey GPS				nographic Man	
	-1 mile		ft.	Other						
7 WEL	L WATER	TO BE USED AS:	221 00 111111111	10.						
1. Domes			er Supply: well ID		10	C Official	1W . C 1 .			
Hou		6 Dewatering	r how many well 112	***************************************	10.	Tost Hale	d Water Supply: lea	ise		
_					11. Test Hole: well ID					
	☐ Lawn & Garden ☐ Livestock  7. ☐ Aquifer Recharge: well ID				Cased Uncased Geotechnical					
	2. ☐ Irrigation 9. Environmental Remediation: well ID									
3. Feedlot Air Sparge Soil Vapor Ex					y and a secondar and a secondar					
4. Indu		☐ Recovery	Extraction	b) Open Loop    Surface Discharge    Inj. of Water 13.  Other (specify):						
			☐ Injection		13.	Utner (s	pecify):	• • • • • • • • • • • • • • • • • • • •		
Was a chemical/bacteriological sample submitted to KDHE?   Yes No If yes, date sample was submitted:										
Water well disinfected?  Yes No										
8 TYPE OF CASING USED: ☐ Steel ■ PVC ☐ Other										
Casing diameter										
Casing height above land surface										
TYPE OF SCREEN OR PERFORATION MATERIAL:										
☐ Steel ☐ Stainless Steel ☐ Fiberglass ■ PVC ☐ Other (Specify)										
☐ Brass ☐ Galvanized Steel ☐ Concrete tile ☐ None used (open hole)										
SCREEN OR PERFORATION OPENINGS ARE:										
□ Louvered Shutter □ Key Punched □ Wire Wrapped □ Saw Cut □ None (Open Hole)										
SCREEN-PERFORATED INTERVALS: From .19										
GRAVEL PACK INTERVALS: From 15 ft. to 29 ft., From ft. to ft., From ft. to ft.  9 GROUT MATERIAL: Neat cement   Cement grout  Bentonite Other Concrete										
9 GROU	I MATER	IAL: Neat cement C	ement grout 🔳 Bei	ntonite 📓	Other .CO	oncrete				
Grout Inter	vals: From	0 ft. to 3 f	t., From3 1	ft. to15	ft., Fı	rom	ft. to	ft.		
Nearest sou	arce of possi	ble contamination:								
☐ Septic		Lateral Lines	Pit Privy		] Livestocl		☐ Insecticide	Storage		
☐ Sewer		☐ Cess Pool	☐ Sewage Lag		Fuel Stor		☐ Abandone		11	
☐ Wateri	ight Sewer I	ines	☐ Feedyard		Fertilizer	r Storage	Oil Well/C	as Well		
Other	(Specify) .fc	rmer manufactured gas s	iite	•••				**		
Direction fro	om well?		. Distance from we	11?			ft.			
10 FROM	ТО	LITHOLOGIC	CLOG	FROM	ТО	LITHO	. LOG (cont.) or PL	UGGING IN	VITERVALS	
0	12.5	Sand, vf, some silt								
12.5	15	Clay, some silt, tr. sand								
15	26	Sand, f, some silt				-				
26	28	Sand, m-c								
28	29			-						
	25	Silt, tr. sand								
				Notes:						
11 CONTRACTOR'S OR LANDOWNER'S CERTIFICATION: This water well was constructed, reconstructed, or plugged										
unuti my jurisdiction and was completed on (mo-day-year) //2//201/ and this record is true to the best of my knowledge on the life										
Kansas water Well Contractor's License No. 24/ This Water Well Record was completed on (mo_day_year) 8/25/2017										
maer me ot	isiness nam	e of Geogore inc		Sic	mature	II.	4 111.11.1			
Iviali 1	write copy an	ong with a fee of \$5.00 for each cor	istructed well to: Kansa	s Department	of Health a	nd Environme	ent Bureau of Water	GWTS Section	n	
1000	SW Jackson S	t., Suite 420, Topeka, Kansas 6661	2-1367. Mail one to Wa	ter Well Own	er and retain	n one for vou	r records Telephone 7	25-206-5524	,	
Visit us at http:	//www.kdheks	gov/waterwell/index.html	K	SA 82a-12	12			evised 7/10		
							1/	- ADDES // IL	"-VIV	

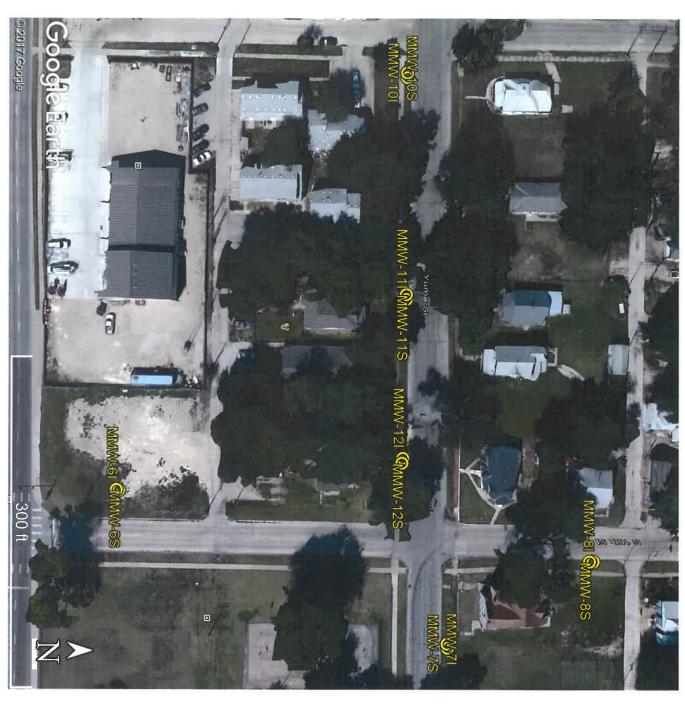

ONE Gas – Manhattan MGP Site (for Burns and McDonell) 515 S. 11<sup>th</sup> Street, Manhattan, Kansas

**GPS Coordinates:** 

MMW-7I: MMW-61: 39.1744943, -96.5719465 39.1753152, -96.5714534

MMW-101: 39.1752158, -96.5732630 MMW-111: 39.1752132, -96.5725527 MMW-121: 39.1752053, -96.5720468 MMW-8I: 39.1756761, -96.5717184

MMW-12S: 39.1752030, -96.5720320 MMW-11S: 39.1752134, -96.5725679 MMW-10S: 39.1752155, -96.5732778

RECEIVED

OCT 16 2017

BUREAU OF WATER

MMW-6S: MMW-7S:

MMW-8S:

39.1756676, -96.5717183 39.1745002, -96.5719436 39.1753162, -96.5714398