
		RECORD Correction		WWC-5 ge in Well Use		ivision of Wat sources App.]			Well ID	MMW-12S		
		WATER WE	and the second se	Fraction		ection Numb		Township Numb		ge Number		
	ty: Riley	4 SE 1/4										
2 WELL OWNER: Last Name: First: Street or Rural Address where well is located (if unknown, distance and												
	s: ONE G				direction fron	direction from nearest town or intersection): If at owner's address, check here:						
Address Address		515 S. 11t	515 S. 11th Street, Manhattan									
City:												
3 LOCATE WELL 4 DEPTH OF COMPLETED WELL:												
WITH			ft. Longitude:									
	SECTION BOX: N Depth(s) Groundwater Encountered: 1) 2)											
	N			TER LEVEL:				Latitude/Longitude:				
				measured on (mo-day	•			nit make/model:)		
NW -	NW NE Dump tost data. Wall water was									o)		
	Pump test data: Well water was after					Land Survey Topographic Map						
W	Well water was ft.						Online Mapper:					
SW -	SE	. gpm			1010 61							
	Estimated Yield:					6 Elevation: 1019.61 ft. Ground Level TOC						
	S Bore Hole Diameter:8 in. to29					Source: Land Survey GPS Topographic Map						
1 mile												
1. Domestic				ter Supply: well ID			il Field	l Water Sunnly- le	95 6			
	omestic:5. □ Public Water Supply: well ID] Household6. □ Dewatering: how many wells?						10. Oil Field Water Supply: lease 11. Test Hole: well ID					
	Lawn & Garden 7. Aquifer Recharge: well ID						Cased Uncased Geotechnical					
	Livestock 8. Monitoring: well ID MMW						hermal	: how many bores	?			
	☐ Irrigation 9. Environmental Remediation: well ID							.oop 🔲 Horizonta				
	3. 🗌 Feedlot 🔅 🗋 Air Sparge 🔅 Soil Vapor Extra						b) Open Loop 🗌 Surface Discharge 📋 Inj. of Water					
4. Industrial Recovery Injection 13. Other (specify):												
Was a chemical/bacteriological sample submitted to KDHE? Yes No If yes, date sample was submitted:												
Water well disinfected? □ Yes ■ No 8 TYPE OF CASING USED: □ Steel ■ PVC □ Other □ Casing JOINTS: □ Glued □ Clamped □ Welded ■ Threaded												
8 TYPE OF CASING USED: Steel PVC Other CASING JOINTS: Glued Clamped Welded Intreaded Casing diameter												
Casing height above land surface												
TYPE OF SCREEN OR PERFORATION MATERIAL:												
□ Steel □ Stainless Steel □ Fiberglass ■ PVC □ Other (Specify)												
□ Brass □ Galvanized Steel □ Concrete tile □ None used (open hole)												
SCREEN OR PERFORATION OPENINGS ARE:												
□ Continuous Slot ■ Mill Slot □ Gauze Wrapped □ Torch Cut □ Drilled Holes □ Other (Specify) □ Louvered Shutter □ Key Punched □ Wire Wrapped □ Saw Cut □ None (Open Hole)												
SCREEN-PERFORATED INTERVALS: From												
GRAVEL PACK INTERVALS: From												
9 GROUT MATERIAL: One to cement Cement grout Bentonite Other Concrete												
Grout Intervals: From												
Nearest source of possible contamination:												
Septic Tank Lateral Lines Pit Privy Livestock Pens Insecticide Storage Sewer Lines Cess Pool Sewage Lagoon Fuel Storage Abandoned Water Well												
	ight Sewer L		Seepage Pit	☐ Feedyard		Fertilizer Storage				en		
Other (Specify) former manufactured gas site												
Direction fro	om well?			Distance from w	ell?							
10 FROM	TO	the second s	ITHOLOG	IC LOG	FROM	TO	LITHO	D. LOG (cont.) or I	PLUGGING	INTERVALS		
0	11.5	Sand, f, some										
11.5	13 27	Clay, some silt Sand, f, tr. to some silt						·				
13 27	29	Sand, n, u. to Sand, m, son			+							
<u> </u>	23	Gand, III, Son	ne Sat									
					Notes:							
11 CONTRACTOR'S OR LANDOWNER'S CERTIFICATION: This water well was constructed, reconstructed, or plugged under my jurisdiction and was completed on (mo-day-year) .7/27/2017 and this record is true to the best of my knowledge and belief.												
Kansas Was	irisdiction a	ntractor's Lice	nse No 52	-day-year) .7/2//20 7 This Wa	ter Well Rec	unis record is	o urue t	to the best of my	r 8/25/20	and belief.		
under the b	usiness nam	e of GeoCor	e.inc		Sig	anature	Sa	h hel				
Mail 1	white copy al	ong with a fee of \$	5.00 for each	constructed well to: Kan	sas Department	of Health and E	Environi	ment, Bureau of Wate	r, GWTS Sec	tion,		
1000 SW Jackson St., Suite 420, Topeka, Kansas 66612-1367. Mail one to Water Well Owner and retain one for your records. Telephone 785-296-5524.												
Visit us at http://www.kdheks.gov/waterwell/index.html KSA 82a-1212 Revised 7/10/2015												

Riley

18-10-8E

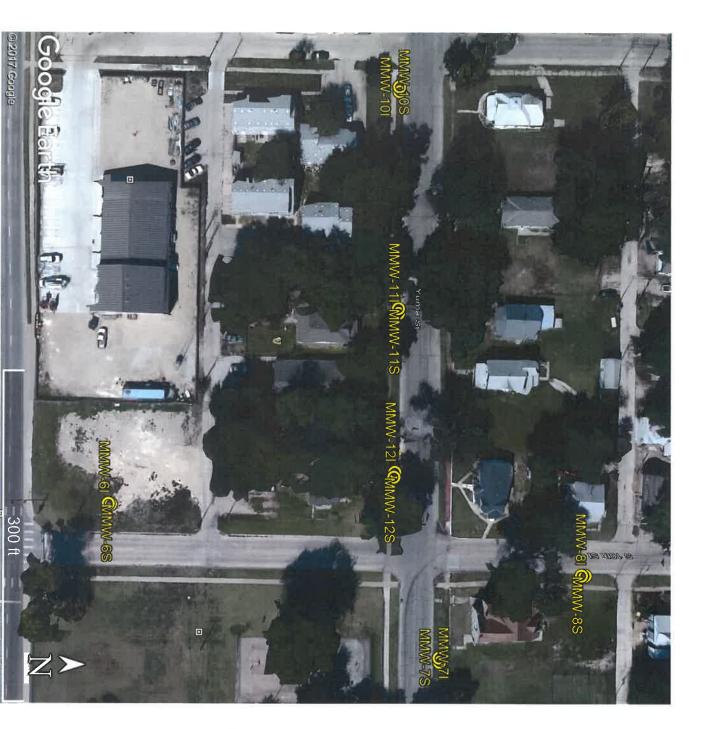

ONE Gas – Manhattan MGP Site (for Burns and McDonell) 515 S. 11th Street, Manhattan, Kansas

GPS Coordinates:

MMW-6I: 39.1744943, -96.5719465 MMW-7I: 39.1753152, -96.5714534 MMW-8I: 39.1756761, -96.5717184 MMW-10I: 39.1752158, -96.5732630 MMW-11I: 39.1752132, -96.5725527 MMW-12I: 39.1752053, -96.5720468

MMW-6S: 39.1745002, -96.5719436 MMW-7S: 39.1753162, -96.5714398 MMW-8S: 39.1756676, -96.5717183 MMW-10S: 39.1752155, -96.5732778 MMW-11S: 39.1752134, -96.5725679 MMW-12S: 39.1752030, -96.5720320

BUREAU OF WATER

OCT 16 2017

RECEIVED