

WATER WELL RECORD Form WWC-5

Division of Water Resources App. No.

Well ID

MW9

Original Record Correction Change in Well Use

1 LOCATION OF WATER WELL: County: RILEY Fraction NW 1/4 SE 1/4 SE 1/4 SW 1/4 Section Number 6 Township Number T 10 S Range Number R 8 E W

2 WELL OWNER: Last Name: Business: LEISZLER REAL ESTATE LLC Address: 2010 N. TUTTLE CREEK BLVD City: MANHATTAN State: KS ZIP: 67005 Street or Rural Address where well is located

3 LOCATE WELL WITH 'X' IN SECTION BOX: [Diagram] 4 DEPTH OF COMPLETED WELL: 20 ft. 5 Latitude: 39.20513 Longitude: 96.56815

7 WELL WATER TO BE USED AS: 1. Domestic: 2. Irrigation 3. Feedlot 4. Industrial 5. Public Water Supply 6. Dewatering 7. Aquifer Recharge 8. Monitoring MW9 9. Environmental Remediation 10. Oil Field Water Supply 11. Test Hole 12. Geothermal 13. Other


Was a chemical/bacteriological sample submitted to KDHE? Water well disinfected?

8 TYPE OF CASING USED: 2 in. to 20 ft. CASING JOINTS: Threaded TYPE OF SCREEN OR PERFORATION MATERIAL: PVC SCREEN OR PERFORATION OPENINGS ARE: Mill Slot SCREEN-PERFORATED INTERVALS: 10 ft. to 20 ft. GRAVEL PACK INTERVALS: 8 ft. to 20 ft.

9 GROUT MATERIAL: Neat cement Cement grout Bentonite Other Concrete Surface Completion 0-1 Grout Intervals: 1 ft. to 6 ft. Nearest source of possible contamination: Northwest 120 ft.

Table with columns: FROM, TO, LITHOLOGIC LOG, FROM, TO, LITHO. LOG (cont.) or PLUGGING INTERVALS. Rows: 0-.5 CONCRETE, .5-20 SILTY CLAY. Includes Notes: U5-081-15128

11 CONTRACTOR'S OR LANDOWNER'S CERTIFICATION: This water well was constructed, reconstructed, or plugged under my jurisdiction and was completed on (mo-day-year) 11/21/19 and this record is true to the best of my knowledge and belief.

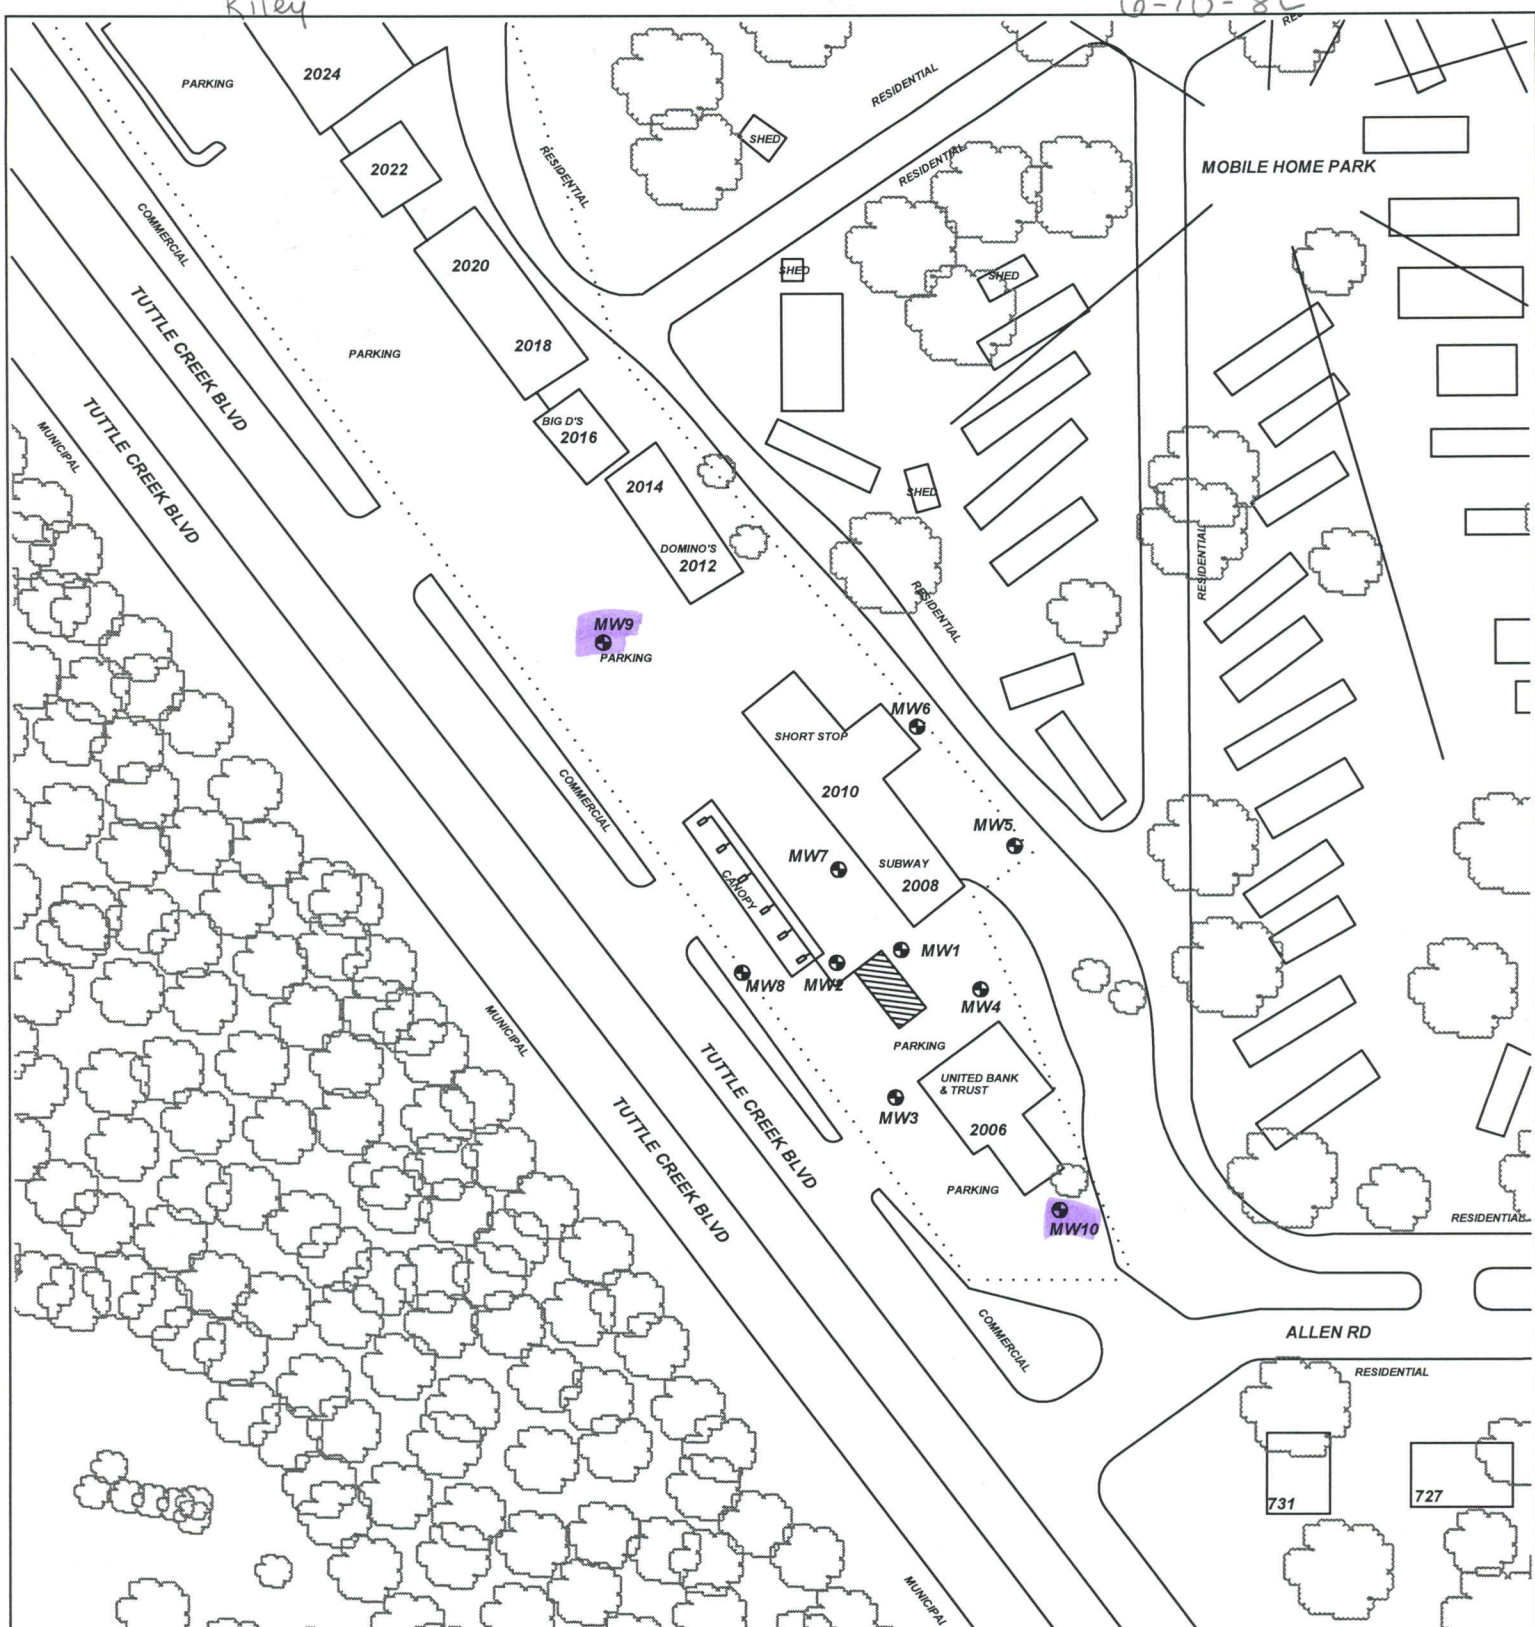

PROJECT: SHORT STOP #12

ADDRESS: 2010 N TUTTLE CREEK BLVD

LOCATION: MANHATTAN, KS

DRAWN BY: B. STALNAKER **DATE:** 2/27/19

REVISED BY: B. STALNAKER **DATE:** 11/21/19

AEI JOB #: TF518 **KDHE JOB #:** U5-081-15128

TITLE: FIGURE 2.1
AREA BASE MAP
350' RADIUS

ASSOCIATED ENVIRONMENTAL INC.

LEGEND:

- = EXISTING BASIN, PRODUCT LINES AND PUMP ISLANDS
- = MONITORING WELL
- = SUBJECT PROPERTY

SCALE: 1" = 100'

NOTES:
No basements observed within 500'.