

WATER WELL RECORD Form WWC-5


Division of Water Resources App. No. _____

Well ID **MW-9**

Original Record Correction Change in Well Use

1 LOCATION OF WATER WELL: County: Riley	Fraction SE 1/4 SW 1/4 SW 1/4 NW 1/4	Section Number 20	Township Number T 10 S	Range Number R 8 <input checked="" type="checkbox"/> E <input type="checkbox"/> W
---	---	----------------------	---------------------------	--

2 WELL OWNER: Last Name: First: Business: Tri-Lakes District Address: PO Box 1568 Address: City: Manhattan State: KS ZIP: 66505	Street or Rural Address where well is located (if unknown, distance and direction from nearest town or intersection): If at owner's address, check here: <input type="checkbox"/> 481 McDowell Creek Road, Manhattan, KS
--	---

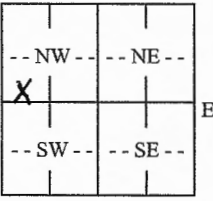3 LOCATE WELL WITH "X" IN SECTION BOX: N  S -----1 mile-----	4 DEPTH OF COMPLETED WELL:15..... ft. Depth(s) Groundwater Encountered: 1) ft. 2) ft. 3) ft., or 4) <input type="checkbox"/> Dry Well WELL'S STATIC WATER LEVEL: ft. <input type="checkbox"/> below land surface, measured on (mo-day-yr)..... <input type="checkbox"/> above land surface, measured on (mo-day-yr)..... Pump test data: Well water was ft. after..... hours pumping gpm Well water was ft. after..... hours pumping gpm Estimated Yield: gpm Bore Hole Diameter: ..8.75... in. to ..15... ft. and in. to ft.	5 Latitude:39.16676.....(decimal degrees) Longitude:-96.55503.....(decimal degrees) Horizontal Datum: <input checked="" type="checkbox"/> WGS 84 <input type="checkbox"/> NAD 83 <input type="checkbox"/> NAD 27 Source for Latitude/Longitude: <input type="checkbox"/> GPS (unit make/model:) (WAAS enabled? <input type="checkbox"/> Yes <input type="checkbox"/> No) <input checked="" type="checkbox"/> Land Survey <input type="checkbox"/> Topographic Map <input type="checkbox"/> Online Mapper:
	6 Elevation: ..1010.55...ft. <input checked="" type="checkbox"/> Ground Level <input type="checkbox"/> TOC Source: <input checked="" type="checkbox"/> Land Survey <input type="checkbox"/> GPS <input type="checkbox"/> Topographic Map <input type="checkbox"/> Other	

7 WELL WATER TO BE USED AS:

1. Domestic: <input type="checkbox"/> Household <input type="checkbox"/> Lawn & Garden <input type="checkbox"/> Livestock	2. <input type="checkbox"/> Irrigation	3. <input type="checkbox"/> Feedlot	4. <input type="checkbox"/> Industrial	5. <input type="checkbox"/> Public Water Supply: well ID	6. <input type="checkbox"/> Dewatering: how many wells?	7. <input type="checkbox"/> Aquifer Recharge: well ID	8. <input checked="" type="checkbox"/> Monitoring: well ID MW-9	9. Environmental Remediation: well ID	10. <input type="checkbox"/> Oil Field Water Supply: lease	11. Test Hole: well ID	12. Geothermal: how many bores?	13. <input type="checkbox"/> Other (specify):
--	--	-------------------------------------	--	--	---	---	--	---	--	------------------------------	---------------------------------------	---

Was a chemical/bacteriological sample submitted to KDHE? Yes No If yes, date sample was submitted:

Water well disinfected? Yes No

8 TYPE OF CASING USED: Steel PVC Other CASING JOINTS: Glued Clamped Welded Threaded
Casing diameter2..... in. to15..... ft., Diameter in. to ft., Diameter in. to ft.
Casing height above land surface0..... in. Weight lbs./ft. Wall thickness or gauge No. **sch 40**

TYPE OF SCREEN OR PERFORATION MATERIAL:
 Steel Stainless Steel Fiberglass PVC Other (Specify)

Brass Galvanized Steel Concrete tile None used (open hole)

SCREEN OR PERFORATION OPENINGS ARE:
 Continuous Slot Mill Slot Gauze Wrapped Torch Cut Drilled Holes Other (Specify)

Louvered Shutter Key Punched Wire Wrapped Saw Cut None (Open Hole)

SCREEN-PERFORATED INTERVALS: From .5..... ft. to 15..... ft., From ft. to ft., From ft. to ft.

GRAVEL PACK INTERVALS: From3..... ft. to15..... ft., From ft. to ft., From ft. to ft.

9 GROUT MATERIAL: Neat cement Cement grout Bentonite Other cement pad

Grout Intervals: From1..... ft. to3..... ft., From .0..... ft. to1..... ft., From ft. to ft.

Nearest source of possible contamination:
 Septic Tank Lateral Lines Pit Privy Livestock Pens Insecticide Storage
 Sewer Lines Cess Pool Sewage Lagoon Fuel Storage Abandoned Water Well
 Watertight Sewer Lines Seepage Pit Feedyard Fertilizer Storage Oil Well/Gas Well
 Other (Specify) **contaminated site**

Direction from well? Distance from well? ft.

10 FROM	TO	LITHOLOGIC LOG	FROM	TO	LITHO. LOG (cont.) or PLUGGING INTERVALS
0	1	Asphalt, Gravel			
1	5	Clay, dark brown, damp			
5	9	Clay, dark brown, moist, gravel			
9	11.5	Clay, dark to light gray, moist, silty			
11.5	15	Sand, gray brown, very fine, moist			

Notes:

11 CONTRACTOR'S OR LANDOWNER'S CERTIFICATION: This water well was constructed, reconstructed, or plugged under my jurisdiction and was completed on (mo-day-year) **3/31/21** and this record is true to the best of my knowledge and belief. Kansas Water Well Contractor's License No. **604** This Water Well Record was completed on (mo-day-year) **5/13/21** under the business name of **Environmental Priority Service, Inc.** Signature *[Signature]*

DENNIS L HANDKE

1820 NW 59th Terrace
TOPEKA, KANSAS 66618
785-286-4047 Home

Jamie Murphy
ppB Enviro-Solutions
112 SW 6th Ave, Suite 201
Topeka, Kansas, 66603

April 25, 2021

RE: Monitor Well Elevation Survey
481 McDowell Creek Road, Manhattan, Kansas

Proj. 21-00L
Capitol City Oil, Inc
A5-081-40502

Bench Mark: Chisled Square on South center of garage floor near the NE corner of property.


Elev: 1011.49 North 2717.02 West 4431.52 (from SE Cor. Sec. 20-10-8E)

MW-1	rim	1011.81	North	2622.68	SW1/4,SE1/4,SW1/4,NW1/4
	top pipe	1011.49	West	4488.33	Lat= 39.16680 Long = 96.55441
MW-2	rim	1012.13	North	2537.15	NW1/4,NE1/4,NW1/4,SW1/4
	top pipe	1011.53	West	4508.56	Lat= 39.16656 Long = 96.55449
MW-3	rim	1011.62	North	2585.08	NW1/4,NE1/4,NW1/4,SW1/4
	top pipe	1011.27	West	4550.60	Lat= 39.16670 Long = 96.55463
MW-4	rim	1011.27	North	2623.99	SW1/4,SE1/4,SW1/4,NW1/4
	top pipe	1010.57	West	4575.63	Lat= 39.16680 Long = 96.55472
MW-5	rim	1011.67	North	2612.10	SW1/4,SE1/4,SW1/4,NW1/4
	top pipe	1010.84	West	4457.21	Lat= 39.16677 Long = 96.55431
MW-6	rim	1012.29	North	2553.69	NW1/4,NE1/4,NW1/4,SW1/4
	top pipe	1011.81	West	4441.73	Lat= 39.16661 Long = 96.55425
MW-7	rim	1011.85	North	2695.77	SW1/4,SE1/4,SW1/4,NW1/4
	top pipe	1011.22	West	4463.49	Lat= 39.16700 Long = 96.55433
MW-8	rim	1010.81	North	2643.24	SW1/4,SE1/4,SE1/4,NW1/4
	top pipe	1010.22	West	4612.00	Lat= 39.16686 Long = 96.55485
MW-9	rim	1010.55	North	2609.16	SE1/4,SW1/4,SW1/4,NW1/4
	top pipe	1009.80	West	4661.84	Lat= 39.16676 Long = 96.55503
MW-10	rim	1012.10	North	2533.93	NW1/4,NE1/4,NW1/4,SW1/4
	top pipe	1011.54	West	4541.79	Lat= 39.16656 Long = 96.55460

Lat & Long derived from Manhatta 7.5' quad map. WGS84

Elevation established from NGS BM FF 115. NAVD 88

If you have any questions, please feel free to call me. Thank you for the opportunity to be of service to you.

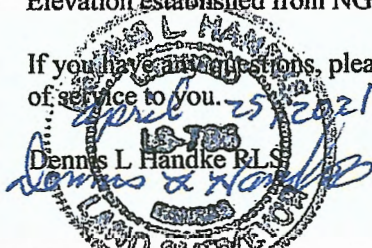


RECEIVED

MAY 14 2021

BUREAU OF WATER

Capital City Oil Property Boundary	Current Building	Overhead Electric	Agricultural	Other
Monitoring Well	Former Product Lines	Communication	Commercial	Residential
Soil Boring	Former Pump Islands	Sewer	Exempt	Utilities
Geotechnical Boring	Former Tank Area	Water	Farm Homesite	Vacant
			Not for Profit	

Notes:
 1) Groundwater flow direction unknown, but inferred towards the west based on topography and regional drainage
 2) All known utilities visible during the site visit are shown. Figures will be updated following the public and private utility locates conducted during the LSA.

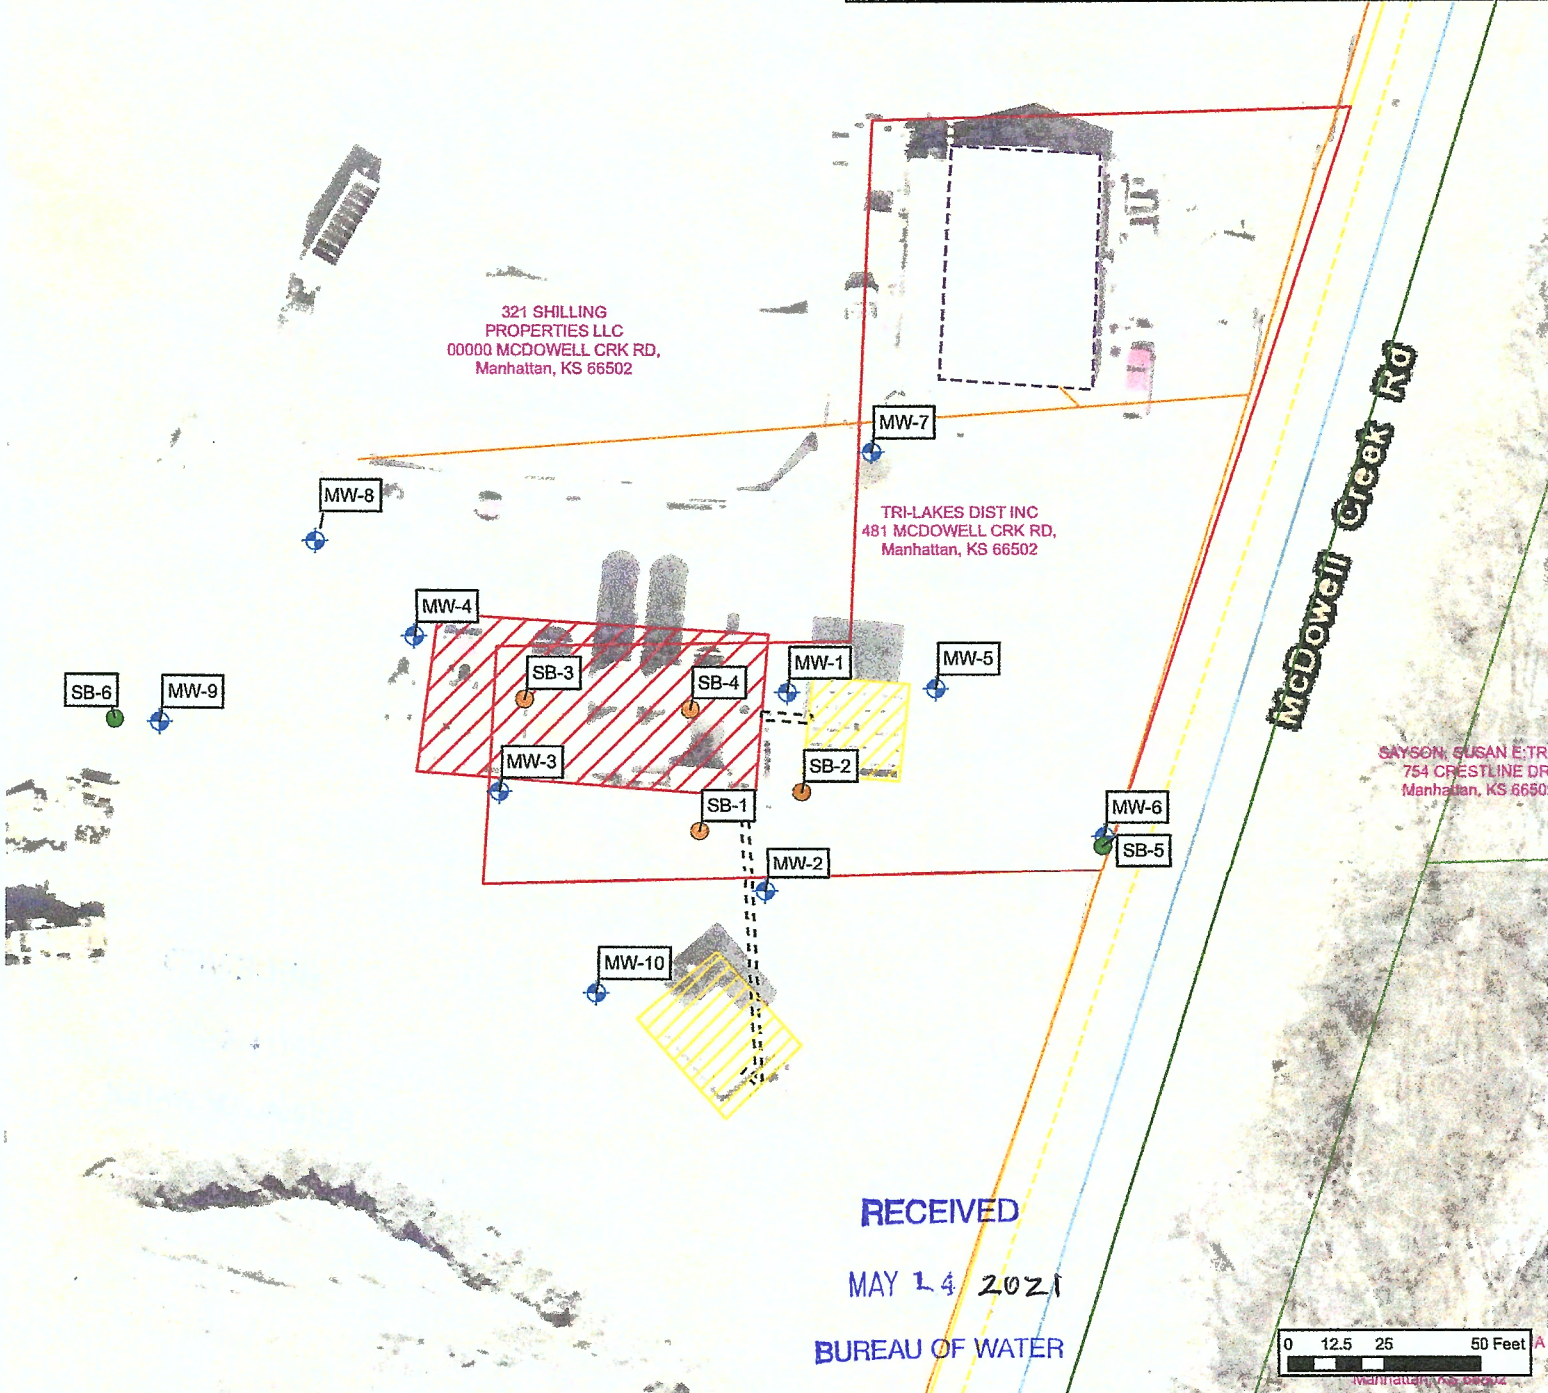

RECEIVED
 MAY 14 2021
 BUREAU OF WATER

DESIGNED BY:	CP
DRAWN BY:	CP
CHECKED BY:	JM
APPROVED BY:	CC
DATE:	FEBRUARY 2021



Site Map
Capital City Oil, Inc.

481 McDowell Creek Rd.
Manhattan, Kansas
A5-081-40502

FIGURE
2

Limited Site
Assessment
Work Plan