

WATER WELL RECORD Form WWC-5

Division of Water Resources App. No.

Well ID MW-2

Original Record Correction Change in Well Use

1 LOCATION OF WATER WELL: County: Riley	Fraction NE ¼ NW ¼ NW ¼ SW ¼	Section Number 17	Township Number T 10 S	Range Number R 8 <input checked="" type="checkbox"/> E <input type="checkbox"/> W
---	---------------------------------	----------------------	---------------------------	--

2 WELL OWNER: Last Name: First: Street or Rural Address where well is located (if unknown, distance and direction from nearest town or intersection): If at owner's address, check here: <input type="checkbox"/> Business: Kuhn Velma L Trust Address: 4755 Adair Ave N Address: City: Crystal State: NM ZIP: 55429 215 E. Poyntz Ave
--

3 LOCATE WELL WITH "X" IN SECTION BOX: N <table style="width: 100%; text-align: center; border-collapse: collapse;"> <tr> <td style="border: 1px solid black; padding: 5px;">NW</td> <td style="border: 1px solid black; padding: 5px;">NE</td> </tr> <tr> <td style="border: 1px solid black; padding: 5px;">SW</td> <td style="border: 1px solid black; padding: 5px;">SE</td> </tr> </table> W <input checked="" type="checkbox"/> E S 1 mile	NW	NE	SW	SE	4 DEPTH OF COMPLETED WELL: 20 ft. Depth(s) Groundwater Encountered: 1) ft. 2) ft. 3) ft., or 4) <input type="checkbox"/> Dry Well WELL'S STATIC WATER LEVEL: 16.55 ft. <input checked="" type="checkbox"/> below land surface, measured on (mo-day-yr) 7-1-2021. <input type="checkbox"/> above land surface, measured on (mo-day-yr) Pump test data: Well water was ft. after hours pumping gpm Well water was ft. after hours pumping gpm Estimated Yield: gpm Bore Hole Diameter: 8.75 in. to 20 ft. and in. to ft.	5 Latitude: 39.18145 (decimal degrees) Longitude: 96.55574 (decimal degrees) Horizontal Datum: <input checked="" type="checkbox"/> WGS 84 <input type="checkbox"/> NAD 83 <input type="checkbox"/> NAD 27 Source for Latitude/Longitude: <input type="checkbox"/> GPS (unit make/model:) (WAAS enabled? <input type="checkbox"/> Yes <input type="checkbox"/> No) <input checked="" type="checkbox"/> Land Survey <input type="checkbox"/> Topographic Map <input type="checkbox"/> Online Mapper:
NW	NE					
SW	SE					
6 Elevation: 1009.30 ft. <input type="checkbox"/> Ground Level <input type="checkbox"/> TOC Source: <input checked="" type="checkbox"/> Land Survey <input type="checkbox"/> GPS <input type="checkbox"/> Topographic Map <input type="checkbox"/> Other						

7 WELL WATER TO BE USED AS:

1. Domestic: <input type="checkbox"/> Household <input type="checkbox"/> Lawn & Garden <input type="checkbox"/> Livestock 2. <input type="checkbox"/> Irrigation 3. <input type="checkbox"/> Feedlot 4. <input type="checkbox"/> Industrial	5. <input type="checkbox"/> Public Water Supply: well ID 6. <input type="checkbox"/> Dewatering: how many wells? 7. <input type="checkbox"/> Aquifer Recharge: well ID 8. <input checked="" type="checkbox"/> Monitoring: well ID MW-2 9. Environmental Remediation: well ID <input type="checkbox"/> Air Sparge <input type="checkbox"/> Soil Vapor Extraction <input type="checkbox"/> Recovery <input type="checkbox"/> Injection	10. <input type="checkbox"/> Oil Field Water Supply: lease 11. Test Hole: well ID <input type="checkbox"/> Cased <input type="checkbox"/> Uncased <input type="checkbox"/> Geotechnical 12. Geothermal: how many bores? a) Closed Loop <input type="checkbox"/> Horizontal <input type="checkbox"/> Vertical b) Open Loop <input type="checkbox"/> Surface Discharge <input type="checkbox"/> Inj. of Water 13. <input type="checkbox"/> Other (specify):
---	--	---


Was a chemical/bacteriological sample submitted to KDHE? Yes No If yes, date sample was submitted:
 Water well disinfected? Yes No

8 TYPE OF CASING USED: Steel PVC Other CASING JOINTS: Glued Clamped Welded Threaded
 Casing diameter 2 in. to 10 ft., Diameter in. to ft., Diameter in. to ft.
 Casing height above land surface 0 in. Weight lbs./ft. Wall thickness or gauge No. sch 40
TYPE OF SCREEN OR PERFORATION MATERIAL:
 Steel Stainless Steel Fiberglass PVC Other (Specify)
 Brass Galvanized Steel Concrete tile None used (open hole)
SCREEN OR PERFORATION OPENINGS ARE:
 Continuous Slot Mill Slot Gauze Wrapped Torch Cut Drilled Holes Other (Specify)
 Louvered Shutter Key Punched Wire Wrapped Saw Cut None (Open Hole)
SCREEN-PERFORATED INTERVALS: From .10 ft. to 20 ft., From ft. to ft., From ft. to ft.
GRAVEL PACK INTERVALS: From 8 ft. to 20 ft., From ft. to ft., From ft. to ft.


9 GROUT MATERIAL: Neat cement Cement grout Bentonite Other cement pad
 Grout Intervals: From 1 ft. to 8 ft., From .0 ft. to 1 ft., From ft. to ft.
Nearest source of possible contamination:
 Septic Tank Lateral Lines Pit Privy Livestock Pens Insecticide Storage
 Sewer Lines Cess Pool Sewage Lagoon Fuel Storage Abandoned Water Well
 Watertight Sewer Lines Seepage Pit Feedyard Fertilizer Storage Oil Well/Gas Well
 Other (Specify) contaminated site
 Direction from well? Distance from well? ft.

10 FROM	TO	LITHOLOGIC LOG	FROM	TO	LITHO. LOG (cont.) or PLUGGING INTERVALS
0	1	asphalt			
1	5	Sandy Clay, brown, moist, with gravel			
5	8	Clay, brown, moist, plastic			
8	14	Sand, brown, fine to medium			
14	20	Clay, gray			
Notes:					

11 CONTRACTOR'S OR LANDOWNER'S CERTIFICATION: This water well was constructed, reconstructed, or plugged under my jurisdiction and was completed on (mo-day-year) 6-30-2021 and this record is true to the best of my knowledge and belief.
 Kansas Water Well Contractor's License No. 604 This Water Well Record was completed on (mo-day-year) 8/12/21
 under the business name of Environmental Priority Service, Inc. Signature P.A.M.T.

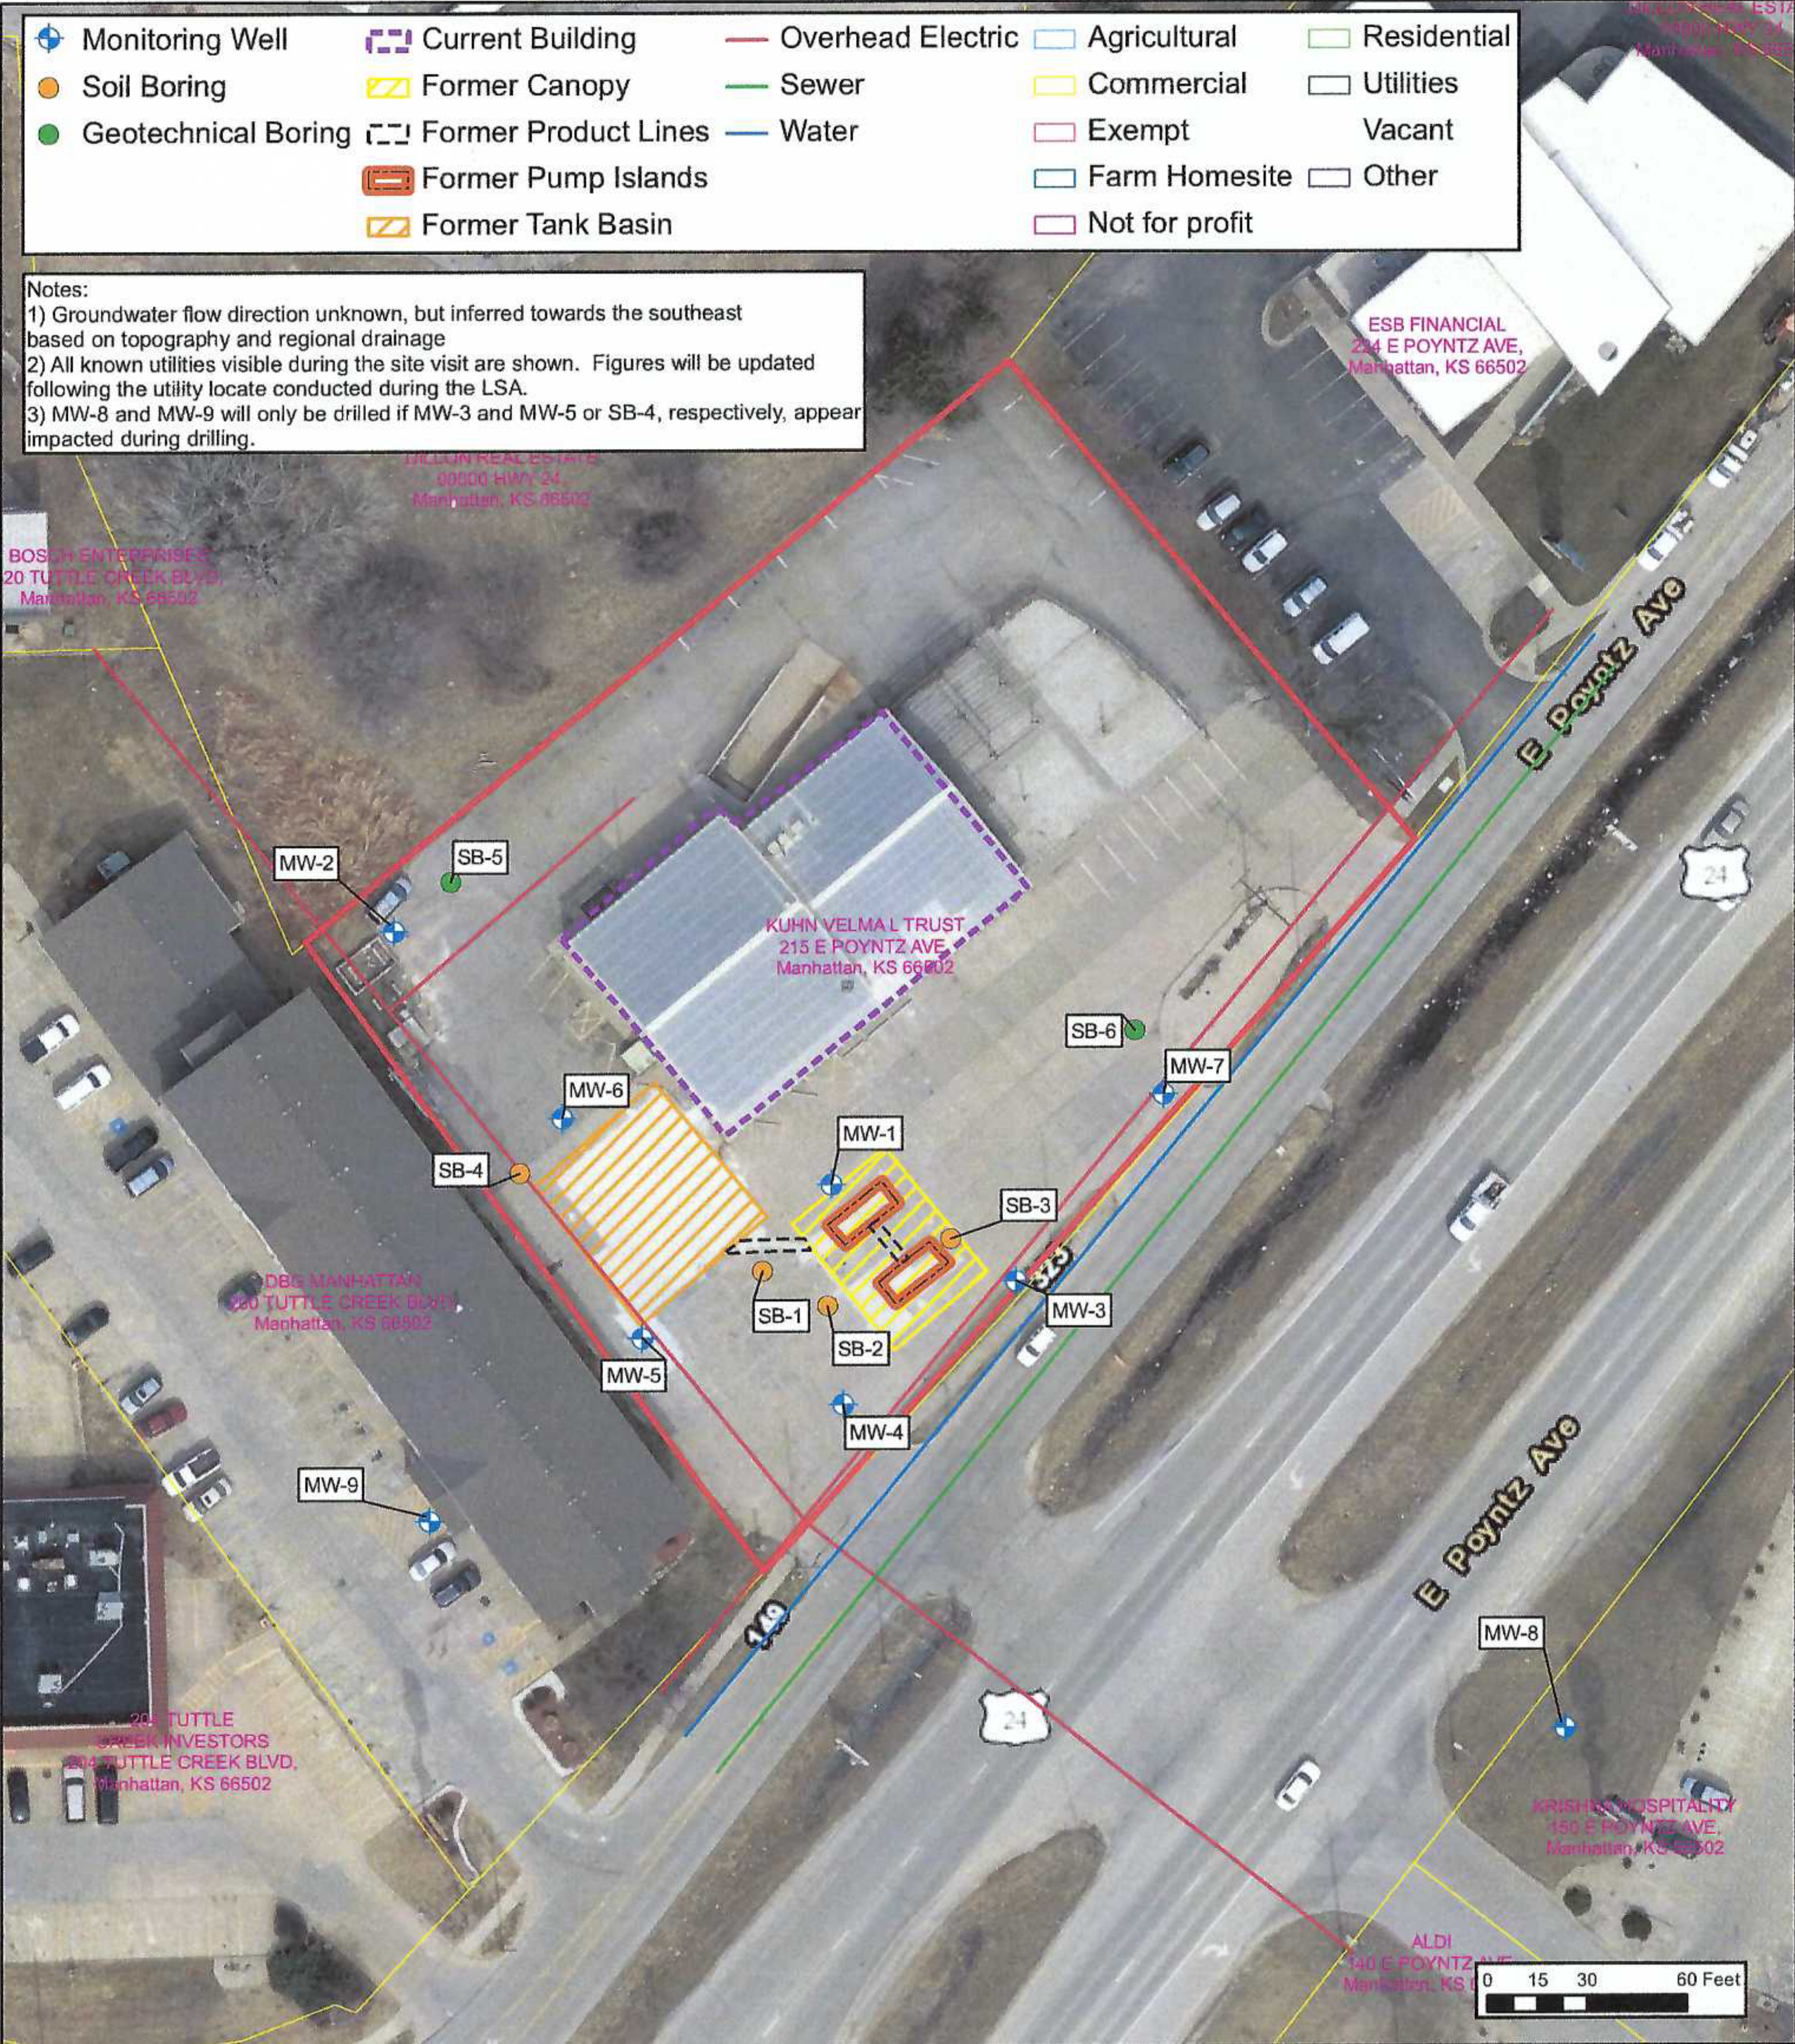

DESIGNED BY:	CP
DRAWN BY:	CP
CHECKED BY:	JM
APPROVED BY:	CC
DATE:	MAY 2021

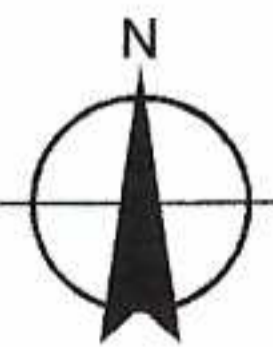

Site Map
MKC - Manhattan



215 E. Poyntz
Manhattan, Kansas
U4-075-15213

FIGURE
2

**Limited Site
Assessment
Work Plan**

DENNIS L HANDKE

1820 NW 59th Terrace
TOPEKA, KANSAS 66618
785-286-4047 Home

Jamie Murphy
112 SW 6th Street, Suite 201
Topeka, Kansas, 66603

July 29, 2021

RE: Monitor Well Elevation Survey
215 E. Poyntz, Manhattan, Kansas

Proj. 21-00W
MKC - Manhattan
U4-075-15213


Bench Mark: Chisled Square on SW corner of concrete Sidewalk at SW corner of building.
Elev: 1010.39 North 2636.53 West 4780.83 (from SE Cor. Sec. 17-10-8E)

✓ MW-1	rim	1009.19	North	2617.27	NE1/4,NW1/4,NW1/4,SW1/4
	top pipe	1008.90	West	4750.88	Lat= 39.18120 Long = 96.55531
✓ MW-2	rim	1009.79	North	2706.77	NE1/4,NW1/4,NW1/4,SW1/4
	top pipe	1009.30	West	4871.90	Lat= 39.18145 Long = 96.55574
✓ MW-3	rim	1008.35	North	2600.29	NE1/4,NW1/4,NW1/4,SW1/4
	top pipe	1007.91	West	4692.73	Lat= 39.18115 Long = 96.55511
✓ MW-4	rim	1008.26	North	2554.28	NE1/4,NW1/4,NW1/4,SW1/4
	top pipe	1007.60	West	4745.82	Lat= 39.18103 Long = 96.55530
✓ MW-5	rim	1009.00	North	2571.83	NE1/4,NW1/4,NW1/4,SW1/4
	top pipe	1008.44	West	4807.69	Lat= 39.18108 Long = 96.55551
✓ MW-6	rim	1010.07	North	2643.72	NE1/4,NW1/4,NW1/4,SW1/4
	top pipe	1009.56	West	4830.25	Lat= 39.18127 Long = 96.55559
✓ MW-7	rim	1008.67	North	2656.98	NE1/4,NW1/4,NW1/4,SW1/4
	top pipe	1008.35	West	4651.15	Lat= 39.18131 Long = 96.55496
✓ MW-8	rim	1009.63	North	2449.92	SW1/4,NE1/4,NW1/4,SW1/4
	top pipe	1009.08	West	4517.87	Lat= 39.18074 Long = 96.55449
✓ MW-9	rim	1011.66	North	2511.00	NE1/4,NW1/4,NW1/4,SW1/4
	top pipe	1011.15	West	4885.78	Lat= 39.18091 Long = 96.55579

Lat & Long derived from Manhattan 7.5' quad map. WGS84

Elevation established from NGS BM G 370. NAVD 88

If you have any questions, please feel free to call me. Thank you for the opportunity to be of service to you!

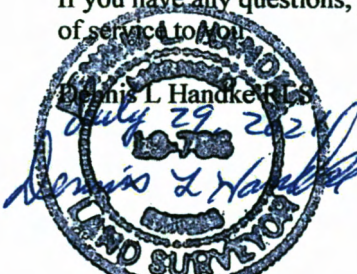

RECEIVED
AUG 13 2021
BUREAU OF WATER