
	ELL RECO			WWC-5			sion of Water] [MW-31S	
	cord Corre			e in Well Use			urces App. No		Well ID		
	N OF WATER	R WEL	L:	Fraction			tion Number		1	ge Number	
County: R				SE ¼ SE ¼ SE							
2 WELL OWNER: Last Name: First: Street or Rural Address where well is located (if unknown, dista											
Business: KDHE Address: 1000 SW Jackson Street, Suite 420 direction from nearest town or intersection): If at owner's address, check here:											
Address:											
City: To	opeka		State: KS	ZIP: 66612-136							
3 LOCATE W	VELL 4 D	EDTLI	OF COM	IPLETED WELL	. 3	Λ 4	5 T -4:4-	de: 39.1900	12	4	
WITH "X"	IIN Dont			Encountered: 1)							
SECTION B				3) ft., or 4							
N	WEI	L'S ST	TATIC WA	TER LEVEL:	21.1	.1 ft. Source for Latitude/Longitude:					
		, measured on (mo-da		/-yr) 12-17-2022 GPS (unit make/model:							
NW 1					(mo-day-yr)			(WAAS enabled? ☐ Yes ☐ No)			
	1 1 1				r was ft.			■ Land Survey ☐ Topographic Map			
W	E	aπer		s pumpingvater was							
SW	SE	after		s pumping							
	Estir	nated Y	ield:	gpm				6 Elevation: 1009.61ft. ☐ Ground Level ■ TOC			
S	Bore	Hole I	Diameter:	8.75 in. to 30	ft. a	and	Source: Land Survey GPS Topographic Map				
1 mile-				in. to				☐ Other			
1	TER TO BE U										
1. Domestic:				ter Supply: well ID			10. 🔲 Oil	Field Water Supply: 1	ease		
Household	-			g: how many wells?				11. Test Hole: well ID			
☐ Lawn & G		/	Aquiter R	echarge: well ID g: well IDM	W-31S			sed Uncased ermal: how many bore			
2. Irrigation				al Remediation: well				erman: now many bore sed Loop			
3. Feedlot			Air Sparge					en Loop Surface D			
4. Industrial			Recovery		. Daude			ner (specify):			
Was a chemic	al/hacteriologi				¬ Voc	■ No		sample was submitte			
	infected? \square Y			inted to KDHE: [1 ¢s	NO	11 yes, date	sample was submitted	.u		
				C \(\subseteq \text{ Other} \)		CASIN	G IOINTS:	☐ Glued ☐ Clampe	d □ Welded	■ Threaded	
Casing diameter	2 in.	to	20 ft.	Diameter	in. to	0	ft Diame	eterin. to .	ft.	Timeaded	
Casing height ab	ove land surface		0 in	. Weight		. lbs./ft.	Wall thicks	ness or gauge No. SCh	40		
	REEN OR PERI	FORA	TION MA								
☐ Steel	☐ Stainless St		☐ Fiber					er (Specify)			
Brass	☐ Galvanized		☐ Conc		e used (c	open hole)				
	PERFORATIO										
Continuou		ll Slot						Other (Specify)		•••••	
	Shutter						one (Open Ho		Α	Δ	
SCREEN-PERFORATED INTERVALS: From											
								t pad			
Grout Intervals:	From 1	fl to	18	f From 0	enionii A to	te ■ 0	f From	ft, to	A	• • • • • • • • • • • • • • • • • • • •	
Nearest source	of possible conta	it. to ıminati	on:	10., 1 10111	11. 10		11., 110111 .	16, 60			
☐ Septic Tani			Lateral Line	es 🔲 Pit Privy			Livestock Pen	Insecti	icide Storage		
☐ Sewer Line			Cess Pool	☐ Sewage			Fuel Storage		loned Water V	Vell	
Watertight			Seepage Pit	☐ Feedyard	i	_ I	Fertilizer Stor	age	ell/Gas Well		
Direction from	city) .Dry.Clea	ners		Distance from	110	100 ft		fi			
10 FROM	TO		ITHOLO							NITEDWALC	
0 1	Topso		ATHOLOG	JIC LUG	- F	ROM	TO	LITHO. LOG (cont.) o	I FLUGGING	JINTERVALS	
1 5			Own moi	st, plastic, sandy				***************************************			
5 10				noist, plastic, sality							
10 25				aturated, silty	-						
25 30				aturated, silty							
20 00	gradin			aturatou, Silty	_						
	gradin	9 10 30	ai iu		N/	otes:					

11 CONTRACTOR'S OR LANDOWNER'S CERTIFICATION: This water well was constructed, reconstructed, or plugged											
under my jurisdiction and was completed on (mo-day-year) .12-15-2021 and this record is true to the best of my knowledge and belief. Kansas Water Well Contractor's License No. 604 This Water Well Record was completed on (mo-day-year)											
Kansas Water Well Contractor's License No. 604 This Water Well Record was completed on (mo-day-year)											
under the busing	ness name of .	nyıror	imental P	riority Service, In	Q	Sig	gnature X	MMI			
								Environment, Bureau of W			
1	/ Jackson St., Suite /www.kdheks.gov/wa			00012-130/. Mail one		Well Own 82a-12		e for your records. Telep		7/10/2015	
Viole us at Intp.//W	www.kulleko.guv/Wa	COLWCII/I	HUUN.HIIII		INDA	1 ULU-12			110 11000	,,,,,,,,,,,,,,,,,,,,,,,,,,,,,,,,,,,,,,,	

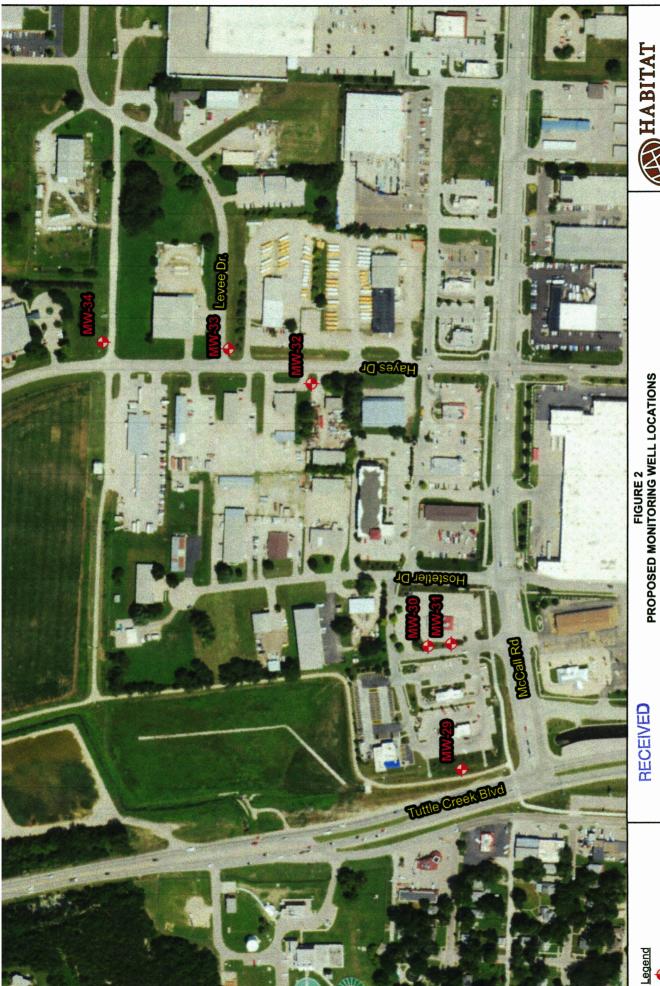

HABITAT

Drawn By: R Bath

Project Manager: J Polak

Date: 08/30/2021

KDHE#: C5-081-70782

CINDERELLA CLEANERS and STICKEL CLEANERS MANHATTAN, KANSAS

Source: NAIP 2019 || Location: SE 1/4 of Sec 7 and the SW 1/4 of Sec 8 - T10S - R8E, Riley County and Pottawatomie County, KS

NORTH

BUREAU OF WATER

Proposed Monitoring Well

egend

RECEIVED

150 1 in. = 300 ft.

RECEIVED

DENNIS L HANDKE

FEB 3 3 2022

BUREAU OF WATER

1820 NW 59th Terrace TOPEKA, KANSAS 66618 785-286-4047 Home

Jonathan Polak
Habitat Architects
3904 East 185th Street
Belton, Missouri 64012

January 21, 2022

RE: Monitor Well Elevation Survey Manhattan, Kansas

Proj. 22-00B Cinderella Cleaners and Stickel Cleaners C5-081-70782

Bench Mark: Chisled Square on NE corner of concrete signal light base at NE corner of Hayes Dr. & McCall Rd.

McCall Rd. Elev: 1008.24

North 55.35

West 4591.88

(from SE Cor. Sec. 8-10-8E)

√MW-29S	rim	1010.73	North	65.34	SW1/4,SE1/4,SE1/4,SE1/4 (Sec. 7-10-8E)
	top pipe	1010.20	West	5976.67	Lat= 39.18970 Long = 96.55960
√MW-29D	rim	1010.73	North	61.72	SW1/4,SE1/4,SE1/4,SE1/4 (Sec. 7-10-8E)
	top pipe	1010.18	West	5975.27	Lat= 39.18969 Long = 96.55960
√MW-30S	rim	1010.09	North	251.08	SE1/4,SE1/4,SE1/4,SE1/4 (Sec. 7-10-8E)
	top pipe	1009.60	West	5556.11	Lat= 39.19020 Long = 96.55812
$\sqrt{_{\text{MW-30D}}}$	rim	1010.05	North	248.38	SE1/4,SE1/4,SE1/4,SE1/4 (Sec. 7-10-8E)
	top pipe	1009.60	West	5556.76	Lat= 39.19021 Long = 96.55812
√MW-31S	rim	1010.25	North	180.76	SE1/4,SE1/4,SE1/4,SE1/4 (Sec. 7-10-8E)
	top pipe	1009.61	West	5546.39	Lat= 39.19002 Long = 96.55808
√MW-31D	rim	1010.02	North	176.86	SE1/4,SE1/4,SE1/4,SE1/4 (Sec. 7-10-8E)
	top pipe	1009.53	West	5545.84	Lat= 39.19000 Long = 96.55808
√MW-32S	rim top pipe	1007.35 1006.84	North West		NE1/4,SW1/4,SW1/4,SW1/4 Lat= 39.19119 Long = 96.55512
/ _{MW-32D}	rim	1007.35	North	603.93	NE1/4,SW1/4,SW1/4,SW1/4
	top pipe	1006.84	West	4705.04	Lat= 39.19119 Long = 96.55510
√MW-33S	rim	1007.70	North	892.90	SW1/4,NE1/4,SW1/4,SW1/4
	top pipe	1007.06	West	4610.81	Lat= 39.19198 Long = 96.55479
√ _{MW-33D}	rim	1007.68	North	893.13	SW1/4,NE1/4,SW1/4,SW1/4
	top pipe	1007.12	West	4606.23	Lat= 39.19198 Long = 96.55477
MW-34S	rim	1007.54	North	1288.87	NE1/4,NE1/4,SW1/4,SW1/4
	top pipe	1006.97	West	4624.71	Lat= 39.19307 Long = 96.55483
√MW-34D	rim	1007.42	North	1289.06	NE1/4,NE1/4,SW1/4,SW1/4
	top pipe	1006.92	West	4621.09	Lat= 39.19307 Long = 96.55484