

WATER WELL RECORD Form WWC-5

Original Record Correction Change in Well Use

Division of Water Resources App. No.

Well ID

MW8

1 LOCATION OF WATER WELL: County: Shawnee Fraction NE 1/4 SW 1/4 NE 1/4 NW 1/4 Section Number 2 Township Number T 11 S Range Number R 15 E W

2 WELL OWNER: Last Name: Business: Petro Deli 4, LLC Address: 3603 NW 46th St. City: Topeka State: KS ZIP: 66618 Street or Rural Address where well is located

3 LOCATE WELL WITH 'X' IN SECTION BOX: 4 DEPTH OF COMPLETED WELL: 20 ft. 5 Latitude: 39.12867 Longitude: 95.71825 6 Elevation: 975.36 ft.

7 WELL WATER TO BE USED AS: 1. Domestic: 2. Irrigation 3. Feedlot 4. Industrial 5. Public Water Supply 6. Dewatering 7. Aquifer Recharge 8. Monitoring MW8 9. Environmental Remediation 10. Oil Field Water Supply 11. Test Hole 12. Geothermal 13. Other

Was a chemical/bacteriological sample submitted to KDHE? Water well disinfected?

8 TYPE OF CASING USED: 2 in. to 5 ft. CASING JOINTS: 40. TYPE OF SCREEN OR PERFORATION MATERIAL: SCREEN OR PERFORATION OPENINGS ARE: SCREEN-PERFORATED INTERVALS: GRAVEL PACK INTERVALS:

9 GROUT MATERIAL: Neat cement Cement grout Bentonite Other Cement (0-1). Nearest source of possible contamination: Direction from well? South Distance from well? 120 ft.


Table with columns: 10 FROM, TO, LITHOLOGIC LOG, FROM, TO, LITHO. LOG (cont.) or PLUGGING INTERVALS. Rows: 0-10 Clay, brown-grey; 10-20 Clay, brown-orange.

11 CONTRACTOR'S OR LANDOWNER'S CERTIFICATION: This water well was constructed, reconstructed, or plugged under my jurisdiction and was completed on (mo-day-year) 5/31/19 and this record is true to the best of my knowledge and belief.

Notes:

- 1) Direction of groundwater flow unknown, but inferred to the south-southeast (towards tributary of Soldier Creek) based on topography and regional drainage.
- 2) All known utilities visible during the site visit are shown. Figures will be updated following the public utility locates conducted during the LSA. Subsurface penetrations will be air knifed to a total depth of 5-feet for utility clearance.

	Monitoring Well		Building
	Soil Boring		Product Lines (Approximate)
	Geotechnical Soil Boring		Petro Deli Property Boundary
	Overhead Electric		Pump Islands
	Storm Sewer		UST Basin (Approximate)
	Water		Commercial Parcel
			Residential Parcel

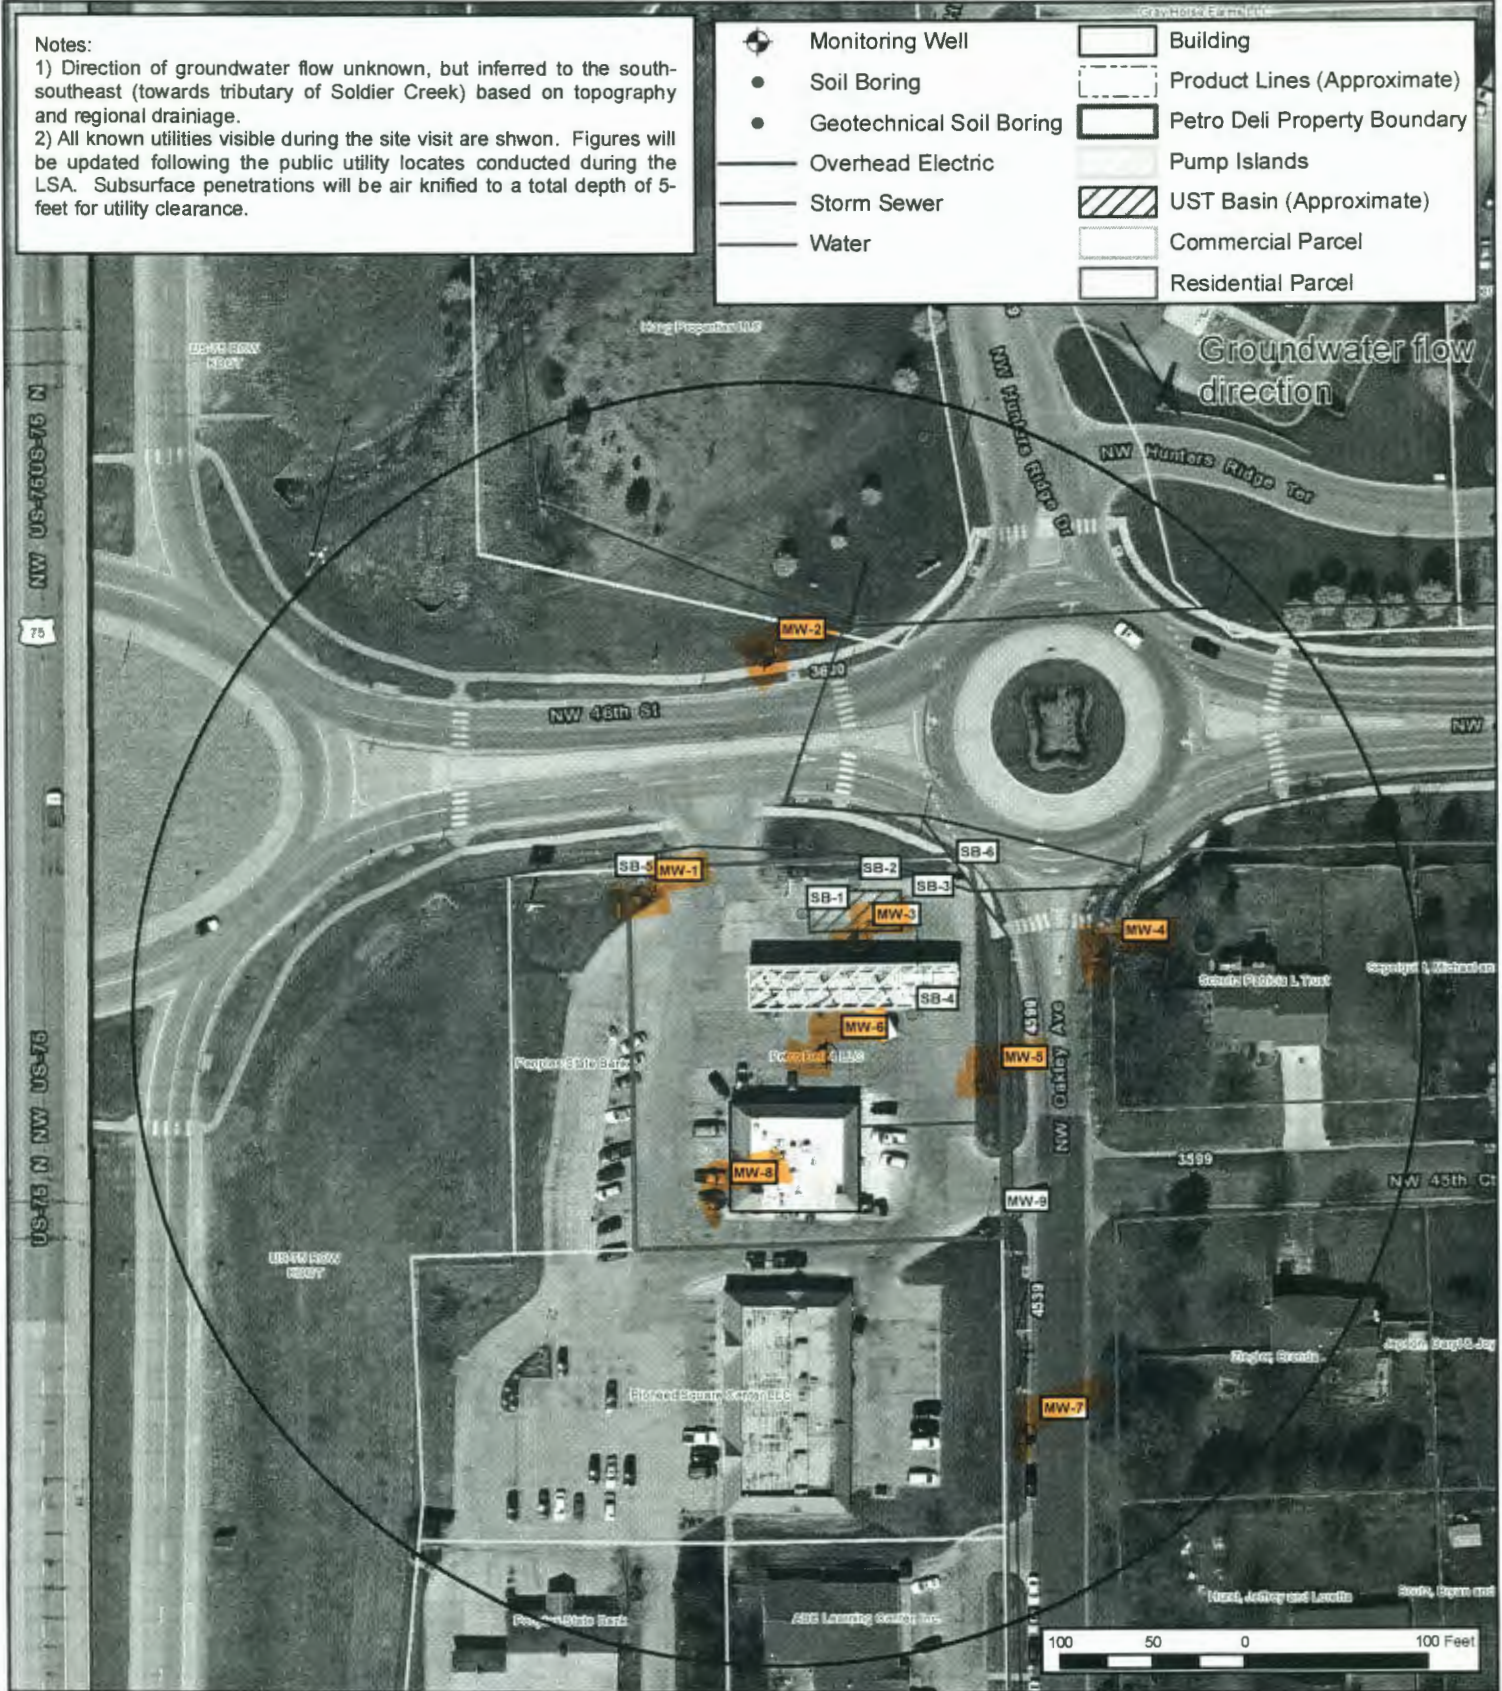

DESIGNED BY: CC		General Site Location (350-ft radius)		Figure	Limited Site Assessment Work Plan	
DRAWN BY: CC		Petro Deli 4, LLC				
CHECKED BY: RW			3603 NW 46th Street			3
APPROVED BY: CC			Topeka, Kansas			
DATE: APRIL 2019			U4-089-15024			