WATER WELL RECORD Form WWC-5	Division of Water	
X Original Record Correction Change in Well Ust	Resources App. No. Well ID MW2	
1 LOCATION OF WATER WELL: Fraction	Section Number Township Number Range Number	
County Shawnee NE 1/4 NW	4 NE ¼ NW ¼ 36 T 11 S R 15 X E W	
2 WELL OWNER: Last Name: First:	Street or Rural Address where well is located (if unknown, distance and direction	
Business: KDHE Address: 1000 SW Jackson Blvd	from nearest town or intersection): If at owner's address, cheek here:	
Address:	2001 SW 6th Avc., Topeka, KS	
City Topcka State: KS ZIP: 66612		
3 LOCATE WELL 4 DEPTH OF COMPLETED WELL	15 ft 5 Latitude: 39.05823 (decimal degrees)	
WITH "X" IN Depth(s) Groundwater Encountered: 1)	ft Longitude 95.69941 (decimal degrees)	
SECTION BOX: 2) ft 3) ft, or 4) WELL'S STATIC WATER LEVEL:		
X below land surface, measured on (mo		
above land surface, measured on (me	-day-yr) (WAAS enabled? Yes No)	
NW NE Pump test data: Well water was	ft X Land Survey Topographic Map	
w after hours pumping		
Water well was	ft	
sw se afterhours pumping		
Estimated Yield: gpm	Source X Land Survey GPS Topographic Map	
Bore Hole Diameter: 7.25 in to	ft, and Other	
Sin to		
7 WELL WATER TO BE USED AS:		
1 Domestic: 5 Public Water Supply: well ID	10 Oil Field Water Supply: lease	
Household 6 Dewatering: how many wells?	11 Test Hole; well ID	
Lawn & Garden 7 Aquifer Recharge: well ID	Cased Uncased Geotechnical	
Livestock 8 X Monitoring: well ID MW2 2 Irrigation 9 Environmental Remediation: well ID	12 Geothermal: How many bores?	
	a) Closed Loop Horizontal Vertical	
3 Feedlot Air Sparge Soil Vapor Extr 4 Industrial Recovery Injection		
	Other (specify):	
Was a chemical/bacteriological sample submitted to KDHE? Yes	No If yes, date sample was submitted:	
Water well disinfected? Yes X No		
8 TYPE OF CASING USED: Steel X PVC Other CASING JOINTS: Glued Clampled Welded X Threaded		
Casing diameter 2 in. to 5 ft, Diameter in. Casing height above land surface -0.32 in. Weight	to ft, Diameter in. to ft,	
TYPE OF SCREEN OR PERFORATION MATERIAL:	lbs./ft. Well thickness or gauge No	
Steel Stainless Steel Fiberglass X PVC Other (Specify)		
Brass Galvanized Steel Concrete tile None used (open hole)		
SCREEN OR PERFORATION OPENINGS ARE:	per note)	
	Forch Cut Drilled Holes Other (Specify)	
Louvered Shutter Key Punched Wire Wrapped Saw Cut None (Open Hole)		
SCREEN-PERFORATED INTERVALS: From 5 ft. to 15 ft	, Fromft. toft,	
GRAVEL PACK INTERVALS: From 3 ft. to 15 ft	, From ft. to ft, From ft. to ft,	
9 GROUT MATERIAL: Neat cement Cement grout X B		
	entonite X Other Concrete: 0-0.7' of, From ft. to ft,	
Nearest source of possible contamination:		
Septic Tank Lateral Lines Pit Privy	Livestock Pens Insceticide Storage	
Sewer Lines Cess Pool Sewage Lag		
Watertight Sewer Lines Secpage Pit Feedyard	Fertilizer Storage Oil Well / Gas Well	
Other (Specity)		
Direction from well? Unknown Distance from	n well? Unknown ft	
10 FROM TO LITHOLOGIC LOG	FROM TO LITHO. LOG (cont.) or PLUGGING INTERVALS	
0 0.3 Gravel and broken asphalt		
0.3 2 Silty clay		
2 12 Clayey silt w/ sand		
12 15 Weathered shale w/ occasional limestone fingers		
	Notes: KDHE ID: Sinclair, Topeka; U4-089-15037	
	Target of monitoring well is shallow groundwater, <20' of grout was installed at	
L	the direction of KDHE.	
II CONTRACTOR'S OR LANDOWNER'S CERTIFICATION: This wat	er well was X constructed, reconstructed, or plugged under my	
jurisdiction and was completed on (mo-day-year) 7/24/19 and this reco	er well was X constructed, reconstructed, or plugged under my, and is true to the best of my knowledge and belief. Kansas Water Well Contractor's	
jurisdiction and was completed on (mo-day-year) 7/24/19 and this reco	er well was X constructed, reconstructed, or plugged under my rd is true to the best of my knowledge and belief. Kansas Water Well Contractor's (mo-day-year) 8/8/19	
jurisdiction and was completed on (mo-day-year) 7/24/19 and this reconcurrence No. 757 This Water Well Record was completed or under the business name of Larsen & Associates, Inc.	er well was X constructed, reconstructed, or plugged under my rd is true to the best of my knowledge and belief. Kansas Water Well Contractor's (mo-day-year) 8/8/19 Signature	
jurisdiction and was completed on (mo-day-year) 7/24/19 and this reconcerns No. 757 This Water Well Record was completed or under the business name of Larsen & Associates, Inc. Mail I white copy along with a fee of \$5.00 for each constructed well to:	er well was X constructed, reconstructed, or plugged under my rd is true to the best of my knowledge and belief. Kansas Water Well Contractor's (mo-day-year) 8/8/19	

DENNIS L HANDKE

1820 NW 59th Terrace TOPEKA, KANSAS 66618 785-286-4047 Home

Jess Chapman Larsen & Associates 1311 E. 25th Street, Suite B Lawrence, Kansas 66046 August 1, 2019

RE: Monitor Well Elevation Survey 2001 SW 6th Ave., Topeka, Kansas

Proj. 19-00AA Sinclair, Topeka KDHE ID U4-089-15037

Bench Mark: Chisled Sq. on center front of storm inlet near NE corner of property. Elev: 910.41 North 5161.89 West 3346.31 (from SE Cor. Sec. 36-11-15E) NE1/4,NW1/4,NE1/4,NW1/4 MW-1 5156.99 912.42 North rim Lat = 39.05835 Long = 95.69942West 3387.29 top pipe 912.15 MW-2 NE1/4,NW1/4,NE1/4,NW1/4 rim 912.55 North 5112.37 3385.35 Lat = 39.05823Long = 95.69941top pipe 912.23 West MW-3 NE1/4,NW1/4,NE1/4,NW1/4 rim 918.73 North 5138.57 top pipe 918.49 West 3492.68 Lat = 39.05830 Long = 95.69979MW-4 rim 910.13 North 5212.24 NE1/4,NW1/4,NE1/4,NW1/4 top pipe 909.81 3318.36 Lat = 39.05850 Long = 95.69917West MW-5 NE1/4,NW1/4,NE1/4,NW1/4 rim 912.31 North 5011.61 Lat = 39.05795 Long = 95.69922top pipe 912.00 West 3330.12 MW-6 rim 911.24 North 5109.47 NE1/4,NW1/4,NE1/4,NW1/4 top pipe 910.94 West 3302.46 Lat = 39.05822Long = 95.69912

Elevation derived from City of Topeka bench mark #187.1 NAVD 27.

Lat & Long derived from Topeka 7.5 Quad Map WGS84.

If you have any questions, please feel free to call me. Thank you for the opportunity to be


of service to you.".

Dennis L. Handke RISS

RECEIVED

AUG 2 8 2019

BUREAU OF WATER

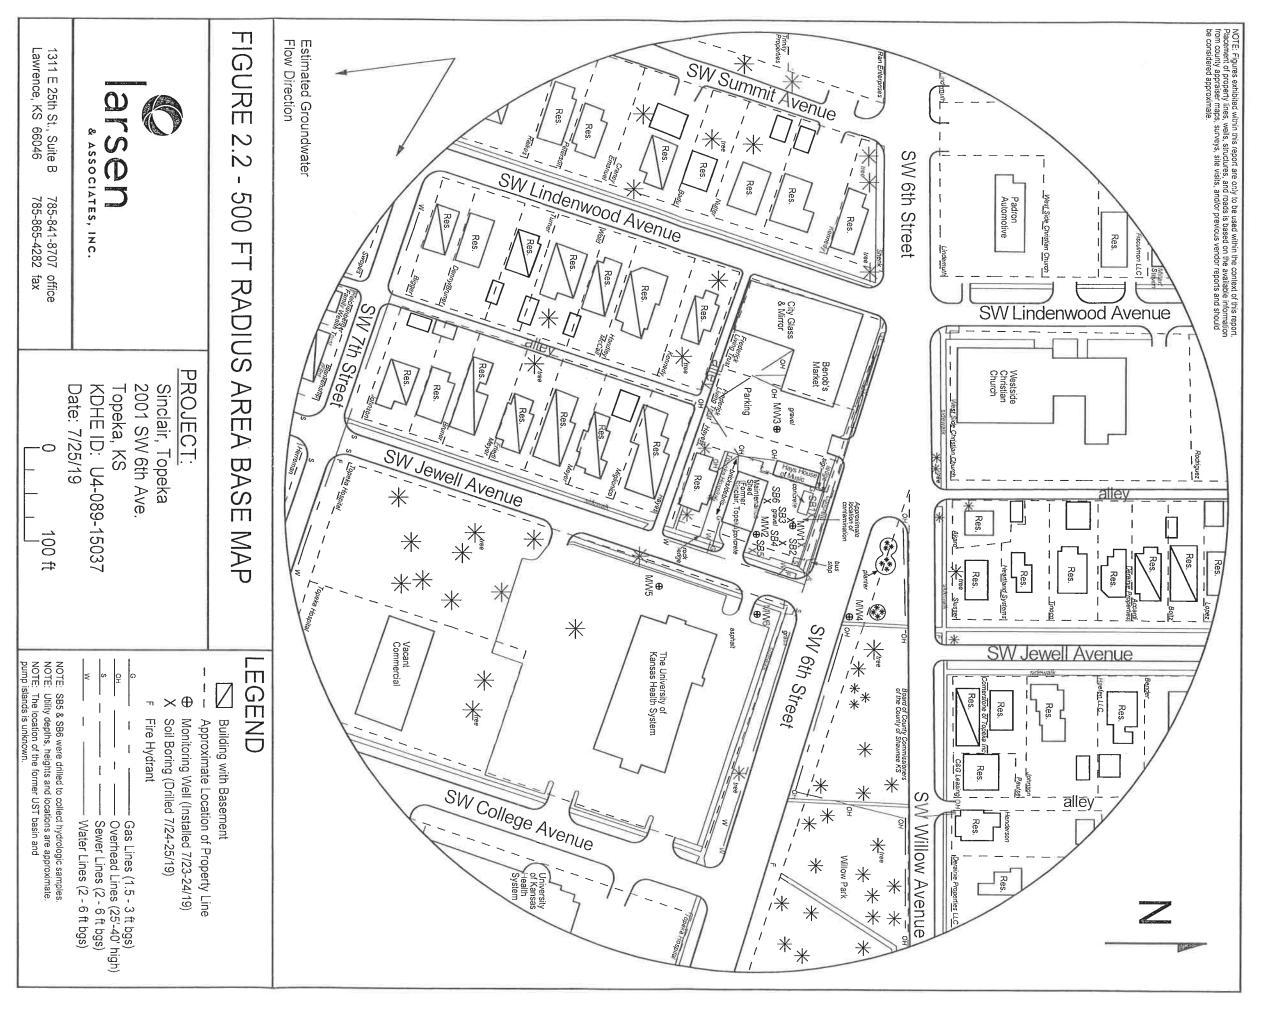

RECEIVED

AUG 2 8-2019

BUREAU OF WATER