WATER WELL REC				vision of Water		Wall ID	MW4
X Original Record		n Well Ust	Keso	urces App. No.] Well ID	
1 LOCATION OF W County Shawnee	ATER WELL:	Fraction NE '4 NW '4 N	E ¼ NW ½	1	Township Nun	-	Number 5 X E W
2 WELL OWNER: Last Name: First: Street or Rural Address where well is located (if unknown, distance and direction							
Business: KDHE from nearest town or intersection): If at owner's address, check here:							
Address: 1000 SW Jackson Blvd ~65' NE of 2001 SW 6th Ave., Topcka, KS							
Address: City Topeka State: KS ZIP: 66612							
3 LOCATE WELL			18 ft	5 Latitude:	39.058	350 (de	cimal degrees)
WITH "X" IN	Depth(s) Groundwater	Encountered: 1)	ft	Longitude	***************************************	<u></u>	cimal degrees)
SECTION BOX:	2) ft 3)n, or 4)Dry	well	Horizontal			83 NAD 27
N WELL'S STATIC WATER LEVEL: 6.73 ft. Source for Latitude/Longitude: X below land surface, measured on (mo-day-yr) 7/25/19 GPS (unit make/model:							`
above land surface, measured on (mo-day-yr) (WAAS enabled? Ves No)							<i>)</i>
NW NE -	Pump test data: Wel	ft	X Land Survey Topographic Map				
w I	hc	ours pumping		Online	Mapper		
		ater well was	ft	6 Flaustian	000.81 6	Ground L	evel X TOC
SW SE -	Estimated Yield:	ours pumping	gpm	6 Elevation	909.81 ft Land Survey		Topographic Map
	Bore Hole Diameter:	7.25 in to	ft. and	Source	Other	J 013	Topograpine iviap
S		in to	ft				***************************************
I mile							
7 WELL WATER TO 1 Domestie:	BE USED AS: 5 Public Water Su	pply: well ID	1	O Oil Field V	Vater Supply: lease	e	
Household	6 Dewatering: ho			11 Test Hole: well			
Lawn & Garden	7 Aquifer Recharg	e: well ID		Cased	Uncased	Geotechnic	al
Livestock	8 X Monitoring: we		1	12 Geothermal: Ho			
2 Irrigation 9 Environmental Remediation: well ID a) Close 3 Feedlot Air Sparge Soil Vapor Extractior b) Open					· <u>—</u>	1 Vertic	
3 Feedlot 4 Industrial	Air Sparge Recovery	Soil Vapor Extraction Injection		b) Open Loop Other (spec	-:6-0-	ischarge	, ,
Was a chemical/bacteriological sample submitted to KDHE? Yes X No If yes, date sample was submitted: Water well disinfected? Yes X No							
8 TYPE OF CASING USED: Steel X PVC Other CASING JOINTS: Glued Clampled Welded X Threaded Casing diameter 2 in to 8 ft, Diameter in to ft, Diameter in to ft,							
Casing height above land surface -0.32 in. Weight lbs./ft. Well thickness or gauge No							
TYPE OF SCREEN OR PERFORATION MATERIAL:							
Steel Stainless Steel Fiberglass X PVC Other (Specify)							
Brass Galvanized Steel Concrete tile None used (open hole) SCREEN OR PERFORATION OPENINGS ARE:							
Continuous Slot X Mill Slot Gauze Wrapped Torch Cut Drilled Holes Other (Specify) Louvered Shutter Key Punched Wire Wrapped Saw Cut None (Open Hole)							
SCREEN-PERFORATED INTERVALS: From 8 ft. to 18 ft, From ft. to ft, From ft. to ft,							
GRAVEL PACK IN	TERVALS: From 6	ft. to 18 ft, Fr	om ft	. to	ft, From	ft. to	ft,
9 GROUT MATERIAL:		ement grout X Benton		r Concrete: 0-0.7		******	
Grout intervals: From 0.7 ft. to 6 ft, From ft. to ft, From ft. to ft,							
Nearest source of possible							
Septic Tank	Lateral Lines	Pit Privy		stock Pens	Insecticide	-	
Sewer Lines	Cess Pool	Scwage Lagoon		Storage	=	d Water Well	
Watertight Sewer Line Other (Specity)	Seepage Pit	Feedyard	Ferti	lizer Storage	Oil Well /	Gas Well	
Direction from well? Unknow	vn	Distance from well	? Unknown		ft		
10 FROM TO	LITHOLO		FROM	OT	LITHO, LOG (co	nt.) or PLUGGIN	IG INTERVALS
	Topsoil		11011	1	2.1110. 200 (00	, 0. 1 200011	CHILKINLO
	Silty clay						
	Sandy clay						
	Sandy clay w/ coarse gravel Limestone gravel					,	
	Limestone						
					l'opcka; U4-089-1		
Target of monitoring well is shallow groundwater, <20' of grout was installed at							
the direction of KDHE. CONTRACTOR'S OR LANDOWNER'S CERTIFICATION: This water well was X constructed, reconstructed, or reconstructed, rec							
jurisdiction and was completed on (mo-day-year) 7/23/19 and this record is true to the best of my knowledge and belief. Kansas water Weil Contractor's							
License No 757	This Water Well Rec	ord was completed on (mo-		9		\rightarrow	
	f Larsen & Associates, Inc.			Signature			
	copy along with a fee of \$5.00 for e						4
1000 SW Jackson St., Suite 420, Topeka, Kansas 66612-1367. Mail one to Water Well Owner and retain one for your records. Telephone 785-296-5524. Visit us at http://www.kdheks.gov/waterwell/index.html KSA 82a-1212 Revised 7/10/2015							
	Contract to the modern manner.						

DENNIS L HANDKE

1820 NW 59th Terrace TOPEKA, KANSAS 66618 785-286-4047 Home

Jess Chapman Larsen & Associates 1311 E. 25th Street, Suite B Lawrence, Kansas 66046 August 1, 2019

RE: Monitor Well Elevation Survey 2001 SW 6th Ave., Topeka, Kansas

Proj. 19-00AA Sinclair, Topeka KDHE ID U4-089-15037

NE1/4,NW1/4,NE1/4,NW1/4

Lat = 39.05822 Long = 95.69912

North 5161.89 (from SE Cor. Sec. 36-11-15E) West 3346.31 Elev: 910.41 MW-1 912.42 North 5156.99 NE1/4,NW1/4,NE1/4,NW1/4 rim Lat = 39.05835 Long = 95.69942West 3387.29 top pipe 912.15 MW-2 912.55 North 5112.37 NE1/4,NW1/4,NE1/4,NW1/4 rim Lat = 39.05823 Long = 95.69941912.23 West 3385.35 top pipe NE1/4,NW1/4,NE1/4,NW1/4 MW-3 rim 918.73 North 5138.57 Lat = 39.05830 Long = 95.69979918.49 3492.68 top pipe West NE1/4,NW1/4,NE1/4,NW1/4 MW-4 910.13 North 5212.24 rim Lat = 39.05850 Long = 95.69917909.81 West 3318.36 top pipe NE1/4,NW1/4,NE1/4,NW1/4 MW-5 912.31 5011.61 rim North Lat = 39.05795 Long = 95.69922top pipe 912.00 West 3330.12

5109.47

3302.46

Bench Mark: Chisled Sq. on center front of storm inlet near NE corner of property.

Elevation derived from City of Topeka bench mark #187.1 NAVD 27.

North

West

Lat & Long derived from Topeka 7.5 Quad Map WGS84.

911.24

top pipe 910.94

If you have any questions, please feel free to call me. Thank you for the opportunity to be

of service to you.

MW-6


Dennis L.Handke RLS

rim

RECEIVED

AUG 2 8 2019

BUREAU OF WATER

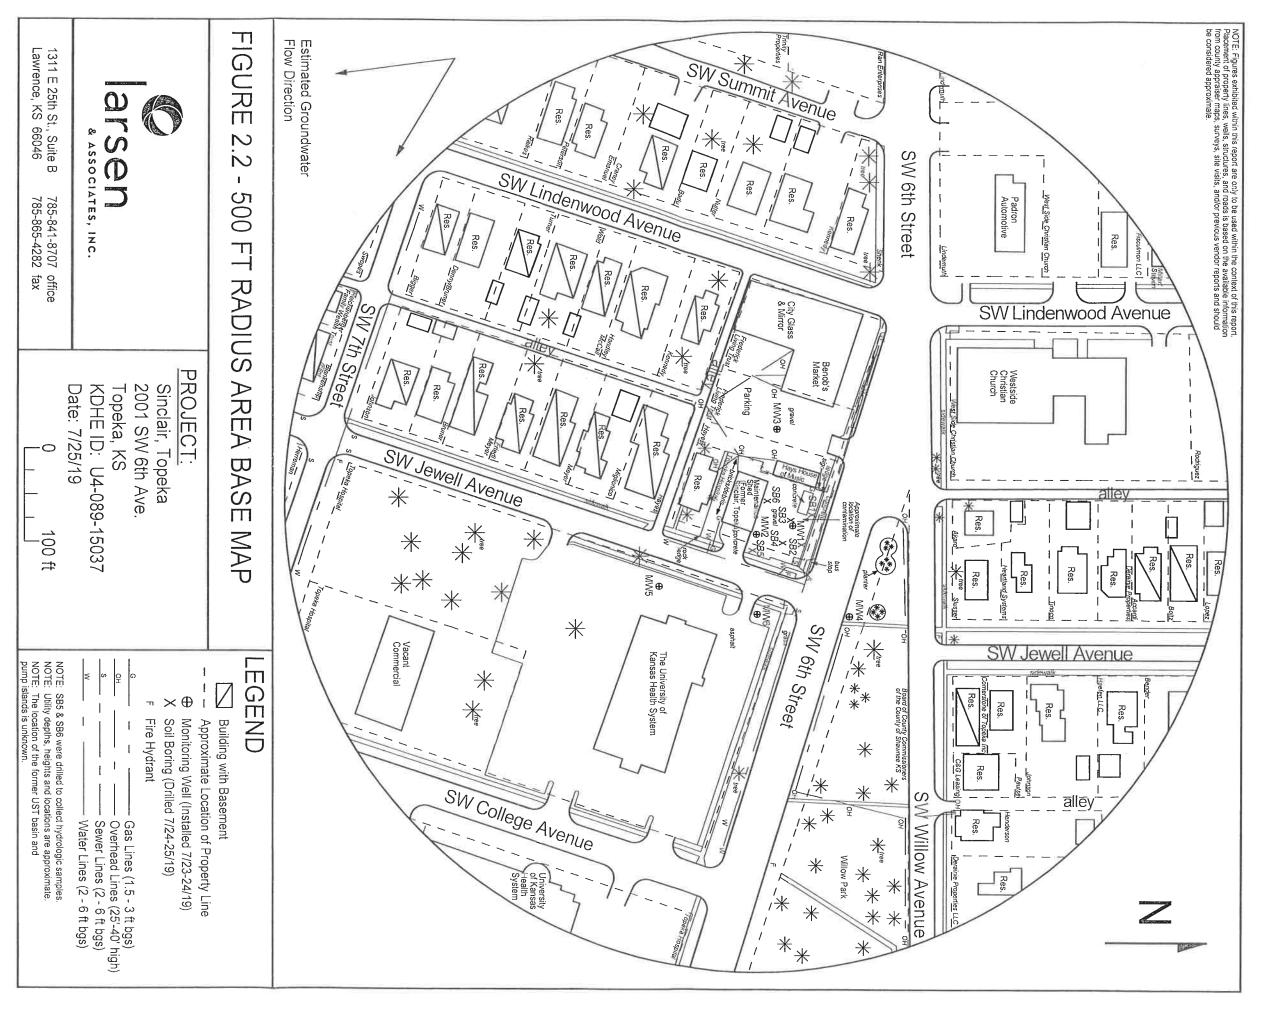

RECEIVED

AUG 2 8-2019

BUREAU OF WATER