
	WELL F		WWC-5			ion of Water			AWS3	
			ge in Well Use			rces App. No.	T. 11 N. 1	Well ID		
1 LOCATION OF WATER WELL:			Fraction	Section Number		Township Number				
	_{y:} Shawnee		1/4 NE 1/4 NE 1/4						6 ■ E □ W	
2 WELL OWNER: Last Name: First: Street or Rural Address where well is located (if unknown, distance an										
		Conoco Food Mart		direction from nearest town or intersection): If at owner's address, ch					check here:	
Address:	2045 N. P	(ansas Ave	ĺ	2045 N.	Kans	sas Ave, To	peka, KS			
City:	Topeka	State: KS	ZIP: 66617							
3 LOCAT		,		25			20.0072			
	4 DEPTH OF COMPLETED W					5 Latitud	e: 38.0873		.(decimal degrees)	
	ON BOX:		Encountered: 1)25 ft.			Longitude: 95.66033 (decimal degrees)				
	N		3) ft., or 4)		li	Horizontal Datum: ☐ WGS 84 ■ NAD 83 ☐ NAD 27				
			TER LEVEL:			Source for Latitude/Longitude:				
'	X		, measured on (mo-day-			GPS (unit make/model:)				
NW	NE		, measured on (mo-day- vater was f			— 7		AAS enabled? ☐ Yes ☐ No) urvey ☐ Topographic Map		
	<u> </u>		s pumping			Land	i Survey ∐ Topogra	ірпіс імар		
W	E		vater was ft.			☐ Online Mapper:				
sw	SE	i	pumping gpm				970.05			
		Estimated Vield:	anm				n: .872.95ft.			
	S	Bore Hole Diameter:	8.25 in to 35	ft. and			Land Survey			
11	mile		in. to	ft.			Other		• • • • • • • • • • • • • • • • • • • •	
7 WELL	WATER TO	D BE USED AS:				-				
1. Domestic	:	5. 🔲 Public Wa	ater Supply: well ID			10. 🔲 Oil F	ield Water Supply: le	ase		
☐ House	hold	Dewatering	ig: how many wells?				le: well ID			
	& Garden		echarge: well ID				d □Uncased □(
☐ Livest		8. Monitorin	g: well ID		•••		mal: how many bores			
2. Irrigat			al Remediation: well II				ed Loop Horizont			
3. Feedlo		Air Sparg		Extraction			Loop Surface Dis			
4. Indust		☐ Recovery					r (specify):			
Was a che	mical/bacte	riological sample subn	nitted to KDHE?	Yes 🔳 1	No I	If yes, date s	ample was submitte	d:		
		? ☐ Yes ☐ No								
8 TYPE C	OF CASING	SUSED: Steel PV	C Other	CA	SINC	G JOINTS:	☐ Glued ☐ Clamped	Welde	d Threaded	
Casing diam	neter2	in to 33 ft. surface -0.5 in	, Diameter	in. to		ft., Diamete	er in. to	ft.		
Casing heigh	ht above land	surface0.5 ir	ı. Weight	lbs.	/ft.	Wall thickne	ss or gauge No. Sch.	40		
TYPE OF		R PERFORATION MA	TERIAL:							
☐ Steel		inless Steel					(Specify)			
☐ Brass			crete tile None v	sed (open	hole)					
		RATION OPENINGS A								
	nuous Slot	Mill Slot G	auze Wrapped	orch Cut [_ Dri	lled Holes [Other (Specify)			
Louve	ered Shutter	☐ Key Punched ☐ W	/ire Wrapped ☐ Sa	w Cut [ne (Open Holo	e)		_	
SCREEN-I	PERFORAT	ED INTERVALS: From	n .ວວ ft. to ວວ	ft., Fro	om	ft. to	ft., From	ft. to	ft.	
GRAVEL PACK INTERVALS: From32 ft. to35 ft., From ft. to ft., From ft. ft. o ft.										
9 GROUT MATERIAL: □ Neat cement □ Cement grout ■ Bentonite □ Other										
Nearest source of possible contamination:										
☐ Septic		☐ Lateral Line ☐ Cess Pool	es ☐ Pit Privy ☐ Sewage La			ivestock Pens		cide Storage oned Water		
	tight Sewer Li			goon		uel Storage ertilizer Storag		ll/Gas Well		
					ш.	crunzer Stora;	ge 🗆 On we	II/Gas Well		
Other (Specify) Trust Fund site U4-089-14545										
10 FROM	TO	LITHOLO		FRON			THO. LOG (cont.) or		G INTERVALS	
0		Concrete		1			(
0.5		Silty Clay, dk grey, me	ed.stiff							
5		Silt, gry to dk gry		—	+					
20		Sand, very fine becon	ning med to cree	 	_					
35		Total Depth	g mod. to orde		-					
	10	Total Doptil								
				Notes						
Notes:										
11 CONT	11 CONTRACTOR'S OR LANDOWNER'S CERTIFICATION: This water well was constructed, reconstructed, or plugged									
under my jurisdiction and was completed on (mo-day-year) 8-16-2017 and this record is true to the best of my knowledge and belief. Kansas Water Well Contractor's License No. 585 This Water Well Record was completed of tho-day-year) 3-16-18 under the business name of Associated Environmental. Inc										
Kansas Wa	ater Well Co	ntractor's License No.	585 This Wa	ater Well	Reco	rd was com	leted ox no-day-v	Zar) 3-16-	18	
under the b	ousiness nam	e of Associated Envir	onmental, Inc.		Sign	nature	ode Il			
Mail	I white copy al	ong with a fee of \$5.00 for ea	ch constructed well to: Kai	ısas Departı	ment of	f Health and En	vironment. Barcau of W	ater, GWTS	Section,	
1000	0 SW Jackson S	St., Suite 420, Topeka, Kansas	66612-1367. Mail one to	Water Well	Owner	r and retain one	for your records. Teleph	one 785-296	-5524.	
Visit us at htt	p://www.kdhck	s.gov/waterwell/index.html		KSA 82a	<u>1-1212</u>	2		Revised	1 7/10/2015	

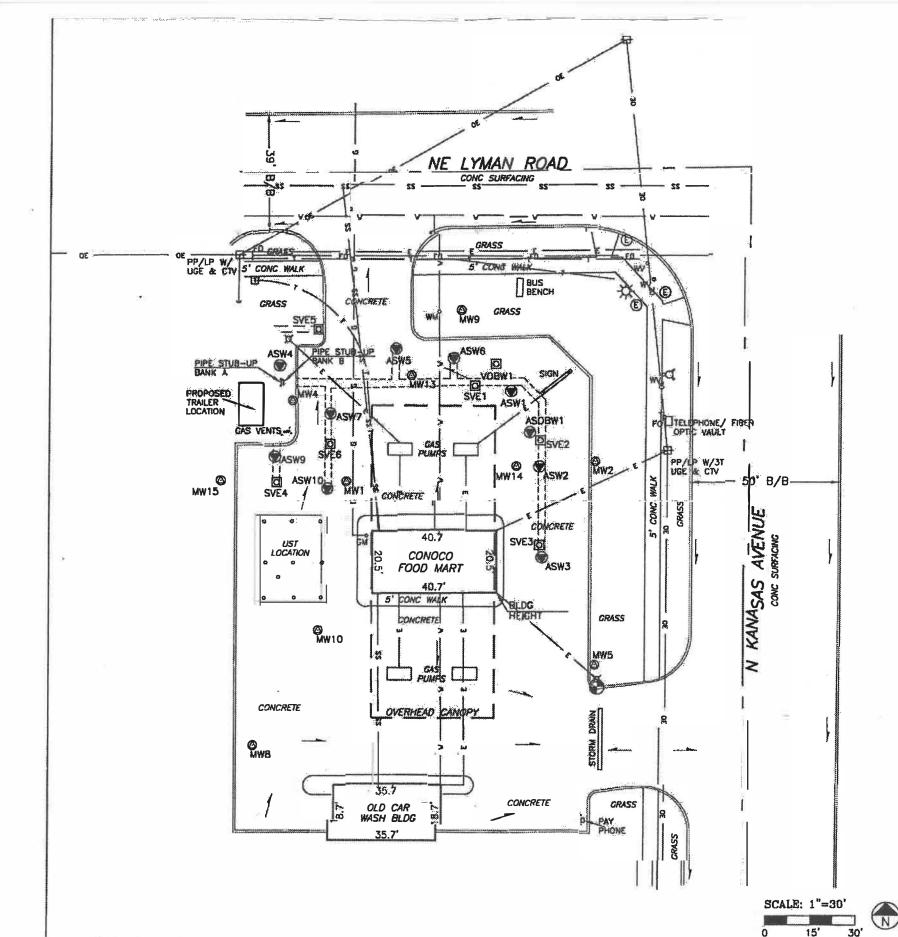

FULL SITE SURVEY

CONOCO FOOD MART

City of Topeka, Shawnee County, Kansas

Point	North Coordinate	Eost Coordinate	Distance SE Cor. North	From Sec. 20 West	* Elev. Top of Rim or PK Noil	Elev. Top of PVC Pipe	Lotitude North	Longitude West
SE Cor.						2 12		
Sec. 20-T11S-R16E	5000	5000					uwa	
Well - M.W	10176.74	2061.80	5176.74	2938.20	873.17	872.70	39,08742	95,66056
Well - M.W 2	10183.14	2143.06	5183.14	2856.94	873.77	873.50	39,08744	95.66027
Well - N.W 4	10203.42	2044,13	5203.42	2955.87	873.43	873.04	39.08749	95.66062
Well - M.W 5	10115.11	2142.81	5116.11	2857,19	873.21	872.84	39,08725	95.86027
Well - M.W B	10089.86	2031.31	5089.86	2955.69	873.11	872.74	39,08718	95.66066
Well - M.W 9	10233,19	2099.68	5233,19	2900.32	873.44	872.99	39.08757	95.66042
Well - N.W 10	10127.57	2052.78	5127.57	2947.22	873.23	872.75	39,08728	95,66059
Well - M.W 11	10177.51	2261.95	5177.51	2738.05	874.05	873.56	39.08742	95,65985
Well - M.W 12	10100.47	2257.05	5100.47	2742.95	873.38	873.09	39.08721	95.65987
Well - M.W. 13	10211.79	2083.28	5211.79	2918.72	873.09	872.78	39.08754	95.66048
Yell - M.W 14	10181.77	2117,44	5181.77	2882.56	873.34	873.06	39.08749	95,66052
Well - M.W 15	10177,15	2020.82	5177.15	2979,18	872.70	B72.42	39.08739	95,56072
Well ASW1	10205.79	2115.65	5206.79	2884.35	873.35	872.86	39.08747	95,66038
Well ASW2	10181.59	2124.97	5181.59	2875.03	873.31	873,11	39.08743	95,66033
Nell - ASW3	10151.57	2125.72	5151,57	2874.28	873.27	872.95	39.08735	95,66033
Hell - ASW4		2039.92	5214.99	2960.08	873,18	872,76	39.08752	95.66063
Well - ASW5	10220.57	2078.16	5220.57	2921.84	872,92	872.70	39.08754	95.66050
Well - ASW6	10217,40	2097.18	5217.40	2902.82	873,16	873.02	39,08753	95,66043
Hell - ASW7	10199.11	2056.60	5199,11	2943.40	872.88	872.57	39,08748	95.86057
Hel - ASW8					survey. Will attempt	to locate o	t another lin	ne.
Kell - ASW9	10184.88	2038.37	5184.88	2961.63	872.89	872.60	39.08744	95.66064
Vell - ASW10	10174.37	2055.63	5174.37	2944,37	873.14	872.86	39.08741	95,66058
Vell - ASOBW1	10193.24	2121.87	5193.24	2878,13	873.42	873.03	39.08736	95,66043
Hell - SVE1	10208.27	2104,21	5208.27	2895.79	873,30	872.94	39.08746	95,66041
Hell - SVE2	10190.22	2125.23	5190.22	2874.77	873.43	873.15	39.08746	95.66033
Nell - SVE3		2124.89	5155.60	2875.11	873.31	873.12	39.08736	95,68033
Yell - SVE4	10175.40	2039.01	5175.40	2960.99	872.97	872.65	39.08742	95.66064
Well - SVE5		2052.56	5226.90	2947.44	873.06	872.66	39.08756	95,66059
Well - SVE6		2055.53	5189.07	2943,47	873.04	B72.69	39.08745	95.66057
rell - VOBW1	10215.59	2110.77	5215.69	2889.23	873.31	873.00	39.08748	95,66039
Site B.M.	10108,93	2143.68	5108.93	2856.34	B.M. Elev. =			

Description: "" Square cut on back of curb on north side of east drive.

LEGE	END
- Site Bench Mork WW10 - Monitoring Well SVE10 - Soil Vapor Extraction Well VOBW10 - Vapor Observation Well ASW10 - Air Sparge Well ASOBW10 - Air Sparge Observation Well PP/LP W/ - Power Pole/Light Pole w/	GMo - Gos Meter [1] - Telephone Pedestal Fo - Fiber Optic Locator Sign - Bollard - Droinage Direction Overhead Power Line E - Underground Electric Line
UGE & CTV PP/LP W/3T	
WMo - Water Meter Wo - Water Valve O - Fire Hydrant	CML

Tim Slotin, P President SVI

42018 Anderson Avenue, Suite 2 • Manhottan, Kansas 66503 (785) 776-0541 • FAX 776-9760 • Emoil: tim@siconandmeler.com Project #1711MN1334 DD #108