
			W W C-5		esources App.			W-II ID	AWS4	
			ge in Well Use					Well ID	27 1	
1 LOCATION OF WATER WELL: County: Shawnee			Fraction	Section Numb	ber	Township Number		ige Number		
			1/4 NE 1/4 NE 1/4	NE 1/4 NE 1/4 NW/4 20			T 11 S		6 ■ E 🗆 W	
2 WELL OWNER: Last Name: First: Street or Rural Address where well is located (if unknown, dista										
		Conoco Food Mart		direction fro	ection from nearest town or intersection): If at owne				check here:	
Address: 2045 N. Kansas Ave				2045 N. Kansas Avo.			oneka KS			
Address:		gu . VC	7ID: 00047	2045 N. Kansas Ave, Topeka, KS						
City: Topeka State: KS ZIP: 66617										
3 LOCATE WELL 4 DEPTH OF COMPLETED WELL:35 ft.						itude	38.08752		(decimal degrees)	
WITH A IN Denth(a) Groundwater Encountered: 1) 25 th 1 1 1 05 66063								(decimal degrees)		
	ON BOX:		3) ft., or 4)	Lon	Horizontal Datum: WGS 84 NAD 83 NAD 27					
'	N	WELL'S STATIC WA				Source for Latitude/Longitude:				
below land surface, measured on (mo-day-yr)								,		
, NAV.	NE	above land surface								
NW	NE	Pump test data: Well v			1					
w	E		s pumping			■ Land Survey □ Topographic Map □ Online Mapper:				
'	1 ' 1		vater was						***************************************	
SW	SE		s pumping							
	1 1 1	Estimated Vield:	anm .	6 Elev	vatio	ı: .872.76ft. [☐ Ground	Level 🔣 TOC		
	S	Bore Hole Diameter:	8.25 in to 35	25 in. to			Land Survey GF			
	mile	Bote Hote Diameter	in. to	ft				ther		
		O BE USED AS:		11.						
			ater Supply: well ID		10 🗖	Oil E:	ald Water Commission 1	10		
1. Domestic			iter Supply: well ID				eld Water Supply: leas			
_	enoia & Garden						: well ID			
☐ Lawn		7. Aquiter R	echarge: well ID		12 0-1		Uncased Ge			
		6. Monitorin	al Remediation: well I	D ASW4			ial: how many bores?			
2. ☐ Irrigat 3. ☐ Feedlo										
4. Indust		Air Sparg			b) Open Loop ☐ Surface Discharge ☐ Inj. of Water 13. ☐ Other (specify):					
		☐ Recovery								
Was a che	mical/bacte	riological sample subn	nitted to KDHE? 🔲	Yes 🔳 N	o If yes, da	ate sa	mple was submitted:			
Water well	disinfected	? □ Yes □ No								
8 TYPE (DE CASINO	G USED: ☐ Steel ■ PV	C Other	CA	SING JOINT	`S: F	Glued Clamped	□ Welde	d Threaded	
Casing diam	neter 2	in to 33 ft	Diameter	in to	ft Dis	meter	in to	fr	i i i i i i i i i i i i i i i i i i i	
Casing heigh	ht above land	in. to 33 ft., surface0.5 ir	Weight	lbs/	ft. Wall thi	cknes	s or gauge No. Sch. 4	0		
		R PERFORATION MA			tt. Wall till	Cidios	s of gauge 110			
Steel		inless Steel Fiber			ПС	ther (Specify)			
Brass		vanized Steel		used (open l		thei (specify)			
		RATION OPENINGS A		ised (open i	ioic)					
				amah Cut E	I Daille d IIIala		Oth (C: £.)			
	nuous Slot		auze wrapped	oren Cut L	Drifted Hole	S 📙	Other (Specify)	• • • • • • • • • • • • • • • • • • • •		
	ered Shutter	☐ Key Punched ☐ W ED INTERVALS: From	are wrapped \square Si	aw Cut L	None (Open	Hole				
SCREEN-I	PERFORAT	ED INTERVALS: From	ກ .ວວ - ວຣ	ft., Fro	n tt.	to	ft., From	ft. to	ft.	
GRAVEL PACK INTERVALS: From										
9 GROUT MATERIAL: Neat cement Cement grout Bentonite Other										
Grout Intervals: From										
Nearest source of possible contamination:										
☐ Septic	☐ Septic Tank ☐ Lateral Lines ☐ Pit Privy ☐ Livestock Pens ☐ Insecticide Storage									
☐ Sewer Lines ☐ Cess Pool ☐ Sewage Lagoon ☐ Fuel Storage ☐ Abandoned Water Well										
☐ Watertight Sewer Lines ☐ Scepage Pit ☐ Feedyard ☐ Fertilizer Storage ☐ Oil Well/Gas Well										
Other (Specify) Trust Fund site U4-089-14545										
Direction from well? On-site Distance from well? 0 ft.										
10 FROM	TO	LITHOLO	GIC LOG	FROM	TO	LIT	THO. LOG (cont.) or P	LUGGIN	G INTERVALS	
0	1	Grass/Topsoil								
1	+	Silty Clay, dk grey, me	ed.stiff							
4.5		Silt, gry to dk gry				1				
20		Sand, very fine becom	ning med to cree				***************************************		-	
35	TD	Total Depth	my mou. to crae			+-				
33	וט	rotal Depth								
				D.T.						
Notes:										
11 CONTRACTOR'S OR LANDOWNER'S CERTIFICATION: This water well was constructed, reconstructed, or plugged under my jurisdiction and was completed on (mo-day-year) 8-16-2017 and this record is true to the best of my knowledge and belief. Kansas Water Well Contractor's License No. 585 This Water Well Record was completed of mo bayyear) 3-16-18										
under my j	urisdiction a	and was completed on (n	<u>no-</u> day-year) .8 . .162	Q1.7 a	nd this record	l is tr	ue to the best of my	knowled	ge and belief.	
Kansas Wa	ater Well Co	ntractor's License No. 5	0,0,5, This W	ater Well I	Record was c	omp	eted of moday yea	r) 3-16-	າຸຮຸ	
under the b	ousiness nam	ne of Associated Envir	onmental, Inc		Signature	.DA	and the same			
		ong with a fee of \$5.00 for each								
		St., Suite 420, Topeka, Kansas	66612-1367. Mail one to			one fo	or your records. Telephon			
Visit us at htt	p://www.kdhek	s.gov/waterwell/index.html		KSA 82a-	1212			Revised	7/10/2015	

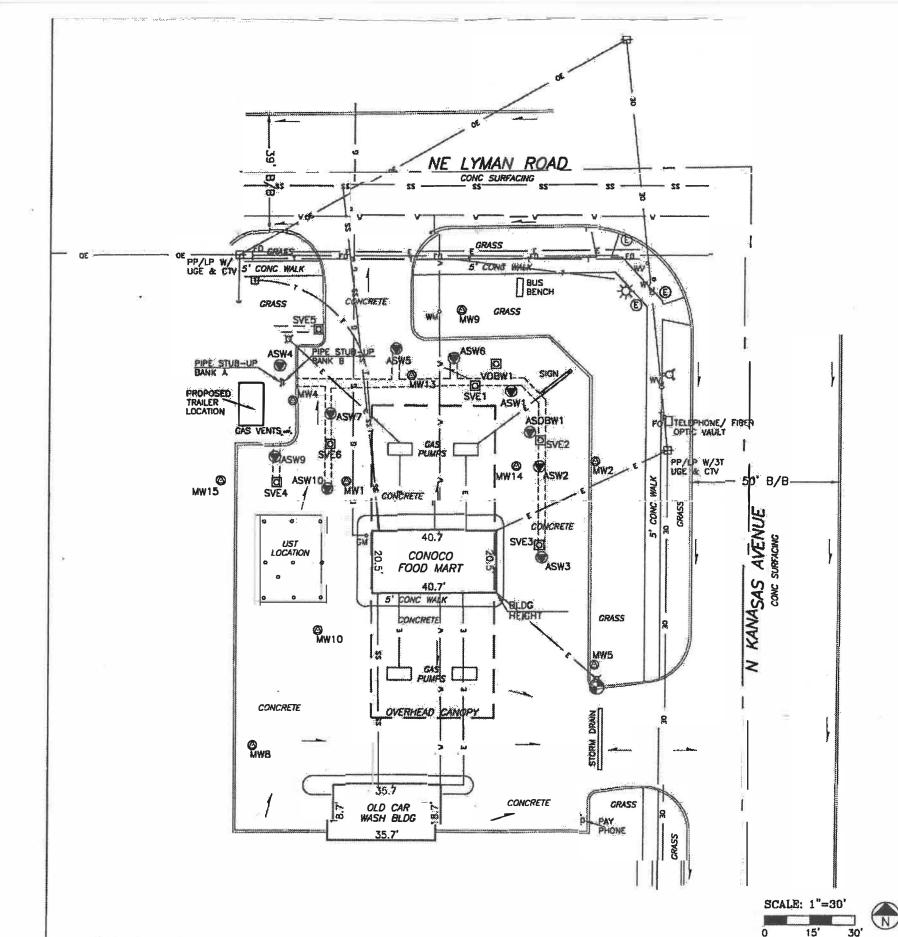

FULL SITE SURVEY

CONOCO FOOD MART

City of Topeka, Shawnee County, Kansas

Point	North Coordinate	Eost Coordinate	Distance SE Cor. North	From Sec. 20 West	* Elev. Top of Rim or PK Noil	Elev. Top of PVC Pipe	Lotitude North	Longitude West
SE Cor.						8 18		
Sec. 20-T11S-R16E	5000	5000					uwa	
Well - M.W	10176.74	2061.80	5176.74	2938.20	873.17	872.70	39,08742	95,66056
Well - M.W 2	10183.14	2143.06	5183.14	2856.94	873.77	873.50	39,08744	95.66027
Well - N.W 4	10203.42	2044,13	5203.42	2955.87	873.43	873.04	39.08749	95.66062
Well - M.W 5	10115.11	2142.81	5116.11	2857,19	873.21	872.84	39,08725	95.86027
Well - M.W B	10089.86	2031.31	5089.86	2955.69	873.11	872.74	39,08718	95.66066
Well - M.W 9	10233,19	2099.68	5233,19	2900.32	873.44	872.99	39.08757	95.66042
Well - N.W 10	10127.57	2052.78	5127.57	2947.22	873.23	872.75	39.08728	95,66059
Well - M.W 11	10177.51	2261.95	5177.51	2738.05	874.05	873.56	39.08742	95,65985
Well - M.W 12	10100.47	2257.05	5100.47	2742.95	873.38	873.09	39.08721	95.65987
Well - M.W. 13	10211.79	2083.28	5211.79	2918.72	873.09	872.78	39.08754	95.66048
Yell - M.W 14	10181.77	2117,44	5181.77	2882.56	873.34	873.06	39.08749	95,66052
Well - M.W 15	10177,15	2020.82	5177.15	2979,18	872.70	B72.42	39.08739	95,56072
Well ASW1	10205.79	2115.65	5206.79	2884.35	873.35	872.86	39.08747	95,66038
Well ASW2	10181.59	2124.97	5181.59	2875.03	873.31	873,11	39.08743	95,66033
Nell - ASW3	10151.57	2125.72	5151,57	2874.28	873.27	872.95	39.08735	95,66033
Hell - ASW4		2039.92	5214.99	2960.08	873,18	872,76	39.08752	95.66063
Well - ASW5	10220.57	2078.16	5220.57	2921.84	872,92	872.70	39.08754	95.66050
Well - ASW6	10217,40	2097.18	5217.40	2902.82	873,16	873.02	39,08753	95,66043
Hell - ASW7	10199.11	2056.60	5199,11	2943.40	872.88	872.57	39,08748	95.86057
Hel - ASW8					survey. Will attempt	to locate o	t another lin	ne.
Kell - ASW9	10184.88	2038.37	5184.88	2961.63	872.89	872.60	39.08744	95.66064
Vell - ASW10	10174.37	2055.63	5174.37	2944,37	873.14	872.86	39.08741	95,66058
Vell - ASOBW1	10193.24	2121.87	5193.24	2878,13	873.42	873.03	39.08736	95,66043
Hell - SVE1	10208.27	2104.21	5208.27	2895.79	873,30	872.94	39.08746	95,66041
Hell - SVE2	10190.22	2125.23	5190.22	2874.77	873.43	873.15	39.08746	95.66033
Nell - SVE3		2124.89	5155.60	2875.11	873.31	873.12	39.08736	95,68033
Yell - SVE4	10175.40	2039.01	5175.40	2960.99	872.97	872.65	39.08742	95.66064
Well - SVE5		2052.56	5226.90	2947.44	873.06	872.66	39.08756	95,66059
Well - SVE6		2055.53	5189.07	2943,47	873.04	B72.69	39.08745	95.66057
rell - VOBW1	10215.59	2110.77	5215.69	2889.23	873.31	873.00	39.08748	95,66039
Site B.M.	10108,93	2143.68	5108.93	2856.34	B.M. Elev. =			

Description: "" Square cut on back of curb on north side of east drive.

LEGE	END
- Site Bench Mork WW10 - Monitoring Well SVE10 - Soil Vapor Extraction Well VOBW10 - Vapor Observation Well ASW10 - Air Sparge Well ASOBW10 - Air Sparge Observation Well PP/LP W/ - Power Pole/Light Pole w/	GMo - Gos Meter [1] - Telephone Pedestal Fo - Fiber Optic Locator Sign - Bollard - Droinage Direction Overhead Power Line E - Underground Electric Line
UGE & CTV PP/LP W/3T	
WMo - Water Meter Wo - Water Valve O - Fire Hydrant	CML

Tim Slotin, P President SVI

42018 Anderson Avenue, Suite 2 • Manhottan, Kansas 66503 (785) 776-0541 • FAX 776-9760 • Emoil: tim@siconandmeler.com Project #1711MN1334 DD #108