
WAILK			m wwc-5				ion of Water		,,,	ell ID	AWS5	
Original F			hange in Well U	se			rces App. No.			_	N71	
		ATER WELL:	Fraction	- 17 - 1- 1		secti	on Number	Township N			ge Number	
County:	Shawnee		½ N	E 1/4 NE 1/	E ¼ NW/4 20 T 11 S R 16 ■ E							
2 WELL OWNER: Last Name: Street or Rural Address where well is located (if unknown, distance and												
	Topeka Co			direction from nearest town or intersection): If at owner's address, chec					check here:			
	2045 N. K			2045 N. Kansas Ave. Topoka KS								
Address: 2045 N. Kansas Ave, Topeka, KS												
City: Topeka State; KS ZIP: 66617												
3 LOCATE		4 DEPTH OF C	COMPLETE	WELL:	35	ft.	5 Latitud	e:38.0	8754		(decimal degrees)	
WITH "X"		Depth(s) Groundw	ater Encountere	1· 1)	25 n		Langitu	da: 95	66050		(decimal degrees)	
	SECTION BOX: Depth(s) Groundwater Encountered: 1)											
								83 LI NAD 21				
WELL'S STATIC WATER LEVEL:								,				
1 1 1	l' l											
NW	- NE	Pump test data: W				• • • • •	■ I on				10)	
			nours pumping				Lan	d Survey	pograpni	c Map		
W	E	u u	ell water was	• • • • • • • • • • • • • • • • • • • •	ft			me Mapper:	• • • • • • • • • • • •			
SW	- SE		hours pumping									
	1	I =					6 Elevation	n: 872.70	ft. 🔲	Ground	Level TOC	
S		Bore Hole Diamet	er: 8.25 in	gpm 8.25 in. to35 ft. and				Land Survey				
1 mil	lel	Dore Hole Diamet	in	in. to ft.				Other				
'		BE USED AS:					l					
	AILKIU		c Water Supply:	mall ID			10 🗆 🔾	ield Water Supp	lve lasse			
1. Domestic:	1.3						10. \square Oil I	le: well ID	iy. iease	• • • • • • • • • • • • • • • • • • • •	***************************************	
☐ Househo			itering: how ma					d Uncased				
Lawn &			fer Recharge: w				_		_			
Livestoc			toring: well ID nental Remedia					mal: how many				
2. Irrigation	n					•••		ed Loop				
3. Feedlot		■ Air S			Extraction			n Loop Surfac				
4. 🗌 Industria		Reco	-	Injection				r (specify):				
Was a chem	ical/bacter	iological sample s	ubmitted to K	DHE?	Yes 🔳 N	lo :	If yes, date s	ample was subi	nitted:			
		☐ Yes ☐ No										
8 TYPE OF	CASING	IISED: □ Steel	PVC. Other	·	CA	SIN	G JOINTS:	□ Glued □ Cla	mped [Welde	d Threaded	
Casing diamet	er 2	in to 33	ft Diameter		in to		ft Diamet	er in	to	ft	- Imoudoc	
Casing height	above land	in. to 33 surface -0.5	in Weigh	nt	lbs /	ft	Wall thickne	ess or gauge No	Sch. 40)		
TVDE OF SC	PEEN OF	PERFORATION	MATERIAI ·				Will tillettil	soo or gauge ito.	• • • • • • • • • • • • • • • • • • • •	••••••		
☐ Steel			Fiberglass	■ PVC			□ Other	(Specify)				
Brass		anized Steel			used (open	(مامد		(Specify)	• • • • • • • • • • • • • • • • • • • •	• • • • • • • • • • • • • • • • • • • •		
		ATION OPENING		LI None	useu (open	1010)						
1					S1- C [٠	11 4 TT-1 F	7 04 (0	,			
Continu		Mill Slot	☐ Gauze wrapp)eq	oren Cut	ווע ב דע ב	illed Holes [Other (Specify	')			
Louvere	ed Shutter	☐ Key Punched	□ wire wrappe	a ∐s	aw Cut L	_ NO	ne (Open Hoi	e)		٠.	•	
SCREEN-PE	REORATI	ED INTERVALS:	- 33	n. to	π., Fro	m	ft. to .	ft., Fror	n	ft. to	ft.	
		CK INTERVALS:						ft., Froi	m	ft. to	ft.	
9 GROUT N	MATERI <i>A</i>	L: Neat cement	Cement gr	out 🔳 B	entonite [Otl	her					
Grout Intervals: From												
Nearest source of possible contamination:												
☐ Septic Tank ☐ Lateral Lines ☐ Pit Privy ☐ Livestock Pens ☐ Insecticide Storage												
☐ Sewer Li		Cess P	ool 🗆	Sewage L			uel Storage		bandoneo	l Water	Well	
☐ Watertight Sewer Lines ☐ Scepage Pit ☐ Feedyard ☐ Fertilizer Storage ☐ Oil Well/Gas Well												
■ Other (Specify) Trust.Fund site U4-089-14545												
Direction from well? On-site Distance from well? O ft.												
10 FROM	TO		LOGIC LOG		FROM			ITHO. LOG (cor		UGGIN	G INTERVALS	
0 0	.5 (Concrete										
		Silty Clay, dk grey	med stiff									
		Silt, gry to dk gry	,									
		Sand, very fine be	coming mod	to orce	-	+	<u></u>					
			coming med.	เบเรย		-			 			
35 T	D 1	otal Depth										
Notes:												
11 CONTRACTOR'S OR LANDOWNER'S CERTIFICATION: This water well was constructed, reconstructed, or plugged												
under my inr	isdiction at	nd was completed of	on (mo-day-yea	ır) 8-16-2	2017 a	nd th	nis record is	true to the best	of my k	nowled	ge and helief	
Kansas Wate	r Well Cor	itractor's License N	_{Io.} 585	This W	ater Well	Reco	rd was com	leted (mold	ay-Vear	3-16-	18	
under my jurisdiction and was completed on (mo-day-year) 8-16-2017 and this record is true to the best of my knowledge and belief. Kansas Water Well Contractor's License No. 585 This Water Well Record was completed (mo) day fear) 3-16-18 under the business name of Associated Environmental, Inc												
Mail Ly	white copy alo	ng with a fee of \$5.00 f	or each constructe	d well to: K	ansas Departn	ient o	f Health and Er	vironment, Bureau	of Water	GWTS S	Section,	
	Mail I white copy along with a fee of \$5.00 for each constructed well to: Kansas Department of Health and Environment Bureau of Water, GWTS Section, 1000 SW Jackson St., Suite 420, Topeka, Kansas 66612-1367. Mail one to Water Well Owner and retain one for your records. Telephone 785-296-5524.											
		., Suite 420, Topeka. K	ansas 66612-1367.	Mail one to	Water Well	Owne	r and retain one	for your records. 1	[elephone]	785-296-	-5524.	

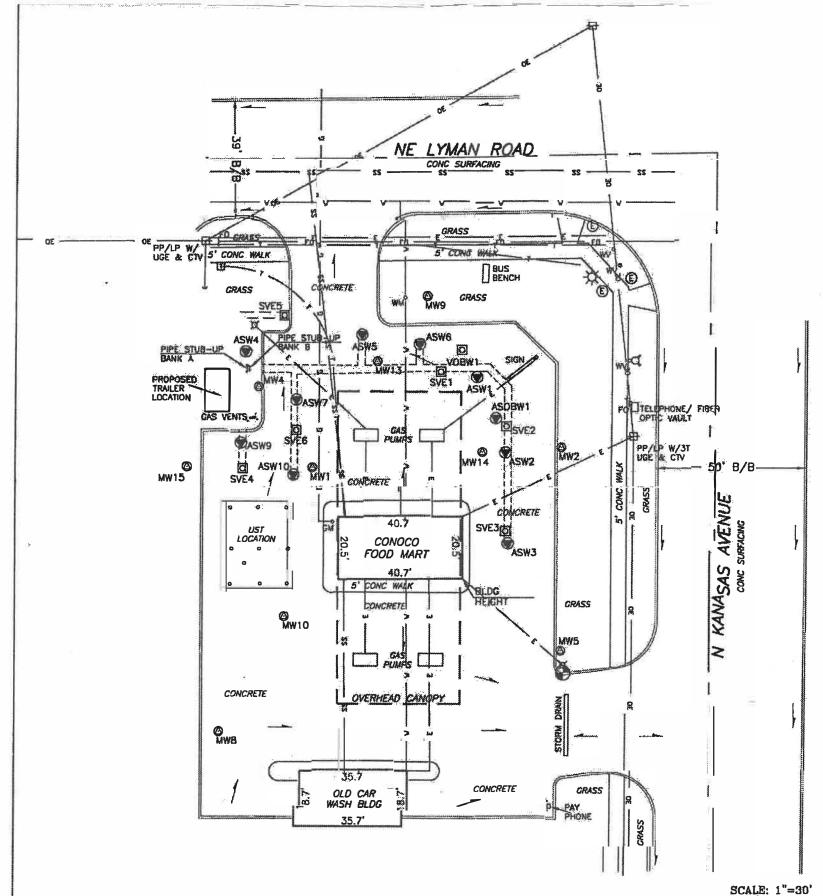

FULL SITE SURVEY

CONOCO FOOD MART

City of Topeka, Shawnee County, Kansas

Point	North Coordinate	Eost Coordinate	Distance SE Cor. North	From Sec. 20 West	* Elev. Top of Rim or PK Noil	Elev. Top of PVC Pipe	Lotitude North	Longitud West
SE Cor. Sec. 20-T11S-R16E	5000	5000						
Well - N.W	10176.74	2061.80	5176.74	2938.20	873.17	872.70	39,08742	95,66056
Well - M.W 2	10163.14	2143.06	5183.14	2856.94	873.77	873.50	39,08744	95.66027
Well - M.W 4	10203.42		5203,42	2955.87	873.43	873.04	39.08749	95.66062
Well - M.W 5	10115.11		5116,11	2857,19	873.21	872.84	39,08725	95,86027
Well - M.W B	10089.86	2031.31	5089.86	2988.69	873.11	872.74	39,08718	95.66066
Well - M.W 9	10233,19	2099.68	5233,19	2900.32	873.44	872.99	39.08757	95.66042
Well - M.W 10	10127.57	2052.78	5127.57	2947.22	873.23	872.75	39.08728	95,66059
Well - M.W 11	10177.51	2261.95	5177.51	2738.05	874.05	873.56	39.08742	95.65985
Well - M.W 12	10100.47		5100,47	2742.95	873.38	873.09	39.08721	95,65987
Well M.W. 13	10211.79	2083.28	5211.79	2916.72	873.09	872.78	39.08754	95,66048
Yell - M.W 14			5181.77	2882.56	873.34	873.06	39.08749	95,66052
Vell - M.W 15	10177.15		5177.15	2979.18	872.70	B72.42	39,08739	95,56072
Vell - ASW1	10205.79	2115.65	5206.79	2884.35	873.35	872.86	39.08747	95,66038
Hell - ASW2	10181.59		5181.59	2875.03	873.31	873,11	39.08743	95,66033
Vell - ASW3			5151.57	2874.28	873.27	872.95	39.08735	95,66033
Vell - ASW4		2039.92	5214.99	2960.08	873.18	872.76	39.08752	95.66063
Vell - ASW5	10220.57		5220.57	2921.84	872,92	872.70	39.08754	95.66050
Yell - ASW6	10217.40		5217.40	2902.82	873,16	873.02	39.08753	95,66043
Yell - ASW7	10199.11	2056,60	5 99.11	2943.40	872.88	872.57	39.08748	95.66057
Yell - ASW8	Well ASW8				urvey. Will ottemp			
Yell - ASW9	10184.88	2038.37	5184.88	2961.63	872.89	872.50	39.08744	95.66064
Vell - ASW10	10174.37		5174,37	2944.37	873.14	872.86	39,08741	95,68058
ell - ASOBW1			5193.24	2878.13	873.42	873,03	39.08736	95,66043
vell - SVE1	10208.27		5208.27	2895.79	873,30	872.94	39.08746	95,66041
Yell - SVE2	10190.22		5190.22	2874.77	873.43	873.15	39.08746	95,66033
vell - SVE3			5155.60	2875.11	873.31	873.12	39.08736	95,58033
rell - SVE4	10175,40		5176,40	2960.99	872.97	872.66	39.08742	95,66064
Yell - SVE5			5226.90	2947.44	873.06	872.66	39.08756	95,56059
rell - SVE6	10189.07		5189.07	2943.47	873.04	872.69	39,08745	95,66057
Yell - VOBW1	10215.59	2110,77	5215.69	2889.23	873.31	873.00	39.08748	95,66039
ite B.M.	10108,93		5108.93	2856.34	B.M. Elev.			

Description: "" Square cut on back of curb on north side of east drive.

LEGE	END
- Site Bench Mork WW10 - Monitoring Well SVE10 - Soil Vapor Extraction Well VOBW10 - Vapor Observation Well ASW10 - Air Sporge Well ASOBW10 - Air Sporge Observation Well PP/LP W/ - Power Pole/Light Pole w/	GMo - Gos Meter [7] - Telephone Pedestol FO - Fiber Optic Locator Sign - Bollard - Droinage Direction Overhead Power Line - Underground Electric Line
UGE & CTV PP/LP W/31	
Traffic Signal Light WMo - Water Meter Wo - Water Valve O - Fire Hydrant	CML

42018 Anderson Avenue, Suite 2 .

Project #1711MN1334

(785) 776-0541 • FAX 776-9760 • Emoil: tim@stoonandmeier.com

DD #108

