
		RECORD		WWC-5			ivision of Wate			ell ID	AWS8	
		Correction		e in Well Use Fraction			sources App. N			, 	ge Number	
1 LOCATION OF WATER WELL: Fraction County: Shawnee						Section Number Township Number Range Number E 1/4 NW/4 20 T 11 S R 16 E W						
				First:	Ť		ural Address	where well is loc				
	2 WELL OWNER: Last Name: First: Business: Topeka Conoco Food Mart							intersection): If at o	•		1	
Address: 2045 N. Kansas Ave												
Address: City: Topeka State: KS ZIP: 66617						2045 N. Kansas Ave, Topeka, KS						
3 LOCAT	Topeka F WELL			1								
WITH "		4 DEPTH	I OF CON	IPLETED WI	ELL:	.:35 ft. 5 Latitude:38.08748						
SECTIO	N BOX:	Depth(s) G	roundwater	Encountered: 1) (ft. □ Der: Wall		Longitude: 95.66057 (decimal degrees)				
1	2)											
	below land surface, measured on (mo							PS (unit make/mod)	
NW	1 - 1	1 . —		, measured on (r		• /	~	(WAAS enabled				
		1 ^		vater was		ft. Land Survey Topographic Map			,			
W	E	after	after hours pumping				gpm Online Mapper:Google Latti			ai II I		
sw	SE	Well water was										
	Estimated Viald: gnm						6 Elevation: .880				Level ☐ TOC	
	S Bore Hole Diameter:gpiiigpiiigpiii			8.25 in to	35	5 ft. and Survey ☐ G ☐ Other Google Ear			□ GPS	□ То	pographic Map	
1 r	 			in. to				Other	E Laiiii			
[O BE USED					🗆					
1. Domestic				iter Supply: wel				l Field Water Supp				
_	noid & Garden			ig: how many w echarge: well II				Test Hole: well ID ☐ Cased ☐ Uncased ☐ Geotechnical ☐ Cased ☐ Uncased ☐ Geotechnical				
Livesto				g: well ID								
2. Irrigati		9. E	nvironment	al Remediation:	well I	D ASW8	a) Cl	osed Loop				
3. Teedlo			Air Sparg			por Extraction b) Open Loop Surface Discharge Inj. of W						
4. 🔲 Industr	rial] Recovery	☐ Injec	ction		13. 🔲 Ot	her (specify):	• • • • • • • • • • • • • • • • • • • •	• • • • • • • • • • • • • • • • • • • •		
Was a chemical/bacteriological sample submitted to KDHE?												
		? 🗌 Yes 🔲					 					
8 TYPE C	OF CASING	GUSED: 🗆 S	Steel 📕 PV	C Other	• • • • • • • •	CAS	ING JOINTS	: Glued Cla	.mped 🔲	Welded	Threaded	
Casing diam	ieter	in. to	ft., -0.5 :	, Diameter	• • • • • • • • • • • • • • • • • • • •	in. to	ft., Diam	neterin. ness or gauge No.	to Sch 40	ft.		
TVDE OF	nt above land	SUTTACE R PERFORA	TION MA	ı. weigni	• • • • • • • • • •	10S./II	. wan inick	ness or gauge No.	9911.79			
☐ Steel		inless Steel			PVC		□ Oth	er (Specify)				
☐ Brass		vanized Steel	☐ Conc			used (open ho		er (opecity)				
SCREEN O		RATION OPE	ENINGS A				,					
	nuous Slot	Mill Slot		auze Wrapped	□ T	orch Cut 🔲	Drilled Holes	☐ Other (Specify	[,])			
Louve	ered Shutter	☐ Key Punc	hed W	Vire Wrapped	□S	aw Cut 🔲	None (Open H	ole)				
SCREEN-I	PERFORAT	ED INTERV	ALS: From	n .33 ft. to	35 	ft., From	ft. to	ft., Fro	m	ft. to	ft.	
GRAVEL PACK INTERVALS: From												
9 GROUT MATERIAL: ☐ Neat cement ☐ Cement grout ☐ Bentonite ☐ Other												
Grout Intervals: From												
☐ Septic			Lateral Line	es 🔲 Pit	Privy		Livestock Pe	ns 🔲 In	secticide	Storage		
☐ Sewer	Lines		Cess Pool	☐ Sev			☐ Fuel Storage	□ A	bandoned	Water V	Well	
	☐ Watertight Sewer Lines ☐ Seepage Pit ☐ Feedyard ☐ Fertilizer Storage ☐ Oil Well/Gas Well											
■ Other (Specify) Trust Fund site U4-089-14545												
10 FROM	TO TO		LITHOLO		nom v	FROM		LITHO. LOG (cor		IGGIN	TINTERVALS	
0	 	Concrete	LITIOLO	GAC LOG		1 KOW	10	Lillo, Log (col	16.) ULI L	COOM	2 II I LIK V ALS	
0.5		Silty Clay, di	k grev me	ed.stiff								
4.5		Silt, gry to d										
20				ning med. to d	crse							
35		Total Depth										
	Notes:											
11 CONTRACTOR'S OR LANDOWNER'S CERTIFICATION: This water well was constructed, reconstructed, or plugged												
11 CONT	KACTOR'	S OR LAND	UWNER'	S CERTIFIC	ATIO 3-17-2	N: This wa	ter well was	constructed,	reconst	ructed,	or i plugged	
Kansas Wa	iter Well Co	ntractor's Lie	ense No.	585 T	his W	ater Well R	ecord was cor	s true to the best	av-vear)	3-16-1	8	
under the b	usiness nam	ne of Associa	ated Envir	onmental, Inc	<u> </u>		Signature	Environment, Bureau	<u> </u>	<u></u>		
Mail	l white copy al	long with a fee of	\$5.00 for <u>ea</u>	ch constructed wel	l to: Ka	ınsas Departme	nt of Health and	Environpheny, Bureau	of Water,	GWTS S	ection,	
				66612-1367. Mai	il one to			ne for your records.				
Visit us at htt	p://www.kdhek	s.gov/waterwell/	index.html			KSA 82a-	1414		ŀ	<u>cevised</u>	7/10/2015	

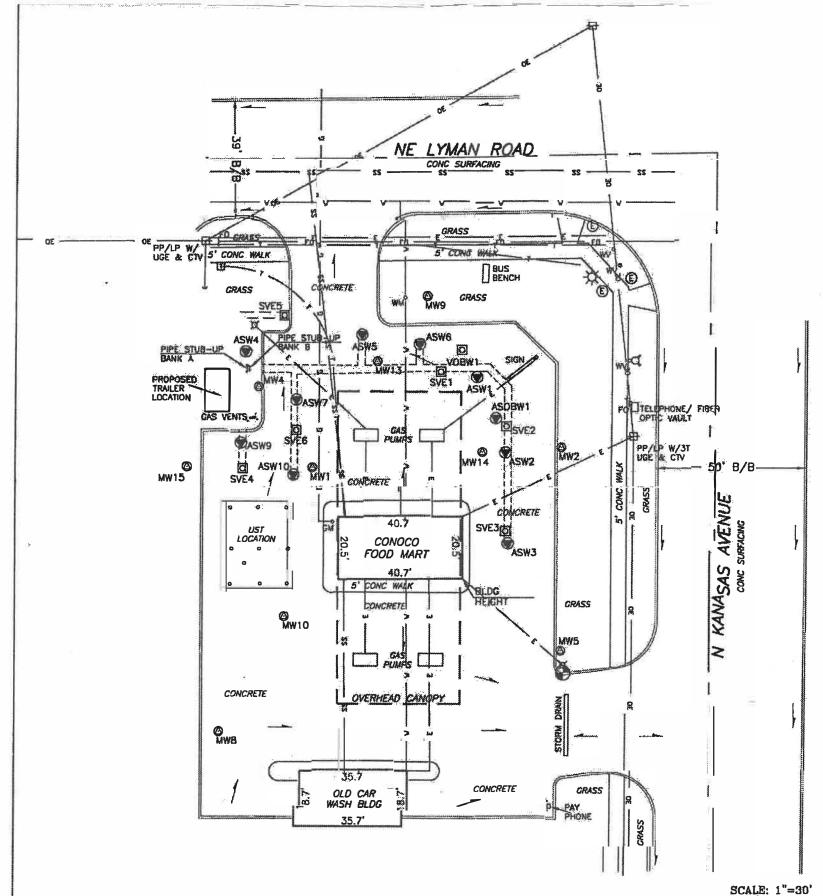

FULL SITE SURVEY

CONOCO FOOD MART

City of Topeka, Shawnee County, Kansas

Point	North Coordinate	Eost Coordinate	Distance SE Cor. North	From Sec. 20 West	* Elev. Top of Rim or PK Noil	Elev. Top of PVC Pipe	Lotitude North	Longitud West
SE Cor. Sec. 20-T11S-R16E	5000	5000						
Well - N.W	10176.74	2061.80	5176.74	2938.20	873.17	872.70	39,08742	95,66056
Well - M.W 2	10163.14	2143.06	5183.14	2856.94	873.77	873.50	39,08744	95.66027
Well - M.W 4	10203.42		5203,42	2955.87	873.43	873.04	39.08749	95.66062
Well - M.W 5	10115.11		5116,11	2857,19	873.21	872.84	39,08725	95,86027
Well - M.W B	10089.86	2031.31	5089.86	2988.69	873.11	872.74	39,08718	95.66066
Well - M.W 9	10233,19	2099.68	5233,19	2900.32	873.44	872.99	39.08757	95.66042
Well - M.W 10	10127.57	2052.78	5127.57	2947.22	873.23	872.75	39.08728	95,66059
Well - M.W 11	10177.51	2261.95	5177.51	2738.05	874.05	873.56	39.08742	95.65985
Well - M.W 12	10100.47		5100,47	2742.95	873.38	873.09	39.08721	95,65987
Well M.W. 13	10211.79	2083.28	5211.79	2916.72	873.09	872.78	39.08754	95,66048
Yell - M.W 14			5181.77	2882.56	873.34	873.06	39.08749	95,66052
Vell - M.W 15	10177.15		5177.15	2979.18	872.70	B72.42	39,08739	95,56072
Vell - ASW1	10205.79	2115.65	5206.79	2884.35	873.35	872.86	39.08747	95,66038
Hell - ASW2	10181.59		5181.59	2875.03	873.31	873,11	39.08743	95,66033
Vell - ASW3			5151,57	2874.28	873.27	872.95	39.08735	95,66033
Vell - ASW4		2039.92	5214.99	2960.08	873.18	872.76	39.08752	95.66063
Vell - ASW5	10220.57		5220.57	2921.84	872,92	872.70	39.08754	95.66050
Yell - ASW6	10217.40		5217.40	2902.82	873,16	873.02	39.08753	95,66043
Yell - ASW7	10199.11	2056,60	5 99.11	2943.40	872.88	872.57	39.08748	95.66057
Yel - ASW8	Well ASW8				urvey. Will ottemp			
Yell - ASW9	10184.88	2038.37	5184.88	2961.63	872.89	872.50	39.08744	95.66064
Vell - ASW10	10174.37		5174,37	2944.37	873.14	872.86	39,08741	95,68058
ell - ASOBW1			5193.24	2878.13	873.42	873,03	39.08736	95,66043
vell - SVE1	10208.27		5208.27	2895.79	873,30	872.94	39.08746	95.66041
Yell - SVE2	10190.22		5190.22	2874.77	873.43	873.15	39.08746	95,66033
vell - SVE3			5155.60	2875.11	873.31	873.12	39.08736	95,58033
rell - SVE4	10175,40		5176,40	2960.99	872.97	872.66	39.08742	95,66064
Yell - SVE5			5226.90	2947.44	873.06	872.66	39.08756	95,56059
rell - SVE6	10189.07		5189.07	2943.47	873.04	872.69	39,08745	95,66057
Yell - VOBW1	10215.59	2110,77	5215.69	2889.23	873.31	873.00	39.08748	95,66039
ite B.M.	10108,93		5108.93	2856.34	B.M. Elev.			

Description: "" Square cut on back of curb on north side of east drive.

LEGE	END
- Site Bench Mork WW10 - Monitoring Well SVE10 - Soil Vapor Extraction Well VOBW10 - Vapor Observation Well ASW10 - Air Sporge Well ASOBW10 - Air Sporge Observation Well PP/LP W/ - Power Pole/Light Pole w/	GMo - Gos Meter [7] - Telephone Pedestol FO - Fiber Optic Locator Sign - Bollard - Droinage Direction Overhead Power Line - Underground Electric Line
UGE & CTV PP/LP W/31	
Traffic Signal Light WMo - Water Meter Wo - Water Valve O - Fire Hydrant	CML

42018 Anderson Avenue, Suite 2 .

Project #1711MN1334

(785) 776-0541 • FAX 776-9760 • Emoil: tim@stoonandmeier.com

DD #108

