

WATER WELL RECORD Form WWC-5

Division of Water Resources App. No.

AWS9

Original Record Correction Change in Well Use

Well ID

1 LOCATION OF WATER WELL: County: Shawnee Fraction 1/4 NE 1/4 NE 1/4 NW 1/4 Section Number 20 Township Number T 11 S Range Number R 16 E W

2 WELL OWNER: Last Name: Business: Topeka Conoco Food Mart Address: 2045 N. Kansas Ave City: Topeka State: KS ZIP: 66617 Street or Rural Address where well is located (if unknown, distance and direction from nearest town or intersection): If at owner's address, check here: 2045 N. Kansas Ave, Topeka, KS

3 LOCATE WELL WITH 'X' IN SECTION BOX: N W E S 1 mile 4 DEPTH OF COMPLETED WELL: 35 ft. Depth(s) Groundwater Encountered: 1) 25 ft. 2) ... ft. 3) ... ft., or 4) Dry Well WELL'S STATIC WATER LEVEL: ... ft. 5 Latitude: 38.08744 Longitude: 95.66064 Horizontal Datum: WGS 84 NAD 83 NAD 27 Source for Latitude/Longitude: GPS (unit make/model: ... (WAAS enabled? Yes No) Land Survey Topographic Map Online Mapper: 6 Elevation: 872.60 ft. Ground Level TOC Source: Land Survey GPS Topographic Map Other

7 WELL WATER TO BE USED AS: 1. Domestic: Household Lawn & Garden Livestock Irrigation Feedlot Industrial 2. Public Water Supply: well ID Dewatering: how many wells? Aquifer Recharge: well ID Monitoring: well ID Environmental Remediation: well ID ASW9 Air Sparge Soil Vapor Extraction Recovery Injection Oil Field Water Supply: lease Test Hole: well ID Cased Uncased Geotechnical Geothermal: how many bores? a) Closed Loop Horizontal Vertical b) Open Loop Surface Discharge Inj. of Water Other (specify):

Was a chemical/bacteriological sample submitted to KDHE? Yes No If yes, date sample was submitted: Water well disinfected? Yes No

8 TYPE OF CASING USED: Steel PVC Other CASING JOINTS: Glued Clamped Welded Threaded Casing diameter 2 in. to 33 ft., Diameter in. to ... ft., Diameter in. to ... ft. Casing height above land surface -0.5 in. Weight lbs./ft. Wall thickness or gauge No. Sch. 40

TYPE OF SCREEN OR PERFORATION MATERIAL: Steel Stainless Steel Fiberglass PVC Other (Specify) Brass Galvanized Steel Concrete tile None used (open hole)

SCREEN OR PERFORATION OPENINGS ARE: Continuous Slot Mill Slot Gauze Wrapped Torch Cut Drilled Holes Other (Specify) Louvered Shutter Key Punched Wire Wrapped Saw Cut None (Open Hole)

SCREEN-PERFORATED INTERVALS: From 33 ft. to 35 ft., From ... ft. to ... ft., From ... ft. to ... ft. GRAVEL PACK INTERVALS: From 32 ft. to 35 ft., From ... ft. to ... ft., From ... ft. to ... ft.

9 GROUT MATERIAL: Neat cement Cement grout Bentonite Other Grout Intervals: From 1 ft. to 32 ft., From ... ft. to ... ft., From ... ft. to ... ft.

Nearest source of possible contamination: Septic Tank Lateral Lines Pit Privy Livestock Pens Insecticide Storage Sewer Lines Cess Pool Sewage Lagoon Fuel Storage Abandoned Water Well Watertight Sewer Lines Seepage Pit Feedyard Fertilizer Storage Oil Well/Gas Well Other (Specify) Trust Fund site U4-089-14545 Direction from well? On-site Distance from well? 0 ft.

Table with 6 columns: 10 FROM, TO, LITHOLOGIC LOG, FROM, TO, LITHO. LOG (cont.) or PLUGGING INTERVALS. Rows include Concrete, Silty Clay, dk grey, med.stiff, Silt, gry to dk gry, Sand, very fine becoming med. to crse, Total Depth.

11 CONTRACTOR'S OR LANDOWNER'S CERTIFICATION: This water well was constructed reconstructed, or plugged under my jurisdiction and was completed on (mo-day-year) 8-17-2017 and this record is true to the best of my knowledge and belief. Kansas Water Well Contractor's License No. 585 This Water Well Record was completed on (mo-day-year) 3-16-18 under the business name of Associated Environmental, Inc. Signature

Mail 1 white copy along with a fee of \$5.00 for each constructed well to: Kansas Department of Health and Environment, Bureau of Water, GWTS Section, 1000 SW Jackson St., Suite 420, Topeka, Kansas 66612-1367. Mail one to Water Well Owner and retain one for your records. Telephone 785-296-5524. Visit us at http://www.kdheks.gov/waterwell/index.html KSA 82a-1212 Revised 7/10/2015

FULL SITE SURVEY

CONOCO FOOD MART


City of Topeka, Shawnee County, Kansas

Point	North Coordinate	East Coordinate	Distance SE Cor. North	From Sec. 20 West	* Elev. Top of Rim or PK Nail	Elev. Top of PVC Pipe	Latitude North	Longitude West
SE Cor. Sec. 20-T11S-R16E	5000	5000						
Well - M.W. - 1	10176.74	2061.80	5176.74	2938.20	873.17	872.70	39.08742	95.66056
Well - M.W. - 2	10183.14	2143.06	5183.14	2856.94	873.77	873.50	39.08744	95.66027
Well - M.W. - 4	10203.42	2044.13	5203.42	2955.87	873.43	873.04	39.08749	95.66062
Well - M.W. - 5	10116.11	2142.81	5116.11	2857.19	873.21	872.84	39.08725	95.66027
Well - M.W. - 8	10089.86	2031.31	5089.86	2988.69	873.11	872.74	39.08718	95.66066
Well - M.W. - 9	10233.19	2099.68	5233.19	2900.32	873.44	872.99	39.08757	95.66042
Well - M.W. - 10	10127.57	2052.78	5127.57	2947.22	873.23	872.75	39.08728	95.66059
Well - M.W. - 11	10177.51	2261.95	5177.51	2738.05	874.05	873.56	39.08742	95.65985
Well - M.W. - 12	10100.47	2257.05	5100.47	2742.95	873.38	873.09	39.08721	95.65987
Well - M.W. - 13	10211.79	2083.28	5211.79	2916.72	873.09	872.78	39.08754	95.66048
Well - M.W. - 14	10181.77	2117.44	5181.77	2882.56	873.34	873.06	39.08749	95.66062
Well - M.W. - 15	10177.15	2020.82	5177.15	2979.18	872.70	872.42	39.08739	95.66072
Well - ASW1	10206.79	2115.65	5206.79	2884.35	873.35	872.86	39.08747	95.66038
Well - ASW2	10181.59	2124.97	5181.59	2875.03	873.31	873.11	39.08743	95.66033
Well - ASW3	10151.57	2125.72	5151.57	2874.28	873.27	872.95	39.08735	95.66033
Well - ASW4	10214.99	2039.92	5214.99	2960.08	873.18	872.76	39.08752	95.66063
Well - ASW5	10220.57	2078.18	5220.57	2921.84	872.92	872.70	39.08754	95.66050
Well - ASW6	10217.40	2097.18	5217.40	2902.82	873.18	873.02	39.08753	95.66043
Well - ASW7	10199.11	2056.60	5199.11	2943.40	872.88	872.67	39.08748	95.66057
Well - ASW8	Well ASW8 covered by steel plate of firm of survey. Will attempt to locate at another time.							
Well - ASW9	10184.88	2038.37	5184.88	2961.63	872.89	872.60	39.08744	95.66064
Well - ASW10	10174.37	2055.63	5174.37	2944.37	873.14	872.86	39.08741	95.66058
Well - ASOBW1	10193.24	2121.87	5193.24	2878.13	873.42	873.03	39.08738	95.66043
Well - SVE1	10208.27	2104.21	5208.27	2895.79	873.30	872.94	39.08746	95.66041
Well - SVE2	10190.22	2125.23	5190.22	2874.77	873.43	873.15	39.08746	95.66033
Well - SVE3	10155.60	2124.89	5155.60	2875.11	873.31	873.12	39.08736	95.66033
Well - SVE4	10176.40	2039.01	5176.40	2980.99	872.97	872.66	39.08742	95.66064
Well - SVE5	10226.90	2052.56	5226.90	2947.44	873.06	872.66	39.08756	95.66059
Well - SVE6	10189.07	2056.53	5189.07	2943.47	873.04	872.69	39.08745	95.66057
Well - VOBW1	10215.59	2110.77	5215.59	2889.23	873.31	873.00	39.08748	95.66039
Site B.M.	10108.93	2143.66	5108.93	2856.34	B.M. Elev. = 873.15			


Description: "□" Square cut on back of curb on north side of east drive.

LEGEND

- ⊙ - Site Bench Mark
- MW1 ⊙ - Monitoring Well
- SVE1 ⊠ - Soil Vapor Extraction Well
- VOBW1 ⊠ - Vapor Observation Well
- ASW1 ⊙ - Air Spurge Well
- ASOBW1 ⊙ - Air Spurge Observation Well
- PP/LP W/ UGE & CTV ⊠ - Power Pole/Light Pole w/ UG Electric & Cable TV
- PP/LP W/3T UGE & CTV ⊠ - Power Pole/Light Pole w/ 3 Transformers UG Electric & Cable TV
- - Deadman Anchor
- ⊙ - Light Pole
- ⊙ - Electric Manhole
- ⊙ - Traffic Signal Light
- WM ⊙ - Water Meter
- WV ⊙ - Water Valve
- ⊙ - Fire Hydrant
- GM ⊙ - Gas Meter
- ⊠ - Telephone Pedestal
- FO ⊠ - Fiber Optic Locator Sign
- ⊙ - Bollard
- - Drainage Direction
- OE - - - - - Overhead Power Line
- ε - - - - - Underground Electric Line
- v - - - - - Water Line
- g - - - - - Gas Line
- ss - - - - - Sanitary Sewer Line
- ⊠ - - - - - Underground Telephone Line
- FO - - - - - Underground Fiber Optic Line
- - - - - Trench Line

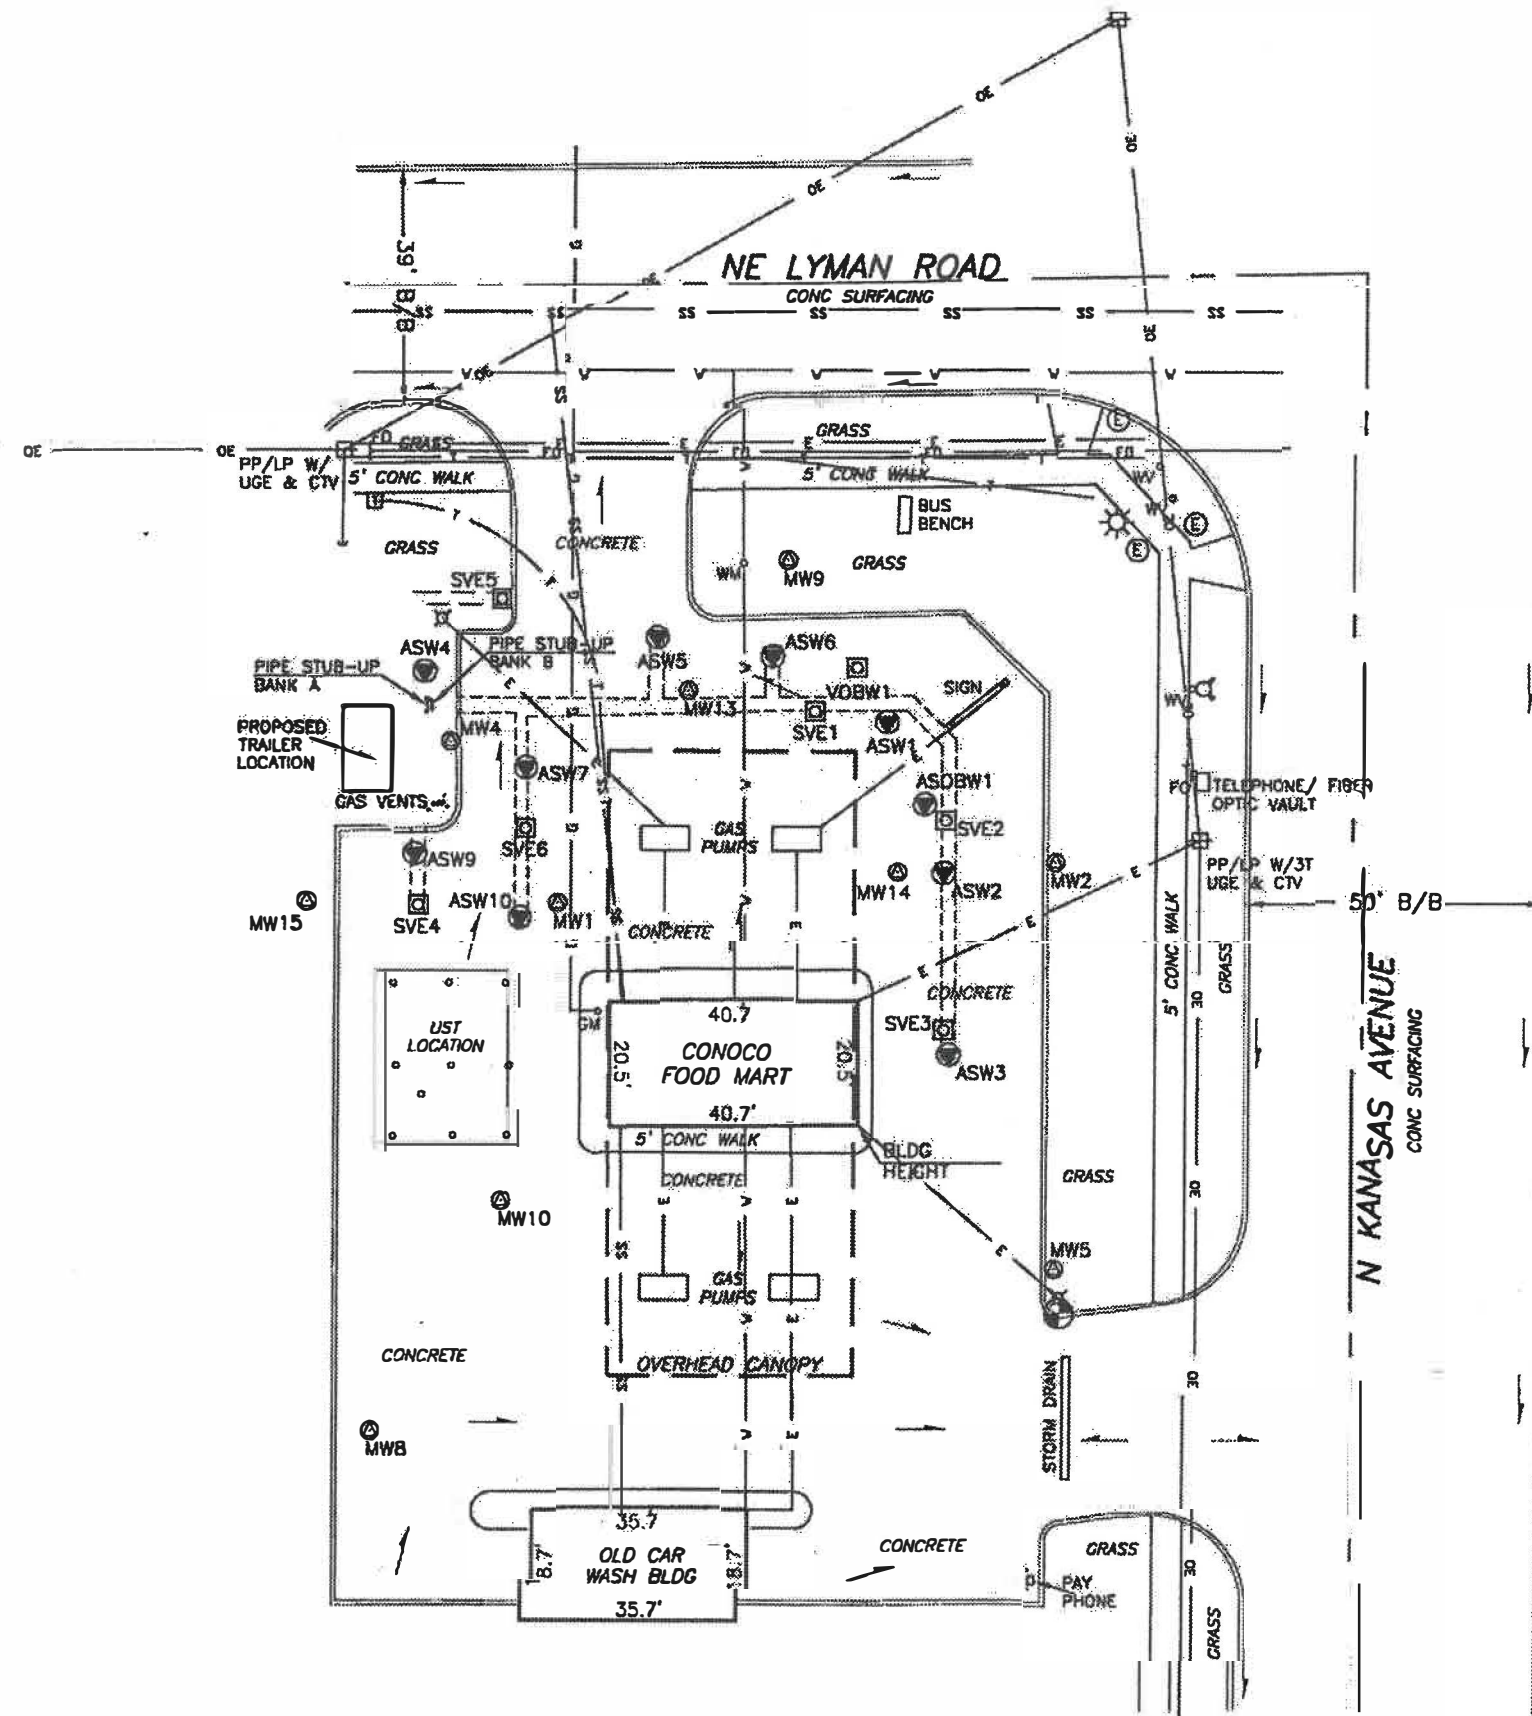

SCALE: 1"=30'

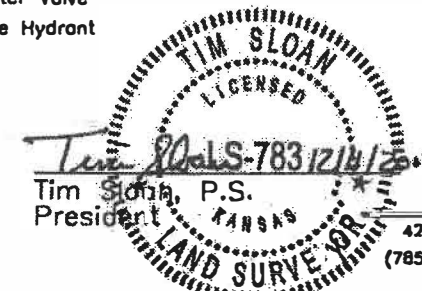

SMH
CONSULTANTS

4201B Anderson Avenue, Suite 2 • Manhattan, Kansas 66503
(785) 776-0541 • FAX 776-9760 • Email: tim@sloanandmeier.com
Project #1711MN1334 DD #108

SHAWNEE CO

20-11-10E