
		ECORD		WWC-5			sion of Water			Well ID	AWS10
	Original Record Correction Change in W  LOCATION OF WATER WELL: Fract			Fraction							
	Shawnee		ulu;	1/4 NE 1/4	NE ¼	I .	20		11 S		E □ W
2 WELL				First:		Street or Ru	al Address w				
Business: Topeka Conoco Food Mart direction from nearest town or intersection): If at owner's address, check here:								check here:			
Address: 2045 N. Kansas Ave Address: 2045 N. Kansas Ave, Topeka, KS											
City:	1/0 == 000/=										
3 LOCATI	3 LOCATE WELL WITH 6YP IN 4 DEPTH OF COMPLETED WELL: 35ft. 5 Latitude: 38.08741 (decimal degrees)								(decimal degrees)		
WITH "X" IN Denth(s) Groundwater Encountered: 1) 25 ft Longitude: 95 66058 (Assimple							(decimal degrees)				
2) ft. 3) ft., or 4) $\square$ Dry Well   Horizontal Datum: $\square$ WGS 84 $\blacksquare$ NAD 83 $\square$ N								83 NAD 27			
WELL'S STATIC WATER LEVEL: ft. Source for Latitude/Longi											
	below land surface, measured on (mo-day-yr)										
NW	NWNE							(0)			
w  -	E after hours pumping										
sw	SE			water was							
	alter				6 Elevation: 872.86 ☐ Ground Level TOC						
	S Bore Hole Diameter:			.8.25 in. to			Source:	Source: Land Survey GPS Topographic Map			
1 m				in. to	<u></u>	ft <u>.</u>		U Other			
		D BE USED		nton Cummley 11 1	ID		10 🗆 🔾 :	Field Water	Supply L	2250	
1. Domestic:				ater Supply: well l ng: how many wel				ole: well ID			
Lawn &				echarge: well ID			ed Unca				
Livesto	ck			ig: well ID				ermal: how n			
2. Irrigati				al Remediation: v				sed Loop			
3. ☐ Feedlor 4. ☐ Industr			Air Sparg Recovery				b) Open Loop ☐ Surface Discharge ☐ Inj. of Water  13. ☐ Other (specify):				
. —		-	_	nitted to KDHE		Ves No					
		?  \[ Yes \[		inticu to RDHE		103	11 yes, date	sample was	Suomitte		
8 TYPE O	F CASINO	USED:	Steel PV	C Other		CASI	NG JOINTS:	☐ Glued ☐	Clamped	d □ Welde	d Threaded
Casing diam	<sub>eter</sub> 2	in to	33 ft	Diameter		in. to	ft Diame	eter	in. to	ft.	
Casing heigh	it above land	surface	u.ə i	n. Weight		lbs./ft.	Wall thicks	less or gauge	No. SCI	40	
TYPE OF S		R PERFORA inless Steel	TION MA Fibe □		VC		□ Oth	er (Specify)			
Brass		vanized Steel		_		sed (open hole		i (Specify)		• • • • • • • • • • • • • • • • • • • •	
		RATION OPI		RE:							
	nuous Slot	Mill Slot				orch Cut 🔲 🛚			ecify)	•••••	
CODEEN E	red Shutter	Key Pund	ched ∐ V	Vire Wrapped n .33 ft. to S	∐ Sa 35	w Cut ∐ N	ione (Open Ho	ole)	From	ft to	e
SCREEN-P	RAVEL PA	CK INTERV	ALS: From	m 32 ft to	35	fi From	ft to	fi	From	ft to	ft
GRAVEL PACK INTERVALS: From32 ft. to35 ft., From ft. to ft., From ft. to ft. o ft. ft. o ft. ft. o ft. ft. o ft. ft. ft. ft. ft. ft. ft. ft. ft											
Grout Intervals: From											
Nearest source of possible contamination:											
☐ Septic			Lateral Lin Cess Pool	es ☐ Pit Pı ☐ Sewa			Livestock Per Fuel Storage			cide Storage oned Water	
	ight Sewer L		Seepage Pi		yard		Fertilizer Stor	agc		ell/Gas Well	
Other (	■ Other (Specify) Trust Fund site U4-089-14545  Direction from well? On-site Distance from well? 0 ft.										
					om w						G INTERVALS
10 FROM 0	TO 0.5	Concrete	LITHOLO	GIC LOG		FROM	10	LITHO. LOC	(cont.) of	PLUGGIN	O INTERVALS
0.5	4.5	Silty Clay, d	k grev m	ed stiff		_					
4.5	20	Silt, gry to d									
20	35			ning med. to cr	se						
35	TD	Total Depth									
						N.					
Notes:											
11 CONTRACTOR'S OR LANDOWNER'S CERTIFICATION: This water well was constructed, reconstructed, or plugged											
under my jurisdiction and was completed on (mo-day-year) 8-17-2017 and this record is true to the best of my knowledge and belief.  Kansas Water Well Contractor's License No. 585 This Water Well Record was completed (mo-day-year) 3-16-18											
Kansas Wa	ter Well Co	ontractor's Li	cense No.	nonmental Inc	iis W	ater Well Re	cord was con	leted (1	no-dat-y	ear) 3-10-	
Mail	under the business name of Associated Environmental, Inc.  Mail 1 white copy along with a fee of \$5.00 for each constructed well to: Kansas Department of Health and Environmental Bureau of Water, GWTS Section,										
1000	SW Jackson	St., Suite 420, To	opeka, Kansa	s 66612-1367. Mail	one to	Water Well Ow	ner and retain or	e for your reco	rds. Telepl	ione 785-296	-5524.
Visit us at http	://www.kdhel	ks.gov/waterwell	/index.html			KSA 82a-12	.12			Revised	7/10/2015

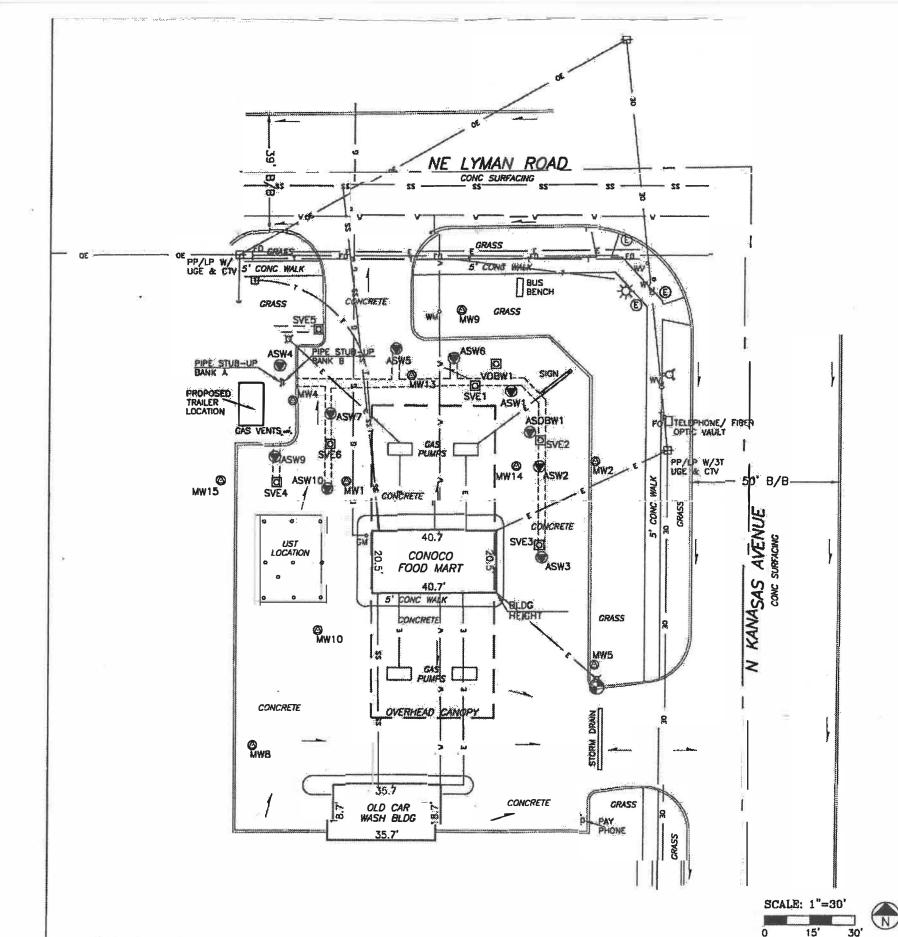

## FULL SITE SURVEY

CONOCO FOOD MART

City of Topeka, Shawnee County, Kansas

Point	North Coordinate	Eost Coordinate	Distance SE Cor. North	From Sec. 20 West	* Elev. Top of Rim or PK Noil	Elev. Top of PVC Pipe	Lotitude North	Longitude West
SE Cor.						2 12		
Sec. 20-T11S-R16E	5000	5000					uwa	
Well - M.W	10176.74	2061.80	5176.74	2938.20	873.17	872.70	39,08742	95,66056
Well - M.W 2	10183.14	2143.06	5183.14	2856.94	873.77	873.50	39,08744	95.66027
Well - N.W 4	10203.42	2044,13	5203.42	2955.87	873.43	873.04	39.08749	95.66062
Well - M.W 5	10115.11	2142.81	5116.11	2857,19	873.21	872.84	39,08725	95.85027
Well - M.W B	10089.86	2031.31	5089.86	2955.69	873.11	872.74	39,08718	95.66066
Well - M.W 9	10233,19	2099.68	5233,19	2900.32	873.44	872.99	39.08757	95.66042
Well - N.W 10	10127.57	2052.78	5127.57	2947.22	873.23	872.75	39.08728	95,66059
Well - M.W 11	10177.51	2261.95	5177.51	2738.05	874.05	873.56	39.08742	95,65985
Well - M.W 12	10100.47	2257.05	5100.47	2742.95	873.38	873.09	39.08721	95.65987
Well - M.W. 13	10211.79	2083.28	5211.79	2918.72	873.09	872.78	39.08754	95.66048
Yell - M.W 14	10181.77	2117,44	5181.77	2882.56	873.34	873.06	39.08749	95,66052
Well - M.W 15	10177,15	2020.82	5177.15	2979,18	872.70	B72.42	39.08739	95,56072
Well ASW1	10205.79	2115.65	5206.79	2884.35	873.35	872.86	39.08747	95,66038
Well ASW2	10181.59	2124.97	5181.59	2875.03	873.31	873,11	39.08743	95,66033
Nell - ASW3	10151.57	2125.72	5151,57	2874.28	873.27	872.95	39.08735	95,66033
Hell - ASW4		2039.92	5214.99	2960.08	873,18	872,76	39.08752	95.66063
Well - ASW5	10220.57	2078.16	5220.57	2921.84	872,92	872.70	39.08754	95.66050
Well - ASW6	10217,40	2097.18	5217.40	2902.82	873,16	873.02	39,08753	95,66043
Hell - ASW7	10199.11	2056.60	5199,11	2943.40	872.88	872.57	39,08748	95.86057
Hel - ASW8					survey. Will attempt	to locate o	t another lin	ne.
Kell - ASW9	10184.88	2038.37	5184.88	2961.63	872.89	872.60	39.08744	95.66064
Vell - ASW10	10174.37	2055.63	5174.37	2944,37	873.14	872.86	39.08741	95,66058
Vell - ASOBW1	10193.24	2121.87	5193.24	2878,13	873.42	873.03	39.08736	95,66043
Hell - SVE1	10208.27	2104.21	5208.27	2895.79	873,30	872.94	39.08746	95,66041
Hell - SVE2	10190.22	2125.23	5190.22	2874.77	873.43	873.15	39.08746	95.66033
Nell - SVE3		2124.89	5155.60	2875.11	873.31	873.12	39.08736	95,68033
Yell - SVE4	10175.40	2039.01	5175.40	2960.99	872.97	872.65	39.08742	95.66064
Well - SVE5		2052.56	5226.90	2947.44	873.06	872.66	39.08756	95,66059
Well - SVE6		2055.53	5189.07	2943,47	873.04	872.69	39.08745	95.66057
rell - VOBW1	10215.59	2110.77	5215.69	2889.23	873.31	873.00	39.08748	95,66039
Site B.M.	10108,93	2143.68	5108.93	2856.34	B.M. Elev. =			

Description: "" Square cut on back of curb on north side of east drive.

LEGE	END
- Site Bench Mork  WW10 - Monitoring Well  SVE10 - Soil Vapor Extraction Well  VOBW10 - Vapor Observation Well  ASW10 - Air Sparge Well  ASOBW10 - Air Sparge Observation Well  PP/LP W/ - Power Pole/Light Pole w/	GMo - Gos Meter  [1] - Telephone Pedestal  Fo   - Fiber Optic Locator Sign  - Bollard  - Droinage Direction  Overhead Power Line  E - Underground Electric Line
UGE & CTV  PP/LP W/3T	
WMo - Water Meter Wo - Water Valve O - Fire Hydrant	CML

Tim Slotin, P President SVI

42018 Anderson Avenue, Suite 2 • Manhottan, Kansas 66503 (785) 776-0541 • FAX 776-9760 • Emoil: tim@siconandmeler.com Project #1711MN1334 DD #108