
WAIER WELL R		W W C-5		ision of water		Well ID SVE2			
Original Record		e in Well Use		ources App. No.		Well ID			
1 LOCATION OF W.	ATER WELL:	Fraction		tion Number	Township Number				
County: Shawnee		1/4 NE 1/4 NE 1/4		20	T 11 S	R 16 ■ E □ W			
2 WELL OWNER: Last Name: First: Street or Rural Address where well is located (if unknown, distance and									
Business: Topeka Co		İ	direction from	nearest town or int	ersection): If at owner's	address, check here:			
	Address: 2045 N. Kansas Ave				2045 N. Kansas Ave, Topeka, KS				
Address:	a . I/O		2045 N. Na	13 N. Nalisas Ave, Topeka, No					
	City: Topeka State: KS ZIP: 66617								
3 LOCATE WELL	4 DEPTH OF COMPLETED WELL: 30 ft. 5 Latitude: 38.08746 (dccimal degr								
WITH "X" IN	Denth(s) Groundwater	Encountered: I) 2	5 н	Lancitu	95 66033	(decimal degrees)			
	Depth(s) Groundwater Encountered: 1)								
N									
WELL'S STATIC WATER LEVEL:									
1 1 1 1				1					
NW NE		□ above land surface, measured on (mo-day-yr)							
		s pumping		Land	Survey Topograph	не мар			
W E		vater was			☐ Online Mapper:				
SWSE		s pumping							
				6 Elevatio	n: .873.15ft. [Ground Level TOC			
S	Estimated Yield: Bore Hole Diameter:	11 25 : to 30	ft and	Source:	Land Survey ☐ GP	S Topographic Map			
mile	Bole Hole Diameter	in. to	it. and		_				
		III. to	11.						
7 WELL WATER TO		4 C1 11 ID		10 🗖 00 5	:-14 W-+C				
1. Domestic:		ter Supply: well ID				se			
Household		g: how many wells?			e: well ID				
☐ Lawn & Garden		echarge: well ID			d ☐ Uncased ☐ Ge				
Livestock		g:_well ID			mal: how many bores?				
2. Irrigation		al Remediation: well II			d Loop Horizontal				
3. Feedlot	☐ Air Sparge		Extraction		Loop Surface Discl				
4. Industrial	☐ Recovery	☐ Injection		13. \square Other	(specify):				
Was a chemical/bacter	iological sample subm	itted to KDHE?	Yes No	If ves, date sa	ample was submitted:				
Water well disinfected?),					
8 TYPE OF CASING		C D Other	CASI	NG IOINTS: I	Clued Clement I	Wolded Threeded			
8 TIPE OF CASING	is to 10	D't	CASI	NG JOINTS: [_ Glued _ Clamped [_ weided _ Inreaded			
Casing diameter 4 Casing height above land s	in. to r.,	Diameter	in. to	II., Diamete	r in. to	It.			
			lbs./π.	Wall thickne	ss or gauge No. 🥺!!:. 🛪	ω			
TYPE OF SCREEN OR				_					
☐ Steel ☐ Stainless Steel ☐ Fiberglass ■ PVC ☐ Other (Specify)									
	anized Steel		ised (open hol	e) ,					
SCREEN OR PERFOR.	ATION OPENINGS A	RE:							
☐ Continuous Slot			orch Cut 🔲 I	Orilled Holes	Other (Specify)				
☐ Louvered Shutter	☐ Key Punched ☐ W	ire Wrapped Sa	w Cut 🔲 1	None (Open Hole	e)				
SCREEN-PERFORATED INTERVALS: From .10 ft. to ft., From ft., From ft. to ft.									
GRAVEL PACK INTERVALS: From 9 ft. to 30 ft., From ft. to ft., From ft. to ft.									
9 GROUT MATERIAL: ☐ Neat cement ☐ Cement grout ■ Bentonite ☐ Other									
Grout Intervals: From									
Nearest source of possible contamination:									
☐ Septic Tank ☐ Lateral Lines ☐ Pit Privy ☐ Livestock Pens ☐ Insecticide Storage									
Sewer Lines									
□ Watertight Sewer Lines □ Seepage Pit □ Feedyard □ Fertilizer Storage □ Oil Well/Gas Well									
■ Other (Specify) Trust Fund site U4-089-14545									
Direction from well? On-site Distance from well? O									
10 FROM TO	LITHOLOG		FROM			LUGGING INTERVALS			
		JIC LOG	1 KOW	IO LI	TITO. LOG (COIII.) OF P	LUGGING INTERVALS			
	Concrete	-1 -4:ff							
	Silty Clay, dk grey, me	ea.stiff							
	Silt, gry to dk gry								
	Sand, very fine becom	ning med. to crse							
30 TD T	otal Depth								
	Notes:								
110001									
11 CONTRACTOR'S OR LANDOWNED'S CERTIFICATION. This water well we have the contract of the cont									
11 CONTRACTOR'S	11 CONTRACTOR'S OR LANDOWNER'S CERTIFICATION: This water well was constructed, reconstructed, or plugged								
under my jurisdiction and was completed on (mo-day-year) 8-16-2017 and this record is true to the best of my knowledge and belief. Kansas Water Well Contractor's License No. 585 This Water Well Record was completed on mo day year) 3-16-18									
Kansas water well Con	uractor's License No. 9	onmental Inc	ater Well Re	cord was comp	leted op mo-day/-year	7) 97.107.10			
under the business name	OI CAPACIALES ENDE	b constructed well to 17	Si	gnature	and million of the same	CWTCC			
	ng with a fee of \$5.00 for each								
	., Suite 420, Topeka, Kansas	00012-136/. Mail one to			-				
Visit us at http://www.kdheks	.gov/waterwell/index.html		KSA 82a-12	.12		Revised 7/10/2015			

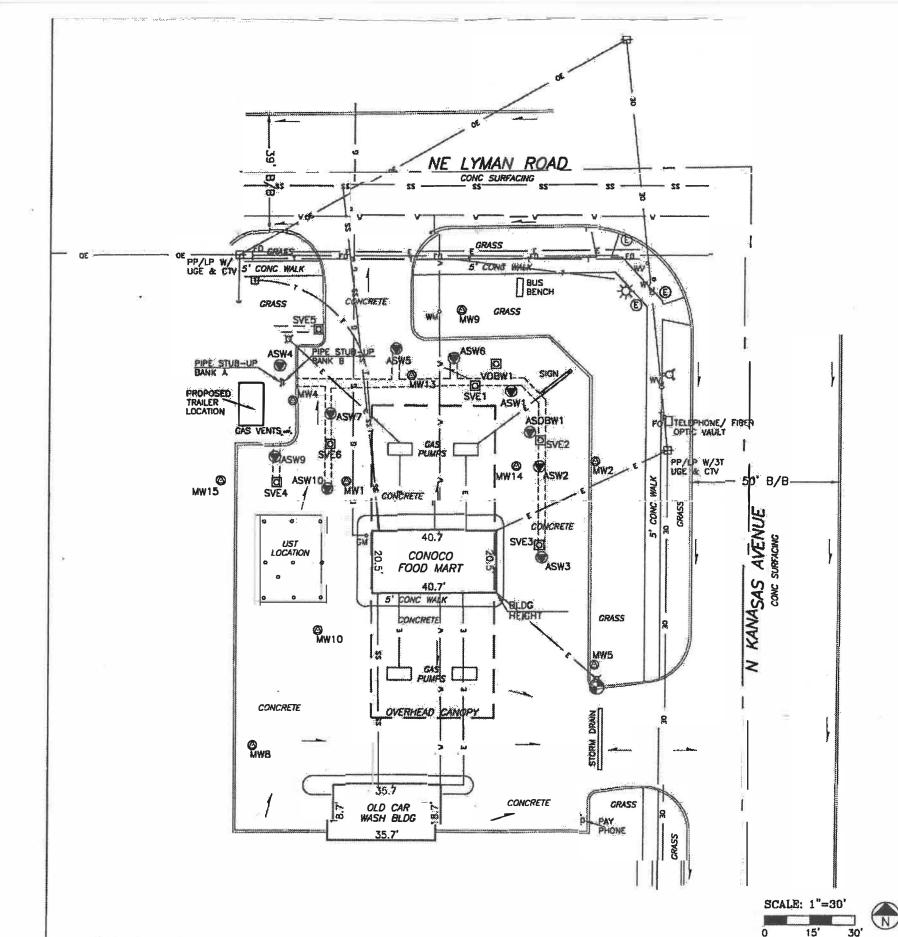

FULL SITE SURVEY

CONOCO FOOD MART

City of Topeka, Shawnee County, Kansas

Point	North Coordinate	Eost Coordinate	Distance SE Cor. North	From Sec. 20 West	* Elev. Top of Rim or PK Noil	Elev. Top of PVC Pipe	Lotitude North	Longitude West
SE Cor.						2 12		
Sec. 20-T11S-R16E	5000	5000					uwa	
Well - M.W	10176.74	2061.80	5176.74	2938.20	873.17	872.70	39,08742	95,66056
Well - M.W 2	10183.14	2143.06	5183.14	2856.94	873.77	873.50	39,08744	95.66027
Well - N.W 4	10203.42	2044,13	5203.42	2955.87	873.43	873.04	39.08749	95.66062
Well - M.W 5	10115.11	2142.81	5116.11	2857,19	873.21	872.84	39,08725	95.85027
Well - M.W B	10089.86	2031.31	5089.86	2955.69	873.11	872.74	39,08718	95.66066
Well - M.W 9	10233,19	2099.68	5233,19	2900.32	873.44	872.99	39.08757	95.66042
Well - N.W 10	10127.57	2052.78	5127.57	2947.22	873.23	872.75	39.08728	95,66059
Well - M.W 11	10177.51	2261.95	5177.51	2738.05	874.05	873.56	39.08742	95,65985
Well - M.W 12	10100.47	2257.05	5100.47	2742.95	873.38	873.09	39.08721	95.65987
Well - M.W. 13	10211.79	2083.28	5211.79	2918.72	873.09	872.78	39.08754	95.66048
Yell - M.W 14	10181.77	2117,44	5181.77	2882.56	873.34	873.06	39.08749	95,66052
Well - M.W 15	10177,15	2020.82	5177.15	2979,18	872.70	B72.42	39.08739	95,56072
Well ASW1	10205.79	2115.65	5206.79	2884.35	873.35	872.86	39.08747	95,66038
Well ASW2	10181.59	2124.97	5181.59	2875.03	873.31	873,11	39.08743	95,66033
Nell - ASW3	10151.57	2125.72	5151,57	2874.28	873.27	872.95	39.08735	95,66033
Hell - ASW4		2039.92	5214.99	2960.08	873,18	872,76	39.08752	95.66063
Well - ASW5	10220.57	2078.16	5220.57	2921.84	872,92	872.70	39.08754	95.66050
Well - ASW6	10217,40	2097.18	5217.40	2902.82	873,16	873.02	39,08753	95,66043
Hell - ASW7	10199.11	2056.60	5199,11	2943.40	872.88	872.57	39,08748	95.86057
Hel - ASW8					survey. Will attempt	to locate o	t another lin	ne.
Hell - ASW9	10184.88	2038.37	5184.88	2961.63	872.89	872.60	39.08744	95.66064
Vell - ASW10	10174.37	2055.63	5174.37	2944,37	873.14	872.86	39.08741	95,66058
Vell - ASOBW1	10193.24	2121.87	5193.24	2878,13	873.42	873.03	39.08736	95,66043
Hell - SVE1	10208.27	2104.21	5208.27	2895.79	873,30	872.94	39.08746	95,66041
Hell - SVE2	10190.22	2125.23	5190.22	2874.77	873.43	873.15	39.08746	95.66033
Nell - SVE3		2124.89	5155.60	2875.11	873.31	873.12	39.08736	95,58033
Yell - SVE4	10175.40	2039.01	5175.40	2960.99	872.97	872.65	39.08742	95.66064
Well - SVE5		2052.56	5226.90	2947.44	873.06	872.66	39.08756	95,66059
Well - SVE6		2055.53	5189.07	2943,47	873.04	B72.69	39.08745	95.66057
rell - VOBW1	10215.59	2110.77	5215.69	2889.23	873.31	873.00	39.08748	95,66039
Site B.M.	10108,93	2143.68	5108.93	2856.34	B.M. Elev. =			

Description: "" Square cut on back of curb on north side of east drive.

LEGE	END
- Site Bench Mork WW10 - Monitoring Well SVE10 - Soil Vapor Extraction Well VOBW10 - Vapor Observation Well ASW10 - Air Sparge Well ASOBW10 - Air Sparge Observation Well PP/LP W/ - Power Pole/Light Pole w/	GMo - Gos Meter [1] - Telephone Pedestal Fo - Fiber Optic Locator Sign - Bollard - Droinage Direction Overhead Power Line E - Underground Electric Line
UGE & CTV PP/LP W/3T	
WMo - Water Meter Wo - Water Valve O - Fire Hydrant	CML

Tim Slotin, P President SVI

42018 Anderson Avenue, Suite 2 • Manhottan, Kansas 66503 (785) 776-0541 • FAX 776-9760 • Emoil: tim@siconandmeler.com Project #1711MN1334 DD #108