
	WELL R		WWC-5		vision of Water			SVE4		
			e in Well Use		ources App. No		Well ID			
		ATER WELL:	Fraction		ction Number	Township Numbe		ge Number		
County	<u>:</u> Shawnee		1/4 NE 1/4 NE 1/4							
2 WELL OWNER: Last Name: First: Street or Rural Address where well is located (if unknown, distance as										
		onoco Food Mart		lirection from	nearest town or in	ntersection): If at owner'	's address, c	heck here:		
	2045 N. K	lansas Ave		2045 N. Kansas Ave, Topeka, KS						
Address:	T	State: KS	1							
City:	Topeka		ZIP: 66617							
3 LOCATI		4 DEPTH OF COM	APLETED WELL:	30 1	t. 5 Latitud	le: 38.08742	<u>}</u> (decimal degrees)		
WITH "			Encountered: 1)25			Longitude: 95.66064 (decimal degrees)				
SECTIO		2) ft.	3) ft., or 4) □	Dry Well	Horizon	tal Datum: WGS 84	■ NAD 8	3 NAD 27		
1		WELL'S STATIC WA	TER LEVEL:	ft.		Source for Latitude/Longitude:				
	X		, measured on (mo-day-y		□ GP:	GPS (unit make/model:)				
NW	NE		, measured on (mo-day-y			(WAAS enabled? ☐ Yes ☐ No)				
	1 1		vater wasft.		Lan	■ Land Survey ☐ Topographic Map				
w	E		s pumping		☐ Onl	Online Mapper:				
sw	SF		vater was ft							
5, ,	1		s pumping	gpm	6 Fleveti	on: 872.66ft.	□ Ground	Level TOC		
		Estimated Yield:	gpm	0 1	Source	■ Land Survey □ G		nographic Man		
1 m	-	Bore Hole Diameter:	11.25 in to 30	0 ft. and Source: ■ Land Survey ☐ GPS ☐ Topograph ☐ Other						
'			in. to	II.						
1		D BE USED AS:	C		10 🗀 033	Ciald Water Co. 1				
1. Domestic:			nter Supply: well ID			Field Water Supply: lea				
Housel			ng: how many wells?			ole: well ID				
☐ Lawn &			echarge: well ID			ed Uncased G				
		8. LI Montonia	g: well IDal Remediation: well ID	SVF4		rmal: how many bores' sed Loop 🏻 Horizonta				
2. ☐ Irrigation 3. ☐ Feedlor		9. Environment								
4. Industr		☐ Recovery								
			<u> </u>							
		riological sample subn	nitted to KDHE? L Y	es No	If yes, date s	sample was submitted	1:			
		P ☐ Yes ☐ No								
8 TYPE O	F CASING	USED: Steel PV	C Other	CAS	ING JOINTS:	☐ Glued ☐ Clamped	☐ Welded	Threaded		
Casing diam	eter 4	in. to10 ft	Diameter	in. to	ft., Diame	ter in. to	ft.			
		surface -0.5 ir		lbs./ft.	Wall thickn	ess or gauge No. Sch.	.40			
TYPE OF S		R PERFORATION MA								
☐ Steel		nless Steel 🔲 Fiber				r (Specify)	• • • • • • • • • • • • • • • • • • • •			
☐ Brass		vanized Steel		ed (open ho	le)					
SCREEN C	R PERFOR	CATION OPENINGS A								
☐ Contin	uous Slot	■ Mill Slot □ G	auze Wrapped 🔲 Tor	ch Cut 🔲	Drilled Holes	Other (Specify)				
☐ Louve	red Shutter	☐ Key Punched ☐ W	/ire Wrapped ☐ Sav	v Cut 🔲	None (Open Ho	le)				
SCREEN-P	ERFORAT	☐ Key Punched ☐ W ED INTERVALS: Fror CK INTERVALS: Fror	n ft. to	ft., From	ft. to .	ft., From	ft. to	ft.		
Gl	RAVEL PA	CK INTERVALS: From	n . 9 ft. to	ft., From	ft. to	ft., From	ft. to	ft,		
9 GROUT MATERIAL: □ Neat cement □ Cement grout ■ Bentonite □ Other										
Grout Interva	als: From	! ft. to	ft., From f	t. to	ft., From	ft. to	ft.			
	A	le contamination:		_	_					
☐ Septic		☐ Lateral Line			Livestock Pens					
☐ Sewer I		Cess Pool	☐ Sewage Lag		Fuel Storage		ned Water V	<i>N</i> ell		
	ght Sewer Li				Fertilizer Stora	ige 🔲 Oil Wel	l/Gas Well			
☐ Other (Specify) Trust Fund site U4-089-14545										
			<u> </u>				DITTOORY	OBJERRALIC		
10 FROM	TO	LITHOLO	GIC LUG	FROM	TO L	ITHO. LOG (cont.) or	rluggin(JINTERVALS		
		Concrete	- 1 - v:tt	1	 					
0.5		Silty Clay, dk grey, me	ea.sum							
		Silt, ary to dk ary								
		Sand, very fine becon	ning med, to crse							
30	TD T	Total Depth								
				Notes:						
11 CONTRACTOR'S OR LANDOWNER'S CERTIFICATION: This water well was constructed, reconstructed, or plugged under my jurisdiction and was completed on (mo-day-year) 8-15-2017 and this record is true to the best of my knowledge and belief. Kansas Water Well Contractor's License No. 585 This Water Well Record was completed in mo day-year) 3-16-18										
under my ju	irisdiction a	nd was completed on (r	no-day-year) .81520	1.7 and	this record is	true to the best of my	y knowledg	ge and belief.		
Kansas Wa	ter Well Co	ntractor's License No.	NO. This Wa	ter Well Re	cord was com	leted (mo)day-ye	ar) 3-16-1	. <u>ö</u>		
under the b	usiness nam	e of Associated Envi	onmental, inc	S	ignature	really Lun-				
		ong with a fee of \$5.00 for ea								
		t., Suite 420, Topeka, Kansas				for your records. Telepho				
Visit us at http	://www.kdhek:	s.gov/waterwell/index.html		KSA 82a-1	212		Revised	7/10/2015		

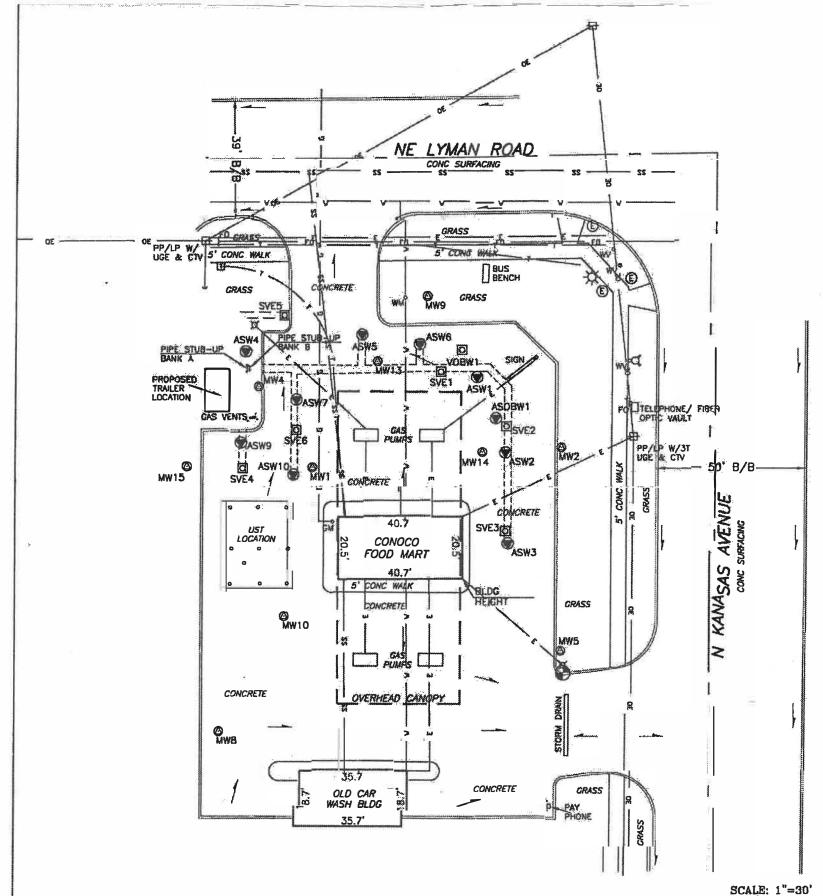

FULL SITE SURVEY

CONOCO FOOD MART

City of Topeka, Shawnee County, Kansas

Point	North Coordinate	Eost Coordinate	Distance SE Cor. North	From Sec. 20 West	* Elev. Top of Rim or PK Noil	Elev. Top of PVC Pipe	Lotitude North	Longitud West
SE Cor. Sec. 20-T11S-R16E	5000	5000						
Well - N.W	10176.74	2061.80	5176.74	2938.20	873.17	872.70	39,08742	95,66056
Well - M.W 2	10163.14	2143.06	5183.14	2856.94	873.77	873.50	39,08744	95.66027
Well - M.W 4	10203.42		5203,42	2955.87	873.43	873.04	39.08749	95.66062
Well - M.W 5	10115.11		5116,11	2857,19	873.21	872.84	39,08725	95,86027
Well - M.W B	10089.86	2031.31	5089.86	2988.69	873.11	872.74	39,08718	95.66066
Well - M.W 9	10233,19	2099.68	5233,19	2900.32	873.44	872.99	39.08757	95.66042
Well - M.W 10	10127.57	2052.78	5127.57	2947.22	873.23	872.75	39.08728	95,66059
Well - M.W 11	10177.51	2261.95	5177.51	2738.05	874.05	873.56	39.08742	95.65985
Well - M.W 12	10100.47		5100,47	2742.95	873.38	873.09	39.08721	95,65987
Well M.W. 13	10211.79	2083.28	5211.79	2916.72	873.09	872.78	39.08754	95,66048
Yell - M.W 14			5181.77	2882.56	873.34	873.06	39.08749	95,66052
Vell - M.W 15	10177.15		5177.15	2979.18	872.70	B72.42	39,08739	95,56072
Vell - ASW1	10205.79	2115.65	5206.79	2884.35	873.35	872.86	39.08747	95,66038
Hell - ASW2	10181.59		5181.59	2875.03	873.31	873,11	39.08743	95,66033
Vell - ASW3			5151,57	2874.28	873.27	872.95	39.08735	95,66033
Vell - ASW4		2039.92	5214.99	2960.08	873.18	872.76	39.08752	95.66063
Vell - ASW5	10220.57		5220.57	2921.84	872,92	872.70	39.08754	95.66050
Yell - ASW6	10217.40		5217.40	2902.82	873,16	873.02	39.08753	95,66043
Yell - ASW7	10199.11	2056,60	5 99.11	2943.40	872.88	872.57	39.08748	95.66057
Yell - ASW8	Well ASW8				urvey. Will ottemp			
Yell - ASW9	10184.88	2038.37	5184.88	2961.63	872.89	872.50	39.08744	95.66064
Vell - ASW10	10174.37		5174,37	2944.37	873.14	872.86	39,08741	95,68058
ell - ASOBW1			5193.24	2878.13	873.42	873,03	39.08736	95,66043
vell - SVE1	10208.27		5208.27	2895.79	873,30	872.94	39.08746	95.66041
Yell - SVE2	10190.22		5190.22	2874.77	873.43	873.15	39.08746	95,66033
vell - SVE3			5155.60	2875.11	873.31	873.12	39.08736	95,58033
rell - SVE4	10175,40		5176,40	2960.99	872.97	872.66	39.08742	95,66064
Yell - SVE5			5226.90	2947.44	873.06	872.66	39.08756	95,56059
rell - SVE6	10189.07		5189.07	2943.47	873.04	872.69	39,08745	95,66057
Yell - VOBW1	10215.59	2110,77	5215.69	2889.23	873.31	873.00	39.08748	95,66039
ite B.M.	10108,93		5108.93	2856.34	B.M. Elev.			

Description: "" Square cut on back of curb on north side of east drive.

LEGE	END
- Site Bench Mork WW10 - Monitoring Well SVE10 - Soil Vapor Extraction Well VOBW10 - Vapor Observation Well ASW10 - Air Sporge Well ASOBW10 - Air Sporge Observation Well PP/LP W/ - Power Pole/Light Pole w/	GMo - Gos Meter [7] - Telephone Pedestol FO - Fiber Optic Locator Sign - Bollard - Droinage Direction Overhead Power Line - Underground Electric Line
UGE & CTV PP/LP W/31	
Traffic Signal Light WMo - Water Meter Wo - Water Valve O - Fire Hydrant	CML

42018 Anderson Avenue, Suite 2 .

Project #1711MN1334

(785) 776-0541 • FAX 776-9760 • Emoil: tim@stoonandmeier.com

DD #108

