
	WELL R		Form V					sion of Water			٦.,		SVE6	
	Record TON OF W			Fraction				irces App. No ion Number		Township Nun		ell ID	ge Number	
	Shawnee	AIEK WEI	ıı.		1/4 NE 1/	4 NW/4	Secti	20	١	T 11			E W	
	OWNER: L	ast Name:		First:		Street or	Rura	al Address v	wher	e well is locate				
Business: Topeka Conoco Food Mart							direction from nearest town or intersection): If at owner's address, check here:							
Address: 2045 N. Kansas Ave Address: 2045 N. Kansas Ave							045 N. Kansas Ave, Topeka, KS							
City: Topeka State: KS ZIP: 66617														
3 LOCATE WELL 4 DEPTH OF COMPLETED WELL: 30 ft 5 Letitude: 38.08745										decimal degrees)				
Doubles Groundwater Encountered: 1) 25 th 1 1 05 66057								(decimal degrees)					
N 2)								3 NAD 27						
	TER LEVEL: ft., measured on (mo-day-yr)				Source for Latitude/Longitude: GPS (unit make/model:)									
NW	below land surface, measured on (mo-day above land surface, measured on (mo-day)													
	Pump test data: Well water was ft.							(WAAS enabled? ☐ Yes ☐ No) ■ Land Survey ☐ Topographic Map						
W	E after hours pumping						Online Mapper:							
sw	SE	after		vater was s pumping						070.00				
				gpm 11.25 in. to30 ft. and				6 Elevat	tion:	872.69	ft. 🔲	Ground	Level TOC	
				in. to 30 ft. and ft.			Source: ■ Land Survey ☐ GPS ☐ Topographic Map ☐ Other							
7 WELL V	WATER TO	DE LICED		in. to)	It.				Oulei				
1. Domestic:				ter Supply: v	well ID			10. □ Oil	l Field	d Water Supply:	lease			
☐ Housel				g: how many				11. Test H	Oil Field Water Supply: lease					
☐ Lawn &		7.	Aquifer R	echarge: well IDg: well ID						☐ Uncased ☐				
☐ Livesto 2. ☐ Irrigati		8. L	」 Monitorin	g: well ID	m: well I	n SVE6	• • • •			l: how many bo Loop 🔲 Horizo				
3. Feedlo). E	Air Sparge	al Remediation: well ID SVE6 BYE6						oop Surface				
4. 🔲 Industr			Recovery		jection			13. □ Oth	her (s	specify):				
Was a chei	mical/bacter	iological sa	mple subm	itted to KI	HE?	Yes 🔳	No	If yes, date	sam	ple was submi	ted:			
	disinfected?													
8 TYPE O	F CASING	USED: □ S	Steel PV	C Other .		CA	ASIN	G JOINTS:	: 🗖 (Glued Clamp	ed 🗌	Welded	Threaded	
Casing diam	etert above land s	in. to surface	π., -0.5 in	Diameter Weight	•••••	. in. to lbs	/ft	II., Diame Wall thicks	ness i	or gauge No. So	h. 40	It.		
	SCREEN OF						., 20.	Wall tillele		or gaage 110				
☐ Steel		nless Steel	☐ Fiber		PVC				er (Sj	pecify)				
Brass		anized Steel			☐ None	used (open	hole))						
	OR PERFOR nuous Slot	Mill Slot		KE: auze Wrappe	а □т	orch Cut	□Dr	illed Holes		Other (Specify) .				
	rad Shutter	T Kay Dung	had \Box W	lira Wrannad	Пς	asy Cut		na (Onan U	010)					
SCREEN-P	ERFORATI	ED INTERV	ALS: Fron	1 .10 ft	. to30	0 ft., Fr	om	ft. to		ft., From .		ft. to	ft.	
SCREEN-PERFORATED INTERVALS: From .10 ft. to 30 ft., From ft. to ft. GRAVEL PACK INTERVALS: From .9 ft. to 30 ft., From ft. to ft. ft. o ft.														
9 GROUT MATERIAL: Neat cement Cement grout Bentonite Other Grout Intervals: From														
Grout Intervals: From														
☐ Septic Tank ☐ Lateral Lines ☐ Pit Privy ☐ Livestock Pens ☐ Insecticide Storage														
☐ Sewer Lines ☐ Cess Pool ☐ Sewage Lagoon ☐ Fuel Storage ☐ Abandoned Water Well														
☐ Watertight Sewer Lines ☐ Secpage Pit ☐ Feedyard ☐ Fertilizer Storage ☐ Oil Well/Gas Well ☐ Other (Specify) Trust Fund site U4-089-14545														
Direction from well? On-site Distance from well? 0 ft.														
10 FROM	TO		LITHOLO			FROI				HO. LOG (cont.)		UGGIN	3 INTERVALS	
		Concrete		-4'ss			_							
0.5 5		Silty Clay, di Silt, gry to di		ed.Stiff										
20		Sand, very f		ning med to	n crse	_								
30		Total Depth	200011	mou. (0100									
Notes:														
11 CONTRACTOR'S OR LANDOWNER'S CERTIFICATION: This water well was constructed, reconstructed, or plugged														
under my ju	urisdiction at	nd was comp	leted on (n	no-day-year	8-15-2	2017	and t	his record is	s true	e to the best of	my ki	iowleds	ge and belief.	
Kansas Wa	ter Well Cor	tractor's Lic	ense No. 5	85	This W	ater Well	Reco	ord was con	plet	e to the best of	year)	3-16-1	8	
under the b	usiness name	on ASSOCI	ateu ⊏n⊻ir `\$5.00 for eac	ch constructed s	vell to: Ka	nsas Denart	Sig	nature	Envir	ormen Ruseau of	Water	GWTSS	ection	
1000	SW Jackson St	., Suite 420, To	peka, Kansas	66612-1367.	Mail one to	Water Well	Owne	er and retain or	ne for	your records. Tele	phone	785-296-	5524.	
	://www.kdheks					KSA 82							7/10/2015	

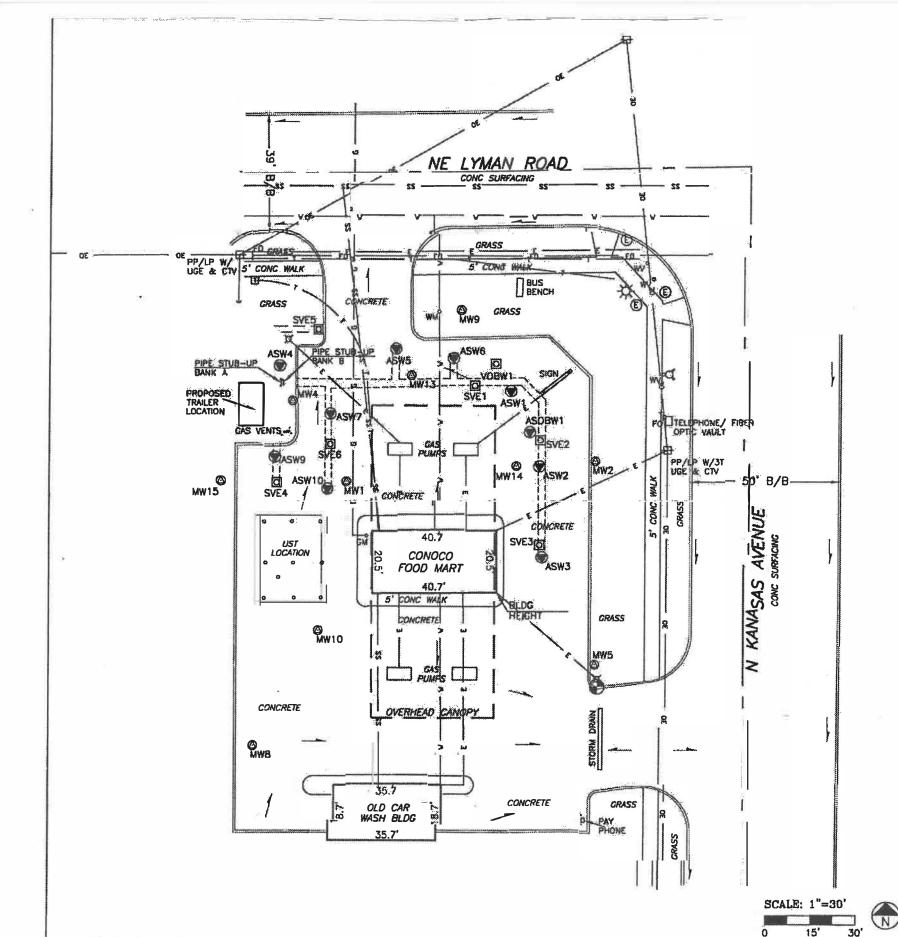

FULL SITE SURVEY

CONOCO FOOD MART

City of Topeka, Shawnee County, Kansas

Point	North Coordinate	Eost Coordinate		From Sec. 20 West	* Elev. Top of Rim or PK Noil	Elev. Top of PVC Pipe	Lotitude North	Longitude West
SE Cor.						8 18		
Sec. 20-T11S-R16E	5000	5000						
Well - M.W	10176.74	2061.80	5176.74	2938.20	873.17	872.70	39.08742	95,66056
Well - M.W 2	10183.14	2143.06	5183.14	2856.94	873.77	873.50	39,08744	95.66027
Well - M.W 4	10203.42	2044.13	5203,42	2955.87	873.43	873.04	39.08749	95.66062
Well - M.W 5	10116.11	2142.81	5116.11	2857,19	873.21	872.84	39,08725	95,85027
Well - M.W B	10089.86	2031,31	5089.85	2988.69	873.11	872.74	39,08718	95.66066
Well - M.W 9	10233,19	2099.68	5233,19	2900.32	873.44	872.99	39.08757	95.66042
Well - N.W 10	10127.57	2052.78	5127.57	2947.22	873.23	872.75	39.08728	95,66059
Well - M.W 11	10177.51	2261.95	5177.51	2738.05	874.05	873.56	39.08742	95,65985
Well - M.W 12	10100.47	2257.05	5100.47	2742.95	873.38	873.09	39.08721	95,65987
Well - M.W. 13	10211.79	2083.28	5211.79	2918.72	873.09	872.78	39.08754	95.66048
Yell - M.W 14	10181.77	2117,44		2882.56	873.34	873.06	39.08749	95,66052
Well - M.W 15	10177.15	2020.82	5177.15	2979,18	872.70	B72.42	39.08739	95,56072
Well ASW1	10205.79	2115.65	5206.79	2884.35	873.35	872.86	39.08747	95,66038
Well - ASW2	10181.59	2124.97	5181.59	2875.03	873.31	873,11	39.08743	95,66033
Well - ASW3	10151.57	2125.72	5151,57	2874.28		872.95	39.08735	95,86033
Well - ASW4	10214.99	2039.92	5214.99	2960.08	873,18	872,76	39.08752	95.66063
Well - ASW5	10220.57	2078,16	5220.57	2921.84	872,92	872.70	39.08754	95.66050
Well - ASW6	10217,40	2097.18	5217.40	2902.82	873,18	873.02	39.08753	95,66043
Hell - ASW7	10199,11	2056.60	5199,11	2943.40	872.88	872.67	39.08748	95.86057
Hell - ASW8					survey. Will ottempt	to locate o	t another lin	ne.
Kell - ASW9	10184.88	2038.37	5184.88	2951.63	872.89	872.60	39.08744	95.66064
Vel - ASW10	10174.37	2055.63	5174.37	2944.37	873.14	872.86	39.08741	95.68058
Vell - ASOBW1	10193.24	2121.87	5193.24	2878,13	873.42	873.03	39.08736	95,66043
Hell - SVE1	10208.27	2104,21	5208.27	2895.79	873,30	872.94	39.08746	95,66041
Hell - SVE2	10190.22	2125.23	5190.22	2874.77	873.43	873.15	39.08746	95.66033
Nell - SVE3	10155.60	2124.89	5155.60	2875.11	873.31	873.12	39.08736	95.58033
Vell - SVE4	10175.40	2039.01	5176,40	2960.99	872.97	872.65	39.08742	95.66064
Well - SVE5		2052.56	5226.90	2947.44	873.06	872.66	39.08756	95,56059
Well - SVE6		2056.53	5189.07	2943,47	873.04	872.69	39.08745	95.66057
Well - VOBW1	10215.59	2110.77	5215.69	2889.23	873.31	873.00	39.08748	95,66039
Site B.M.	10108,93	2143.68	5108.93	2856.34	B.M. Elev. =			

Description: "" Square cut on back of curb on north side of east drive.

LEGE	END
- Site Bench Mork WW10 - Monitoring Well SVE10 - Soil Vapor Extraction Well VOBW10 - Vapor Observation Well ASW10 - Air Sparge Well ASOBW10 - Air Sparge Observation Well PP/LP W/ - Power Pole/Light Pole w/	GMo - Gos Meter [1] - Telephone Pedestal Fo - Fiber Optic Locator Sign - Bollard - Droinage Direction Overhead Power Line E - Underground Electric Line
UGE & CTV PP/LP W/3T	
WMo - Water Meter Wo - Water Valve O - Fire Hydrant	CML

Tim Slotin, P President SVI

42018 Anderson Avenue, Suite 2 • Manhottan, Kansas 66503 (785) 776-0541 • FAX 776-9760 • Emoil: tim@siconandmeler.com Project #1711MN1334 DD #108