WATER WELL		Form WV			Divis	sion of Water	[NANNO
X Original Record	Correction	n Change in	n Well Ust		Resou	rces App. No.		Well ID	MW9
1 LOCATION	OF WATER WE	LL:	Fraction				er Township Nun		
County Shav		···	SE ¼ SE ½			•	T 11	·	6 X E W
	ER: Last Name:		First:				ell is located (if unk		
Business: Jays Address: PO	•				n nearest towr Croco Rd, To): If at owner's ad	dress, check n	ere;
Address: 101	JOX 1170			1343 32	Cioco ica, io	peka, Ko		•	
	ndependence	State: KS	ZIP: 67301	L					
3 LOCATE WE			MPLETED WELL:				***************************************	77(de	cimal degrees)
WITH "X" IN	Dept	h(s) Groundwater	Encountered: 1)	TD W	tt	Longitude	95.613 Datum: WGS	8/	cimal degrees)
SECTION BO	X: Z)	L'S STATIC WA)ft, or 4)[ft, or 4)[Dry wi 2.50	n		Latitude/Longitude		63 [_] NAD 27
l mi			ace, measured on (mo				unit make/model:	•)
'		above land surfa	ace, measured on (mo-	day-yr)			AAS enabled?	Yes No)
NW —	NE Pu	imp test data: Wel	l water was	ft			Survey Topog		
w	E	afterho	ours pumping	gpn	1	Online	: Mapper		
"	1 []		ater well was	ft	.	Floredian	024.62	Ground L	evel X TOC
sw	SE —		ours pumping	gpn	1 6		934.62 ft Land Survey		
		timated Yield:		ft a	nd	Source	Other	013	городгарине мар
S	BC	AS TION DIAMETER.	7.25 in to in to	ft					
1 mile									
	R TO BE USED AS	_							
1 Domestic:	5	Public Water Su					Water Supply: lease		
Household Lawn & Garde	, 6 <u> </u>	Dewatering: hor Aquifer Recharg	•		11	Test Hole: wel	Uncased	Geotechnic	a1
Livestock	. =	Monitoring: we			12	Geothermal: Ho		Geolechine	
2 Irrigation		vironmental Reme				a) Closed Loc		Vertic	al
3 Fcedlot		Air Sparge	Soil Vapor Extr	actior		b) Open Loop		ischarge	
4 Industrial		Recovery	Injection			Other (spe	ecify):		
Was a chemical/bact	riological sample	submitted to KD	HE? Ves X	٦٧٥	If yes, date	e sample was su	hmitted:		
Water well disinfected			[ii yes, dan	e sumple was so			***************************************
8 TYPE OF CA	SING USED:	Steel X PVC	Other		CASING IOI	NTS: Gh	ied Clampled	Welded	X Threaded
Casing diameter			eter in.	to	ft,	Diameter	in. to	ft,	
Casing height above I		27 in. W	eight	lbs.	ft. Well t	hickness or gau	ge No	······································	
TYPE OF SCREEN									
	Stainless Steel	Fiberglass	X PVC			ther (Specify)			,
Brass SCREEN OR PER	Galvanized Steel	Concrete tile	None used (pen hole)					
l		_		C4	□ p. ii.	111-1	O4(0		
Continuous Slo				orch Cut Saw Cut		d Holes (Open Hole)	Other (Specify	')	
SCREEN-PERFORA		ched Wire	ft to 145 ft	From	I Notice	to	ft From	ft. to	ft,
GRAVEL PA	CK INTERVALS	: From 3	ft. to 15 ft	, From	ft.	to	ft, From	ft. to	ft,
9 GROUT MATEI	IAL: Neat of	amont DC		entonite		Concrete: 0-0.			
Grout intervals: Fr			From ft. to						
Nearest source of p			1011	,	11, , 11011				
Septic Tank		Lateral Lines	Pit Privy		Livest	ock Pens	Insecticide	Storage	
Scwer Lines	<u> </u>	Cess Pool	Sewage Lag	oon		Storage	berne	d Water Well	
Watertight Sev	er Lines	Seepage Pit	Feedyard			zer Storage	Oil Well /		
Other (Specity						ū			
Direction from well?			Distance from	n well?	~40		ft		
10 FROM TO		LITHOLO	GIC LOG		FROM	ТО	LITHO. LOG (co	nt.) or PLUGGI	NG INTERVALS
0 0.4									
0.4 6.3									
6.5 14. 14.5 15		e grained					- 1		
14.5	Linestone	73-24-1							

							-N-Shop; U4-089-1		
	3 127				U		hallow groundwater	r, <20' of grout	was installed at
the direction of KDHE.									
11 CONTRACTOR'S OR LANDOWNER'S CERTIFICATION: This water well was X constructed, reconstructed or plugged under my jurisdiction and was completed on (mo-day-year) 5/29/19 and this record is true to the best of my knowledge and belief. Kansas Water Well Contractor's									
License No 757 This Water Well Record was completed on (mo-day-year) 7/2/19									
***************************************	name of Larsen &		vorti mus completed of		- "	Signature		\leq / \sim	,
Maif	1 White copy along wit	h a fce of \$5.00 for e	each constructed well to:	Kansas De	partment of Hea	alth and Environu	nent, Bureat of Water	Gers Section	d
100			as 66612-1367. Mail one		Well Owner and	retain one for yo	ur records. Telephone		# .
Visit us at http://www.kdheks.gov/waterwell/index.html KSA 82a-1212 Revised 7/10/2015									

DENNIS L HANDKE

1820 NW 59th Terrace TOPEKA, KANSAS 66618 785-286-4047 Home 785-217-5864 Cell

Jess Chapman Larsen & Associates 1311 E. 25th Street, Suite B Lawrence, Kansas, 66046 June 7, 2019

RE: Monitor Well Elevation Survey 545 SE Croco Road, Topeka, Kansas Proj. 19-00T Pops Stop-N-Shop U4-089-14702

Bnch Mark: Chisled X on NE bolt in top fire hydrant at Southeast corner of property.

Elev: 949.43		orth 98.84	West 34.77		(from SE Cor. Sec. 10-10-12E)		
MW-1R	rim	935.40	North	100.16	SE1/4,SE1/4,SE1/4		
	top pipe	935.17	West	145.35	Lat= 39.04457 Long = 95.61404		
MW-8	rim	931.11	North	107.79	SE1/4,SE1/4,SE1/4,SE1/4		
	top pipe	930.82	West	261.73	Lat= 39.04459 Long = 95.61445		
MW-9	rim	934.89	North	175.33	SE1/4,SE1/4,SE1/4,SE1/4		
	top pipe	934.62	West	99.64	Lat= 39.04477 Long = 95.61387		
MW-10	rim	930.63	North	196.99	SE1/4,SE1/4,SE1/4,SE1/4		
	top pipe	930.24	West	246.93	Lat= 39.04484 Long = 95.61439		
MW-11	rim	rim 930.28		283.14	SE1/4,SE1/4,SE1/4,SE1/4		
	top pipe	930.00	West	186.38	Lat= 39.04507 Long = 95.61417		
MW-12	rim top pipe	929.19 928.91	North West	214.12 349.46	SW1/4,SE1/4,SE1/4,SE1/4 Lat= 39.04489 Long = 95.61475		
	op p.pe	,_0.,1	050	5	Luc 37.07.107 Doing 70.07.170		

Elevation derived from City of Topeka BM #75.1 NAVD27.


Lat & Long derived from Grantville 7.5' Quad Maps WGS 84.

If you have any questions, please feel free to call me. Thank you for the opportunity to be

of service to you

Dennis L H

15-786

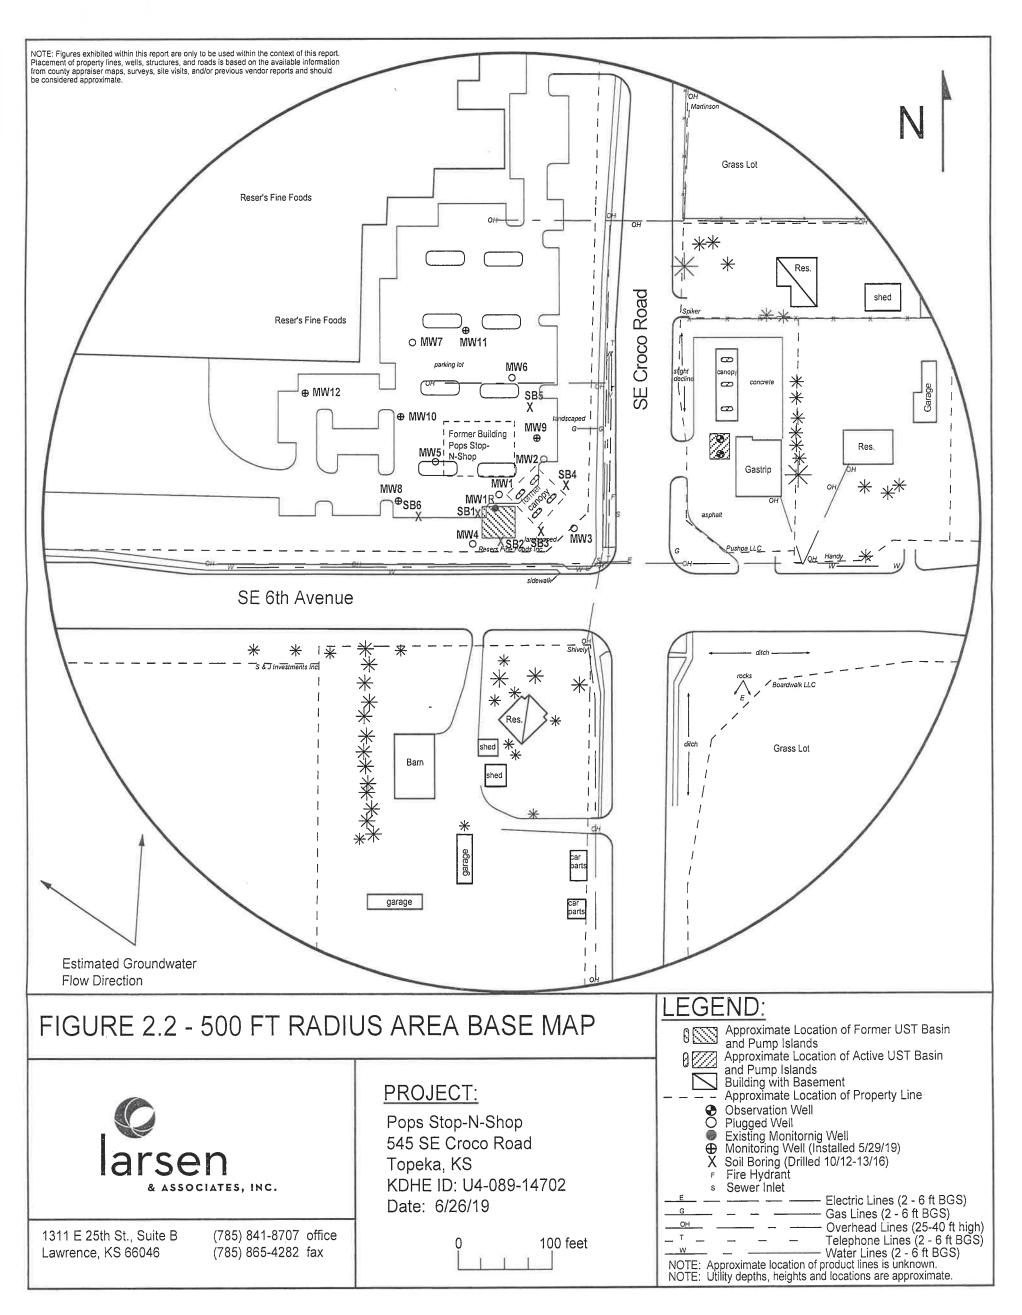

RECEIVED

AUG 0 2 2019