WATER WELL RECORD			vision of Water			MW10
	orrection Change in Well Ust	Rese	ources App. No.		Well ID	
1 LOCATION OF WATEI		W . 05 W . 05 I		Township Nun		
County Shawnee		14 SE 14 SE 1		T 11	<del>-</del>	XE W
2 WELL OWNER: Last Nar Business: Jays Realty, LLC	ne: First:			Il is located (if unk : If at owner's ad	,	
Address: PO Box 1176		545 SE Croco Rd,		. If at owner 5 ac	idiess, eneek ne	٠٠. ا
Address:			. ,			
City Independence	State: KS ZIP: 67301			20.044		
3 LOCATE WELL WITH "X" IN	4 DEPTH OF COMPLETED WELL Depth(s) Groundwater Encountered: 1)		5 Latitude:	39.044 95.614	84 (dec	imal degrees)
SECTION BOX:	2)ft 3)ft, or 4	l) Dry Well	Horizontal	Datum: WGS	84   NAD 8	3 NAD 27
N		9.85 ft.		Latitude/Longitude		- In
	X below land surface, measured on (	mo-day-yr) 6/26/19	GPS (t	mit make/model:		)
NW - NE -	above land surface, measured on (	mo-day-yr)		AAS enabled?		
	Pump test data: Well water was	ft .	==	urvey Topog	raphic Map	
[ W ]E	after hours pumping Water well was	gpm ft	Online	Mapper		
	after hours pumping		6 Elevation	930.24 ft	Ground Le	vel X TOC
SW — SE —	Estimated Yield: gpm		Source X	Land Survey	GPS	Topographic Map
x	Bore Hole Diameter: 7.25 in to	o ft, and		Other		
S	in t	oft				
7 WELL WATER TO BE US	ED AS:					
1 Domestic:	5 Public Water Supply: well ID		10 Oil Field V	Vater Supply: lease	e	
Household	6 Dewatering: how many wells?		11 Test Hole: well			
Lawn & Garden	7 Aquifer Recharge: well ID		Cased [	Uncased	Geotechnica	1
Livestock	8 X Monitoring: well ID MW10		12 Geothermal: Ho	—		
2 Irrigation	9 Environmental Remediation: well ID		a) Closed Loo	· <b>=</b>		
3 Feedlot 4 Industrial	Air Sparge Soil Vapor E	extraction	b) Open Loop Other (spe		ischarge	inj. of Water
			Other (spe			
		X No If yes, d	ate sample was su	bmitted:		***************************************
Water well disinfected? Yes						<b>-</b> 7
8 TYPE OF CASING USED Casing diameter 2 in. to	Steel X PVC Other in	CASING JO	Diameter	ed]Clampled   in. to	Welded [	Threaded
Casing height above land surface	-0.39 in. Weight	lbs./ft. Wel	thickness or gaug	e No	11,	
TYPE OF SCREEN OR PERFO	PRATION MATERIAL:	•••••		***************************************	•••••••••••••••••••••••••••••••••••••••	
Steel Stainless Steel	Fiberglass X PVC		Other (Specify)			
Brass Galvanized St		ed (open hole)				
SCREEN OR PERFORATION			,			•
Continuous Slot X Mi			lled Holes	Other (Specify	′)	<del></del>
Louvered Shutter Ke	ry Punched Wire Wrapped	Saw Cut Nor	ne (Open Hole)	0 E	0. 10	6
GRAVEL PACK INTERV	VALS: From 3 ft. to 11.5  /ALS: From 2 ft. to 12	ft, From	t. to	ft, From	ft. to	ft,
					ft. to	
	Neat cement Coment grout X ft. to 2 ft, From ft		cr Concrete: 0-0.7			
Nearest source of possible conta	mination:		, it.	11,		
Septic Tank	Lateral Lines Pit Privy	, Live	estock Pens	Insecticide	Storage	
Sewer Lines	Cess Pool Sewage		l Storage	=	d Water Well	
Watertight Sewer Lines	Seepage Pit Feedyard		ilizer Storage	Oil Well /	Gas Well	-
Other (Specity)						
Direction from well? SE	Distance	from well? ~130		ft ft		
10 FROM TO	LITHOLOGIC LOG	FROM	TO	LITHO. LOG (co	nt.) or PLUGGIN	GINTERVALS
0   0.4   Asphal	ł					
0.4 11.5 Clayey	silt			· · · · · · · · · · · · · · · · · · ·	***************************************	
0.4 11.5 Clayey	silt					
0.4 11.5 Clayey	silt					
0.4 11.5 Clayey	silt				4500	
0.4 11.5 Clayey	silt			N-Shop, U4-089-1		was installed at
0.4 11.5 Clayey 11.5 12 Limeste	silt	Target of m	onitoring well is sl	N-Shop; U4-089-1 nallow groundwater		vas installed at
0.4 11.5 Clayey 11.5 12 Limeste	silt one  NDOWNER'S CERTIFICATION: This	Target of me the direction water well was	onitoring well is sl	reconstructed, or	r, <20' of grout v	ınder my
11.5 Clayey 11.5 12 Limeste  12 CONTRACTOR'S OR LAN jurisdiction and was completed or	silt one  NDOWNER'S CERTIFICATION: This is in (mo-day-year) 5/29/19 and this r	Target of me the direction water well was X record is true to the best o	onitoring well is sland of KDHE.  constructed, from the same the s	reconstructed, or	r, <20' of grout v	ınder my
11.5 Clayey 11.5 12 Limeste  12 CONTRACTOR'S OR LAN jurisdiction and was completed or License No. 757	NDOWNER'S CERTIFICATION: This is in (mo-day-year) 5/29/19 and this r	Target of method direction water well was X record is true to the best of don (mo-day-year) 7/2/	onitoring well is sl n of KDHE. constructed, f f my knowledge and	reconstructed, or	r, <20' of grout v	ınder my
11.5 Clayey 11.5 12 Limeste  12. Contractor's OR LAN jurisdiction and was completed or License No 757 under the business name of Lar	NDOWNER'S CERTIFICATION: This is in (mo-day-year) 5/29/19 and this region. This Water Well Record was completed sen & Associates, Inc.	Target of method direction water well was X record is true to the best of d on (mo-day-year) 7/2/	onitoring well is sland KDHE. constructed, from the knowledge and the Signature	reconstructed, or and belief.	plugged Water Will Con	inder my
11.5 Clayey 11.5 12 Limeste  12. Limeste  13. CONTRACTOR'S OR LAN jurisdiction and was completed of License No	NDOWNER'S CERTIFICATION: This is in (mo-day-year) 5/29/19 and this r	Target of method direction water well was X record is true to the best of d on (mo-day-year) 7/2/	onitoring well is sland KDHE. constructed, from the knowledge and signature  Signature	reconstructed, or nd belief. Kansas	plugged Water Well Con	inder my

## **DENNIS L HANDKE**

1820 NW 59th Terrace TOPEKA, KANSAS 66618 785-286-4047 Home 785-217-5864 Cell

Jess Chapman Larsen & Associates 1311 E. 25<sup>th</sup> Street, Suite B Lawrence, Kansas, 66046 June 7, 2019

RE: Monitor Well Elevation Survey 545 SE Croco Road, Topeka, Kansas Proj. 19-00T Pops Stop-N-Shop U4-089-14702

Bnch Mark: Chisled X on NE bolt in top fire hydrant at Southeast corner of property.

Elev: 949.	.43 No	orth 98.84	West	34.77	(from SE Cor. Sec. 10-10-12E)
MW-1R	rim	935.40	North	100.16	SE1/4,SE1/4,SE1/4,SE1/4
	top pipe	935.17	West	145.35	Lat= 39.04457 Long = 95.61404
MW-8	rim	931.11	North	107.79	SE1/4,SE1/4,SE1/4,SE1/4
	top pipe	930.82	West	261.73	Lat= 39.04459 Long = 95.61445
MW-9	rim	934.89	North	175.33	SE1/4,SE1/4,SE1/4,SE1/4
	top pipe	934.62	West	99.64	Lat= 39.04477 Long = 95.61387
MW-10	rim	930.63	North	196.99	SE1/4,SE1/4,SE1/4,SE1/4
	top pipe	930.24	West	246.93	Lat= 39.04484 Long = 95.61439
MW-11	rim	930.28	North	283.14	SE1/4,SE1/4,SE1/4,SE1/4
	top pipe	930.00	West	186.38	Lat= 39.04507 Long = 95.61417
MW-12	rim	929.19	North	214.12	SW1/4,SE1/4,SE1/4,SE1/4
	top pipe	928.91	West	349.46	Lat= 39.04489 Long = 95.61475

Elevation derived from City of Topeka BM #75.1 NAVD27.


Lat & Long derived from Grantville 7.5' Quad Maps WGS 84.

If you have any questions, please feel free to call me. Thank you for the opportunity to be

of service to you

Dennis L H

15-786

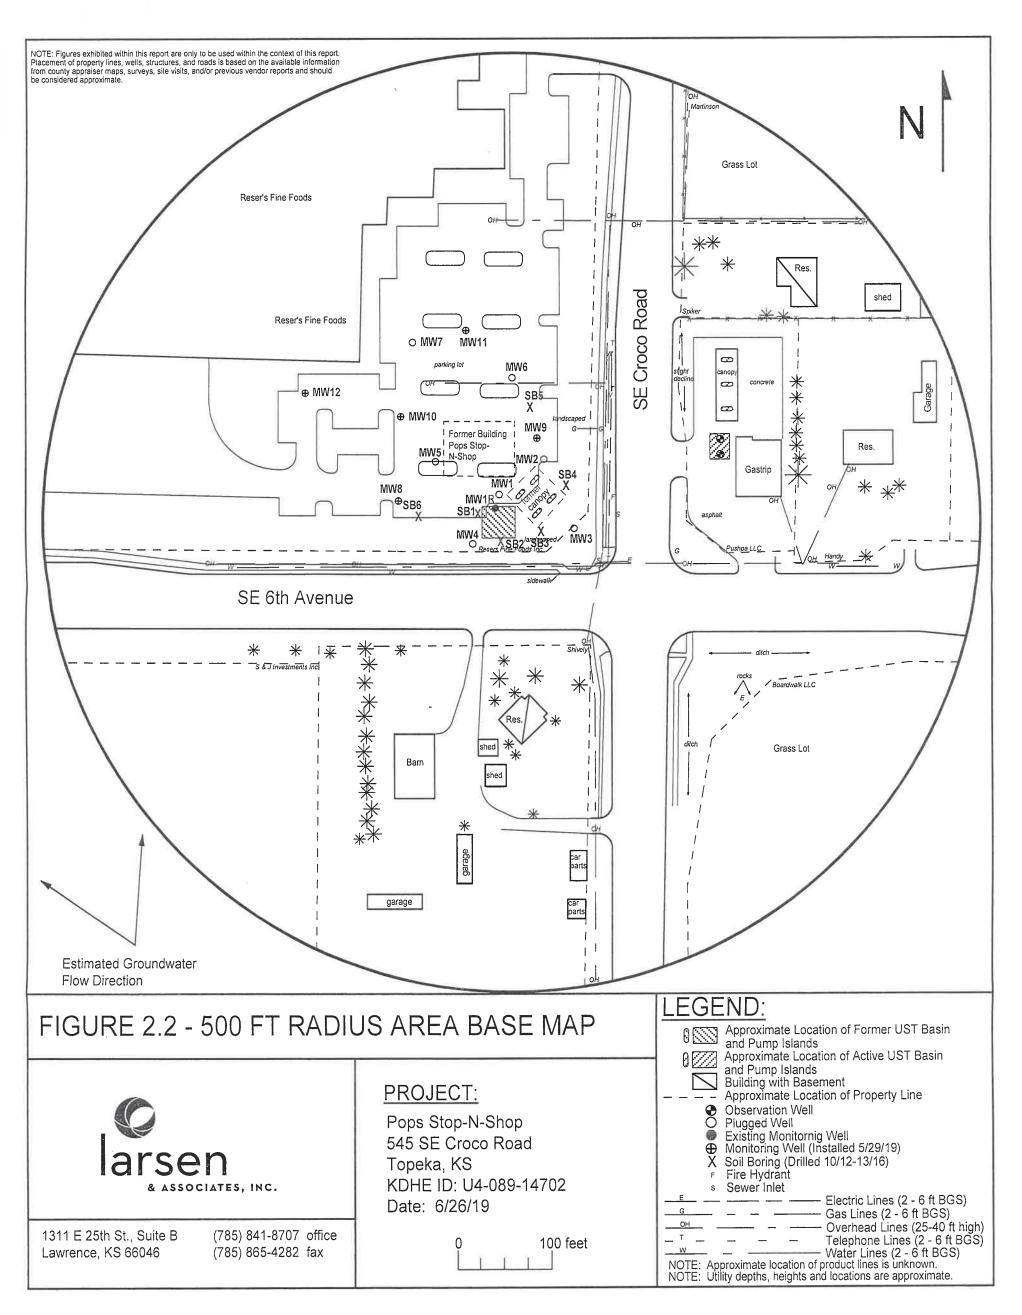

RECEIVED

AUG 0 2 2019