WATER WELL RE				vision of Water			N/XX/11		
X Original Record	Correction Chang	e in Well Ust	Rcs	ources App. No.		Well ID	MW11		
1 LOCATION OF	WATER WELL:	Fraction			er Township Nun				
County Shawnee		SE ¼ SE ¼	SE ¼ SE		T 11		5 <u> X </u>		
2 WELL OWNER:									
Business: Jays Reals Address: PO Box 1	··								
Address: PO Box 1	170		545 SE CIOCO RO,	горска, къ					
	endence State: KS	ZIP: 67301							
3 LOCATE WELL	4 DEPTH OF	COMPLETED WELL:	18.5 ft	5 Latitude:	39,045	507 (dec	imal degrees)		
WITH "X" IN	Depth(s) Groundwat	er Encountered: 1)	ft	Longitudo	<u></u>	17(dec	imal degrees)		
SECTION BOX:	2) ft	3)ft, or 4)l		Horizontal		_	3 NAD.27		
N N	WELL'S STATIC W		********						
	X below land s	urface, measured on (mo-da	y-yr)0/20/19	6/26/19 GPS (unit make/model:					
NW — NE	Pump test data: V	orface, measured on (mo-da Vell water was	y-yr)	(WAAS cnabled? Yes No) X Land Survey Topographic Map					
	, ,	hours pumping		=	: Mapper	,.upvup			
w	— E	Water well was	ft		· ·····pe·				
SW SE	after	hours pumping	gpm	6 Elevation	930.00 ft	Ground Lev	vel X TOC		
	Estimated Yield:	gpm		Source X	Land Survey	GPS 🔲	Гороgraphic Мар		
	x Bore Hole Diame	er: 7.25 in to	ft, and		Other		********************************		
s	· ·	in to	ft						
7 WELL WATER TO									
1 Domestic:		Supply: well ID		10 Oil Field	Water Supply: lease	e			
Household	=	how many wells?		11 Test Hole: wel					
Lawn & Garden	7 Aquifer Rech	•		Cased	Uncased	Geotechnical	<u> </u>		
Livestock	8 X Monitoring:	well ID MW11		12 Geothermal: Ho	ow many bores?				
2 Irrigation	9 Environmental Re	mediation: well ID		a) Closed Loc	op 🔲 Horizonta	l Vertical	1		
3 Feedlot	Air Sparge	Soil Vapor Extract	ior	b) Open Loop Surface Discharge Inj. of Water					
4 Industrial	Recovery	Injection		Other (spe	ecify):				
Was a chemical/bacteriole	gical sample submitted to I	CDHE? Yes X	No If yes, d	late sample was su	ıbmitted:	<u>-</u>			
Water well disinfected?	Yes X No	. — —	, ,	•	***************************************				
8 TYPE OF CASING	GUSED: Steel X PV	C Other	CASING J	OINTS: GIL	led Clampled	Welded	Threaded		
Casing diameter 2	in. to 8.5 ft, Dia	imeter in. t	o ft,	Diameter	in. to	ft,	-		
Casing height above land su	irface -0.28 in.	Weight	lbs./ft. Wel	l thickness or gaug	ge No				
· — —	PERFORATION MATER		_						
	ess Steel Fiberglass	<u> </u>		Other (Specify)	w.m.a	· · · · · · · · · · · · · · · · · · ·			
. — —	nized Steel Concrete	tile None used (ope	n hole)						
	ATION OPENINGS ARE:	🗆							
Continuous Slot	X Mill Slot G	''. 📙 .		lled Holes	Other (Specify	<u>') </u>			
Louvered Shutter	Key Punched W	ire Wrapped Saw	Cut No	ne (Open Hole)	Α Γ	Α			
GRAVEL PACK I	INTERVALS: From 8.5 NTERVALS: From 7	ft. to 19 ft,	From	п. 10 Н to	ft From	ft. to	п,		
					ft, From	π. το	ft,		
9 GROUT MATERIAL		Cement grout X Bent		er Concrete: 0-0.		***************************************	***************************************		
Grout intervals: From		From ft. to	ft, Fr	omft.	toft,				
Nearest source of possib			— .						
Septic Tank	Lateral Lines	Pit Privy	=	estock Pens	Insecticide				
Sewer Lines	Cess Pool	Sewage Lagoor	=	l Storage		d Water Well			
Watertight Sewer Lines Scepage Pit Feedyard Fertilizer Storage Oil Well / Gas Well									
Other (Specity) Direction from well? S-SE		Distance from v			6				
} — — — — — — — — — — — — — — — — — — —	LIPIO			T 70					
10 FROM TO 0.4	Asphalt	OGIC LOG	FROM	TO	LITHO. LOG (co	nt.) or PLUGGING	INTERVALS_		
0.4 9	Clayey silt	·				1 400			
9 18.5	Silty sand, fine grained, grave	1					, ,		
18.5 19	Limestone								
					N. O	4000			
1.1					-N-Shop; U4-089-1		una imatall-3-4		
Target of monitoring well is shallow groundwater, <20' of grout was installed at the direction of KDHE.									
11 CONTRACTOR'S OR LANDOWNER'S CERTIFICATION: This water well was X constructed, or plugged under my									
jurisdiction and was completed on (mo-day-year) 5/29/19 and this record is true to the best of my knowledge and belief. K as as water Vell Contractor's									
License No 757 This Water Well Record was completed on (mo-day-year) 7/2/19									
under the business name of Larsen & Associates, Inc. Signature									
Mail I white copy along with a fee of \$5,00 for each constructed well to: Kansas Department of Health and Environment, Black Control of West Section,									
1000 SW	1000 SW Jackson St., Suite 420, Topeka, Kansas 66612-1367. Mail one to Water Well Owner and retain one for your records. Telephone 763-296-5524. Visit us at http://www.kdheks.gov/waterwell/index.html KSA 82a-1212 Revised 7/10/2015								
	theks.gov/waterwell/index.html								

DENNIS L HANDKE

1820 NW 59th Terrace TOPEKA, KANSAS 66618 785-286-4047 Home 785-217-5864 Cell

Jess Chapman Larsen & Associates 1311 E. 25th Street, Suite B Lawrence, Kansas, 66046 June 7, 2019

RE: Monitor Well Elevation Survey 545 SE Croco Road, Topeka, Kansas Proj. 19-00T Pops Stop-N-Shop U4-089-14702

Bnch Mark: Chisled X on NE bolt in top fire hydrant at Southeast corner of property.

Elev: 949.	.43 No	orth 98.84	West	34.77	(from SE Cor. Sec. 10-10-12E)
MW-1R	rim	935.40	North	100.16	SE1/4,SE1/4,SE1/4
	top pipe	935.17	West	145.35	Lat= 39.04457 Long = 95.61404
MW-8	rim	931.11	North	107.79	SE1/4,SE1/4,SE1/4,SE1/4
	top pipe	930.82	West	261.73	Lat= 39.04459 Long = 95.61445
MW-9	rim	934.89	North	175.33	SE1/4,SE1/4,SE1/4,SE1/4
	top pipe	934.62	West	99.64	Lat= 39.04477 Long = 95.61387
MW-10	rim	930.63	North	196.99	SE1/4,SE1/4,SE1/4,SE1/4
	top pipe	930.24	West	246.93	Lat= 39.04484 Long = 95.61439
MW-11	rim	930.28	North	283.14	SE1/4,SE1/4,SE1/4,SE1/4
	top pipe	930.00	West	186.38	Lat= 39.04507 Long = 95.61417
MW-12	rim top pipe	929.19 928.91	North West	214.12 349.46	SW1/4,SE1/4,SE1/4,SE1/4 Lat= 39.04489 Long = 95.61475
	op p.pe	,_0.,1	050	5	Luc 37.07.107 Doing 70.07.170

Elevation derived from City of Topeka BM #75.1 NAVD27.


Lat & Long derived from Grantville 7.5' Quad Maps WGS 84.

If you have any questions, please feel free to call me. Thank you for the opportunity to be

of service to you

Dennis L H

15-786

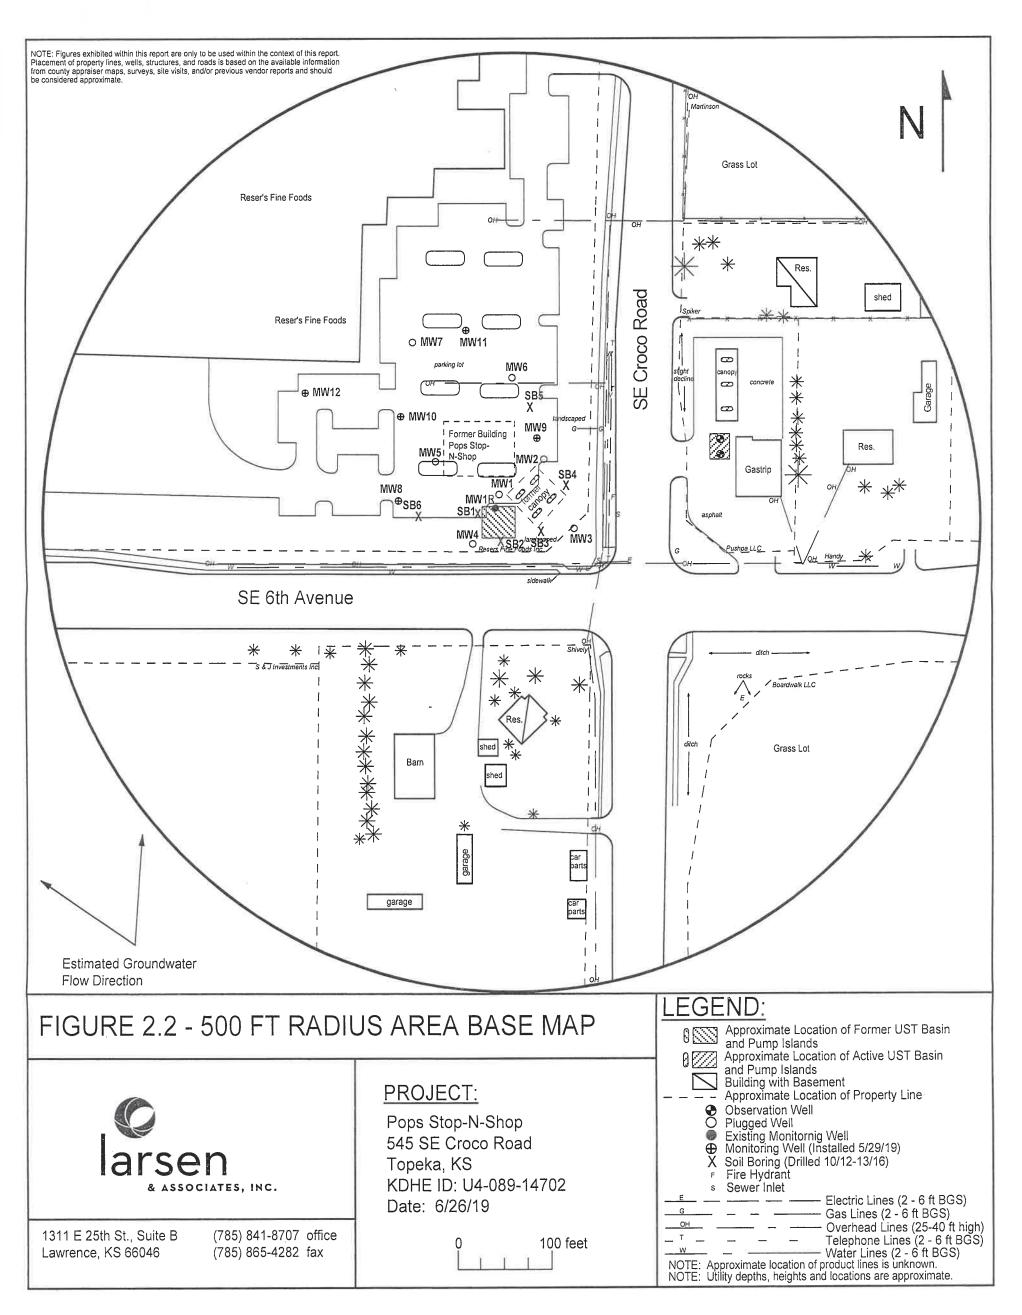

RECEIVED

AUG 0 2 2019