

						KSMW-10		
	Correction Char			irces App. No.	I . 1: N . 1	Well ID		
1 LOCATION OF W	ATER WELL:	Fraction		ion Number 31	Township Numb	R 16 E W		
county.								
Business: KDHE	ast Name:	First:	direction from no	earest town or inte	ersection): If at owne	r's address, check here:		
Address: 1000 SW			) South Kansas Avenue					
Address: Topeka				a, KS 66612				
City: Topeka  3 LOCATE WELL				1	00.0545	07		
4 DEPTH OF COMPLETED WELL:								
SECTION BOX:	Depth(s) Groundwate		Longitude: -95.673175 (decimal degrees) Horizontal Datum: ■ WGS 84 □ NAD 83 □ NAD 27					
N		3)N/A ft., or 4)			I Datum: WGS 8 r Latitude/Longitude			
	WELL'S STATIC WATER LEVEL:					·····)		
NWNE					(WAAS enabled?			
×	Pump test data: Well	water wasN/A	ft.	■ Land Survey ☐ Topographic Map				
W	anerw. not	afterN/A. hours pumping N/A				☐ Online Mapper:		
SWSE	after N/A hou	after N/A hours pumping N/A gpm						
	Estimated Yield:N/Agpm			6 Elevation: 931.00				
S	Bore Hole Diameter:	Bore Hole Diameter: 7.25 in. to 26.0 ft. and			Source: ■ Land Survey □ GPS □ Topographic Map □ Other			
1 mile		6.0 in to 29.0	? ft.		] Ошег			
7 WELL WATER TO 1. Domestic:		Vater Supply: well ID		10 C Oil Fi	eld Water Sumply: 1	POCP		
☐ Household		ing: how many wells?		10. Oil Field Water Supply: lease				
☐ Lawn & Garden				☐ Cased ☐ Uncased ☐ Geotechnical				
Livestock		7. ☐ Aquifer Recharge: well ID			12. Geothermal: how many bores?			
2. Irrigation		9. Environmental Remediation: well ID			a) Closed Loop			
3. ☐ Feedlot 4. ☐ Industrial	☐ Recover		Extraction			ischarge in inj. of water		
			I Vac No			ed:		
Water well disinfected		minted to KDHE!	lies No	II yes, date sa	imple was submitte	Д		
8 TYPE OF CASING	LISED. Steel P	VC  Other	CASIN	G JOINTS: F	☐ Glued ☐ Clampe	d Welded Threaded		
Casing diameter2	in. to 19.0	t., Diameter N/A	in. toN/A	ft., Diamete	N/A in to	N/A ft.		
Casing diameter 2 in to 19.0 ft., Diameter N/A in to N/A ft., Diameter N/A in to N/A ft.  Casing height above land surface 0 in Weight N/A lbs/ft. Wall thickness or gauge No. Sch. 40								
TYPE OF SCREEN OR PERFORATION MATERIAL:								
☐ Steel     ☐ Stainless Steel     ☐ Fiberglass     ☐ PVC     ☐ Other (Specify)       ☐ Brass     ☐ Galvanized Steel     ☐ Concrete tile     ☐ None used (open hole)								
☐ Brass ☐ Galvanized Steel ☐ Concrete tile ☐ None used (open hole)  SCREEN OR PERFORATION OPENINGS ARE:								
☐ Continuous Slot ■ Mill Slot ☐ Gauze Wrapped ☐ Torch Cut ☐ Drilled Holes ☐ Other (Specify)								
□ Louvered Shutter □ Key Punched □ Wire Wrapped □ Saw Cut □ None (Open Hole)								
SCREEN-PERFORATED INTERVALS: From 19.0 ft. to 29.0 ft., From NA ft. to NA ft., From NA ft. to NA ft.								
GRAVEL PACK INTERVALS: From 17.0 ft. to 29.0 ft., From N/A ft., From N/A ft. from N/A ft. to N/A ft.								
9 GROUT MATERIAL: Neat cement Cement grout Bentonite Other Concrete 0 to 2								
Grout Intervals: From 2 ft. to 17.0 ft., From N/A ft. to N/A ft., From N/A ft. to N/A ft.								
Septic Tank Lines Pit Privy Livestock Pens Insecticide Storage								
☐ Sewer Lines ☐ Cess Pool ☐ Sewage Lagoon ☐ Fuel Storage ☐ Abandoned Water Well								
Watertight Sewer Li	ines	it Feedyard		Fertilizer Storag	ge Oil W	ell/Gas Well		
Direction from well?		Distance from	well?		6			
10 FROM TO		OGIC LOG	FROM			F PLUGGING INTERVALS		
					*			
						Water the second		
			37.					
	Notes:							
11 CONTRACTOR'	S OR LANDOWNER	'S CERTIFICATIO	N: This water	well was	constructed.   rec	onstructed, or plugged		
11 CONTRACTOR'S OR LANDOWNER'S CERTIFICATION: This water well was constructed, reconstructed, or plugged under my jurisdiction and was completed on (mo-day-year) 3-22-2023 and this record is true to the best of my knowledge and belief.								
Kansas Water Well Contractor's License No. 759 This Water Well Record was completed on (phoday-year) 4/15/2023								
under the business nam	under the business name of RAZEK Environmental LLC Signature							
1000 SW Jackson St., Suite 420, Topeka, Kansas 66612-1367. Mail one to Water Well Owner and retain one for your records. Telephone 785-296-5524.								
Visit us at http://www.kdheks.gov/waterwell/index.html KSA 82a-1212 Revised 7/10/2015								

TILL R. 16 E Sec. 31 Showness County

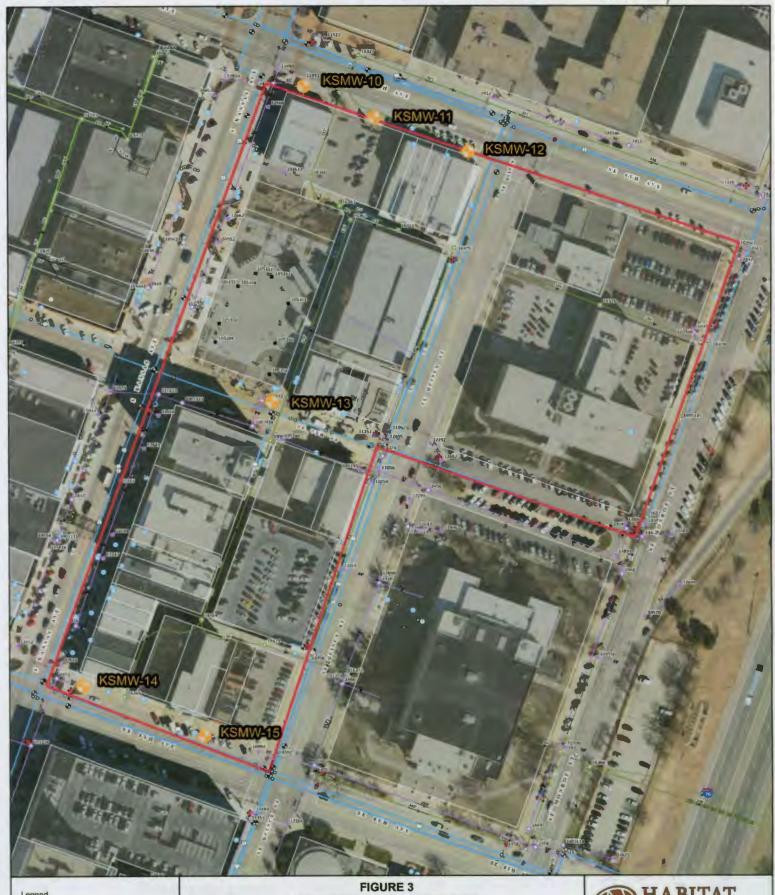

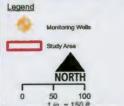

## MONITORING WELL LOCATIONS

PCE - SOUTH KANSAS AVENUE SI2 - SITE INSPECTION 600 TO 800 SOUTH KANSAS AVENUE, TOPEKA, KANSAS

KDHE#: C4-089-73558

Source: NAIP 2019 and 2021 Google Earth || Location: SE 1/4 of Sec 31 - T11S - R16E, Shawnee County, KS



Drawn By: J Polak

Project Manager: J Polak

Date: 02/01/2023

## T.11 R.16E Sec. 31 Showner County

Project: PCE-South Kansas Aven Project Location: Topeka, Shawnee Coun Kansas Project Number: \$A08973558004HAB		Log of Boring KSMW-10 Sheet 1 of 1		
Date(s) Drilled 3/22/23	Logged By Chris Carey, P.G.	Checked By Ryan Weiser, P.G.		
Drilling Method HSA/Air Rotary	Drill String	Total Depth 29 of Borehole		
Drill Rig Type GeoProbe	Drilling Contractor Razek	Surface Elevation		
Static Water Level and GW Elevation	Sampling Method(s)	TOC Elevation		
Borehole Backfill	Location			
Elevation (feet)  Depth (feet) Sample Type Sample Number PID Reading, ppm	MATERIAL DESCRIPTION  Topsoil/Mulch  Brown Clay, silty, moist, slightly plastic, no	REMARKS AND OTHER TESTS		
- 5 CL-ML - 10 15	As above, brown clay, slightly sandy, moderate plasticity	HSA: 0-26 Air Rotary 26-29		