

WATER WELL RECORD

Form WWC-5


Division of Water Resources App. No.

Well ID MW24

Original Record Correction Change in Well Use

1 LOCATION OF WATER WELL: Fraction Section Number Township Number Range Number

2 WELL OWNER: Last Name: Business: Address: City: State: ZIP: Street or Rural Address where well is located

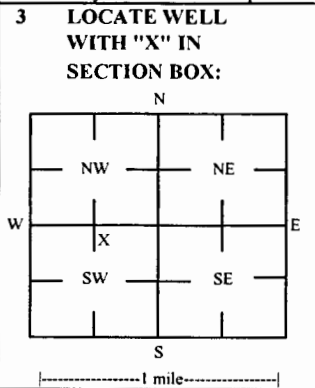

3 LOCATE WELL WITH 'X' IN SECTION BOX: 4 DEPTH OF COMPLETED WELL: 5 Latitude: Longitude: Horizontal Datum

6 Elevation: Source: 7 WELL WATER TO BE USED AS: 1 Domestic: 2 Irrigation: 3 Feedlot: 4 Industrial: 5 Public Water Supply: 6 Dewatering: 7 Aquifer Recharge: 8 Monitoring: 9 Environmental Remediation: 10 Oil Field Water Supply: 11 Test Hole: 12 Geothermal:

8 TYPE OF CASING USED: CASING JOINTS: TYPE OF SCREEN OR PERFORATION MATERIAL: SCREEN OR PERFORATION OPENINGS ARE: SCREEN-PERFORATED INTERVALS: GRAVEL PACK INTERVALS: 9 GROUT MATERIAL: Nearest source of possible contamination: Direction from well? Distance from well?

Table with columns: FROM, TO, LITHOLOGIC LOG, FROM, TO, LITHO. LOG (cont.) or PLUGGING INTERVALS

11 CONTRACTOR'S OR LANDOWNER'S CERTIFICATION: This water well was constructed, reconstructed, or plugged under my jurisdiction and was completed on (mo-day-year) 3/29/23 and this record is true to the best of my knowledge and belief.

Sec. 17 T. 11 R. 16E
Shawnee County

NOTE: Figures exhibited within this report are only to be used within the context of this report. Placement of property lines, wells, structures, and roads is based on the available information from county appraiser maps, surveys, site visits, and/or previous vendor reports and should be considered approximate.

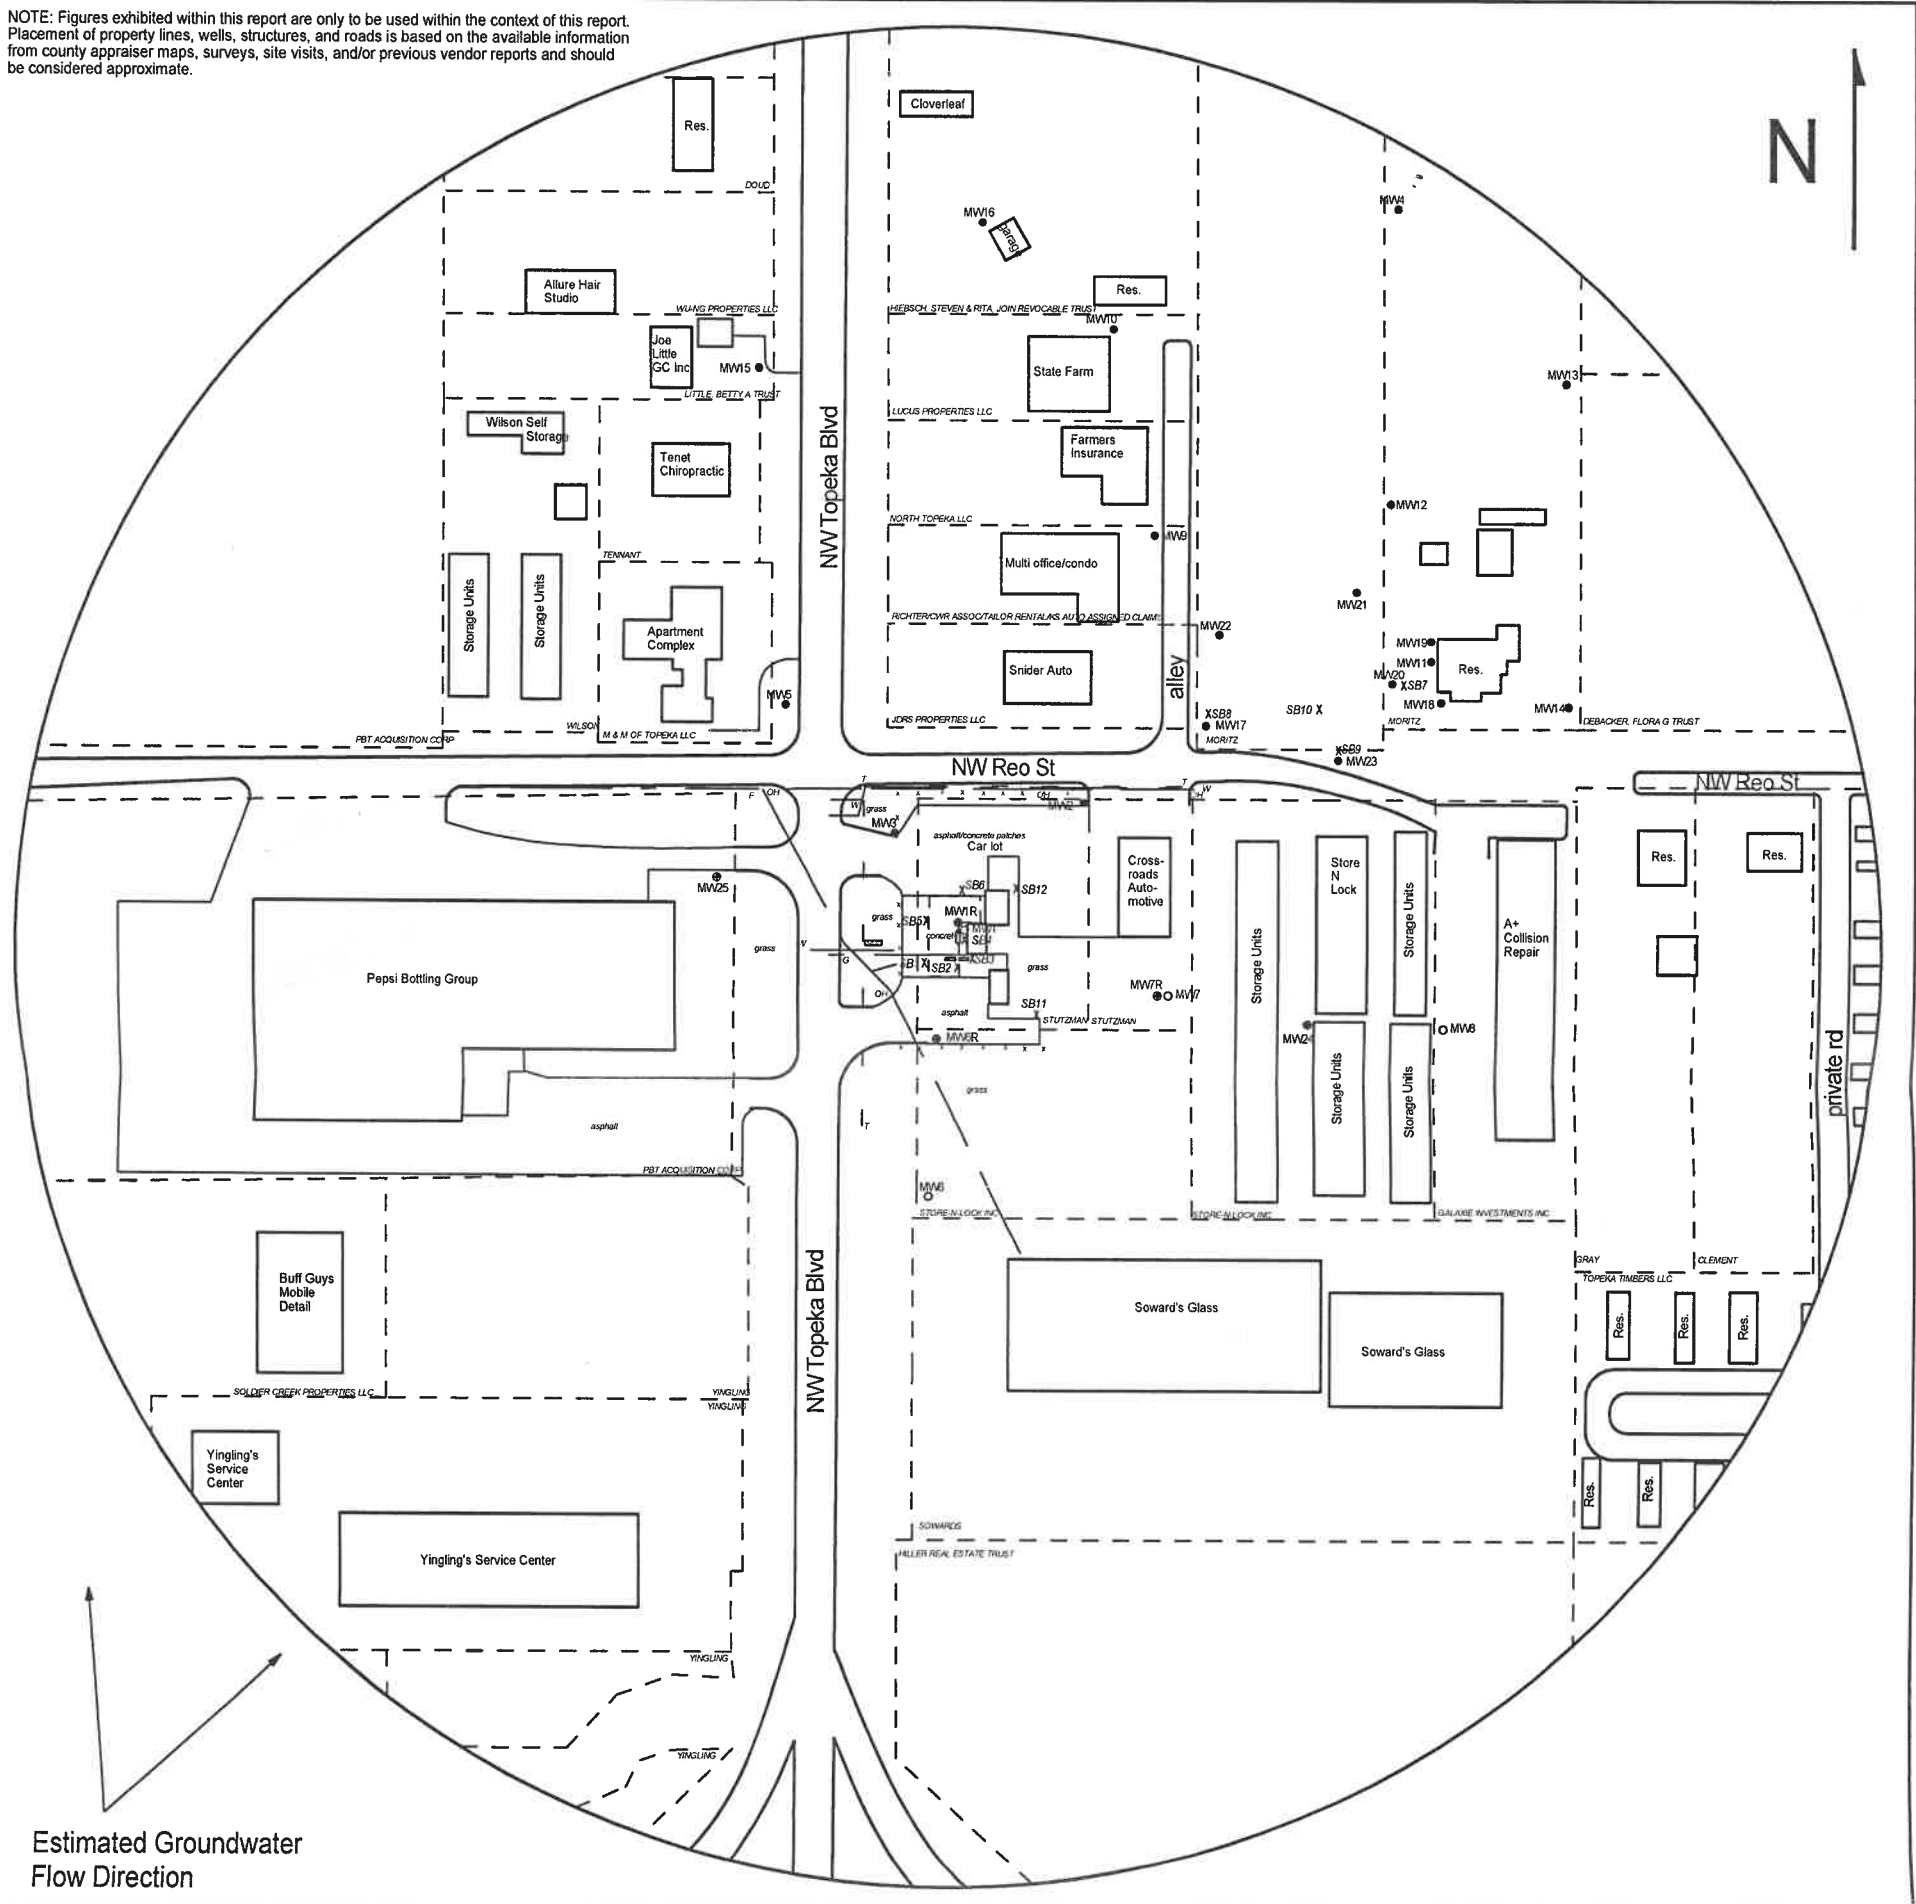


FIGURE 2.2 - 800 FT RADIUS AREA BASE MAP



1311 E 25th St., Suite B
Lawrence, KS 66046

785-841-8707 office
785-865-4282 fax

PROJECT:
Graffiti Auto Sales
2640 Northwest Topeka Blvd,
Topeka, KS
KDHE ID: U4-089-01026
Date: 4/3/23



LEGEND

- Approximate Location of Former UST Basin, Product Lines & Pump Islands
- Excavation Area
- Approximate Location of Property Line
- Existing Monitoring Well
- New Monitoring Well (Installed 3/27-30/23)
- Plugged Monitoring Well
- Soil Boring (Drilled 3/27-29/23)
- Fire Hydrant
- Gas Lines (1.5 - 3 ft bgs)
- Overhead Lines (25'-40' high)
- Telephone Lines (2 - 6 ft bgs)
- Water Lines (2 - 6 ft bgs)

NOTE: SB11 & SB12 were drilled to collect hydrologic samples.
NOTE: Utility depths, heights and locations are approximate.

DENNIS L HANDKE

1820 NW 59th Terrace
TOPEKA, KANSAS 66618
785-286-4047 Home

Jess Chapman
Larsen & Assoc.
1311 E. 25th St., Suite B
Topeka, Kansas 66046

*Sec. 17 T. 11 R. 16E
Shawnee County*

April 11, 2023

RE: Monitor Well Elevation Survey
2640 NW Topeka Blvd., Topeka, Kansas

Proj. 23-00N
Graffiti Auto Sales
KDHE ID U4-089-01026

Bench Mark: Chisled Sq. on NW corner of concrete floor of the North building.
Elev.: 889.66 North 2585.50 West 1489.39 (from SE Cor. Sec. 17-11-16E)

MW-1R	rim	887.91	North 2561.26	NW1/4,NW1/4,NE1/4,SW1/4
	top pipe	887.56	East 1456.07	Lat = 39.09461 Long = 95.66426
MW-6R	rim	886.92	North 2464.06	NW1/4,NW1/4,NE1/4,SW1/4
	top pipe	886.51	East 1445.68	Lat = 39.09434 Long = 95.66430
MW-7R	rim	886.71	North 2497.85	NW1/4,NW1/4,NE1/4,SW1/4
	top pipe	886.25	East 1638.22	Lat = 39.09443 Long = 95.66362
MW-24	rim	885.60	North 2474.59	NE1/4,NW1/4,NE1/4,SW1/4
	top pipe	885.33	East 1761.42	Lat = 39.09437 Long = 95.66319
MW-25	rim	877.33	North 2603.41	NE1/4,NE1/4,NW1/4,SW1/4
	top pipe	876.95	East 1261.24	Lat = 39.09473 Long = 95.66495

Lat & Long derived from Topeka 7.5' quad map. WGS84.

Elevation derived from City of Topeka BM #51. NAVD 88.

There is no SE Corner of Section 17 due to the Kaw Half Breed Reserve #5.
Location of wells are from the SW corner of Section 17.

If you have any questions, please feel free to call me. Thank you for the opportunity to be of service to you.

