

WATER WELL RECORD Form WWC-5

Division of Water Resources App. No.

Well ID MW-2

Original Record Correction Change in Well Use

1 LOCATION OF WATER WELL: County: Wyandotte	Fraction NW¼ SE¼ NE¼ NW¼	Section Number 27	Township Number T 11 S	Range Number R 24 <input checked="" type="checkbox"/> E <input type="checkbox"/> W
---	-----------------------------	----------------------	---------------------------	---

2 WELL OWNER: Last Name: Perry First: Frank Business: Perry & Perry, LLC Address: 2800 W. 118th Street Address: City: Leawood State: KS ZIP: 66211	Street or Rural Address where well is located (if unknown, distance and direction from nearest town or intersection): If at owner's address, check here: <input type="checkbox"/> 6666 Inland Drive, Kansas City, KS 66106
---	---

3 LOCATE WELL WITH "X" IN SECTION BOX: N <table style="width: 100%; text-align: center; border-collapse: collapse;"> <tr> <td style="border: 1px solid black; width: 25px; height: 25px;"></td> <td style="border: 1px solid black; width: 25px; height: 25px;"></td> </tr> <tr> <td style="border: 1px solid black; width: 25px; height: 25px;"></td> <td style="border: 1px solid black; width: 25px; height: 25px;"></td> </tr> </table> W E S [-----1 mile-----]					4 DEPTH OF COMPLETED WELL: ...40.17... ft. Depth(s) Groundwater Encountered: 1) ...31.30... ft. 2) ft. 3) ft., or 4) <input type="checkbox"/> Dry Well WELL'S STATIC WATER LEVEL: ...31.30... ft. <input checked="" type="checkbox"/> below land surface, measured on (mo-day-yr) ...01-06-20... <input type="checkbox"/> above land surface, measured on (mo-day-yr)..... Pump test data: Well water was ft. after..... hours pumping gpm Well water was ft. after..... hours pumping gpm Estimated Yield:gpm Bore Hole Diameter: ...8.25... in. to ...40.17... ft. and in. to ft.	5 Latitude: 39.071294.....(decimal degrees) Longitude: 94.734844.....(decimal degrees) Horizontal Datum: <input type="checkbox"/> WGS 84 <input type="checkbox"/> NAD 83 <input type="checkbox"/> NAD 27 Source for Latitude/Longitude: <input type="checkbox"/> GPS (unit make/model:) (WAAS enabled? <input type="checkbox"/> Yes <input type="checkbox"/> No) <input type="checkbox"/> Land Survey <input type="checkbox"/> Topographic Map <input checked="" type="checkbox"/> Online Mapper: Google Earth <hr/> 6 Elevation: 765.....ft. <input checked="" type="checkbox"/> Ground Level <input type="checkbox"/> TOC Source: <input type="checkbox"/> Land Survey <input type="checkbox"/> GPS <input type="checkbox"/> Topographic Map <input checked="" type="checkbox"/> Other Google Earth

7 WELL WATER TO BE USED AS:

1. Domestic: <input type="checkbox"/> Household <input type="checkbox"/> Lawn & Garden <input type="checkbox"/> Livestock 2. <input type="checkbox"/> Irrigation 3. <input type="checkbox"/> Feedlot 4. <input type="checkbox"/> Industrial	5. <input type="checkbox"/> Public Water Supply: well ID 6. <input type="checkbox"/> Dewatering: how many wells? 7. <input type="checkbox"/> Aquifer Recharge: well ID 8. <input checked="" type="checkbox"/> Monitoring: well ID MW-2 9. Environmental Remediation: well ID <input type="checkbox"/> Air Sparge <input type="checkbox"/> Soil Vapor Extraction <input type="checkbox"/> Recovery <input type="checkbox"/> Injection	10. <input type="checkbox"/> Oil Field Water Supply: lease 11. Test Hole: well ID <input type="checkbox"/> Cased <input type="checkbox"/> Uncased <input type="checkbox"/> Geotechnical 12. Geothermal: how many bores? a) Closed Loop <input type="checkbox"/> Horizontal <input type="checkbox"/> Vertical b) Open Loop <input type="checkbox"/> Surface Discharge <input type="checkbox"/> Inj. of Water 13. <input type="checkbox"/> Other (specify):
---	--	---

Was a chemical/bacteriological sample submitted to KDHE? Yes No If yes, date sample was submitted:

Water well disinfected? Yes No

8 TYPE OF CASING USED: Steel PVC Other CASING JOINTS: Glued Clamped Welded Threaded
 Casing diameter 2.0..... in. to 20.17..... ft., Diameter in. to ft., Diameter in. to ft.
 Casing height above land surface 3.00..... in. Weight lbs./ft. Wall thickness or gauge No. Sch. 40.....

TYPE OF SCREEN OR PERFORATION MATERIAL:
 Steel Stainless Steel Fiberglass PVC Other (Specify)
 Brass Galvanized Steel Concrete tile None used (open hole)

SCREEN OR PERFORATION OPENINGS ARE:
 Continuous Slot Mill Slot Gauze Wrapped Torch Cut Drilled Holes Other (Specify)
 Louvered Shutter Key Punched Wire Wrapped Saw Cut None (Open Hole)


SCREEN-PERFORATED INTERVALS: From 20.17... ft. to 40.17... ft., From ft. to ft., From ft. to ft.
GRAVEL PACK INTERVALS: From 16.5... ft. to 40.17... ft., From ft. to ft., From ft. to ft.

9 GROUT MATERIAL: Neat cement Cement grout Bentonite Other
 Grout Intervals: From 1..... ft. to 16.5..... ft., From ft. to ft., From ft. to ft.

Nearest source of possible contamination:
 Septic Tank Lateral Lines Pit Privy Livestock Pens Insecticide Storage
 Sewer Lines Cess Pool Sewage Lagoon Fuel Storage Abandoned Water Well
 Watertight Sewer Lines Seepage Pit Feedyard Fertilizer Storage Oil Well/Gas Well
 Other (Specify) Former diesel fuel underground storage tank...
 Direction from well? Northwest..... Distance from well? 75..... ft.

10 FROM	TO	LITHOLOGIC LOG	FROM	TO	LITHO. LOG (cont.) or PLUGGING INTERVALS
0	1	Asphalt/Gravel			
1	9	Silty fill			
9	12.75	Silty clay			
12.75	29	Silty fine sand with some clay layers			
29	40.17	Medium grained, well sorted sand			
Notes:					

11 CONTRACTOR'S OR LANDOWNER'S CERTIFICATION: This water well was constructed, reconstructed, or plugged under my jurisdiction and was completed on (mo-day-year) 12-19-19..... and this record is true to the best of my knowledge and belief. Kansas Water Well Contractor's License No. 757..... This Water Well Record was completed on (mo-day-year)..... under the business name of Carson & Assoc..... Signature

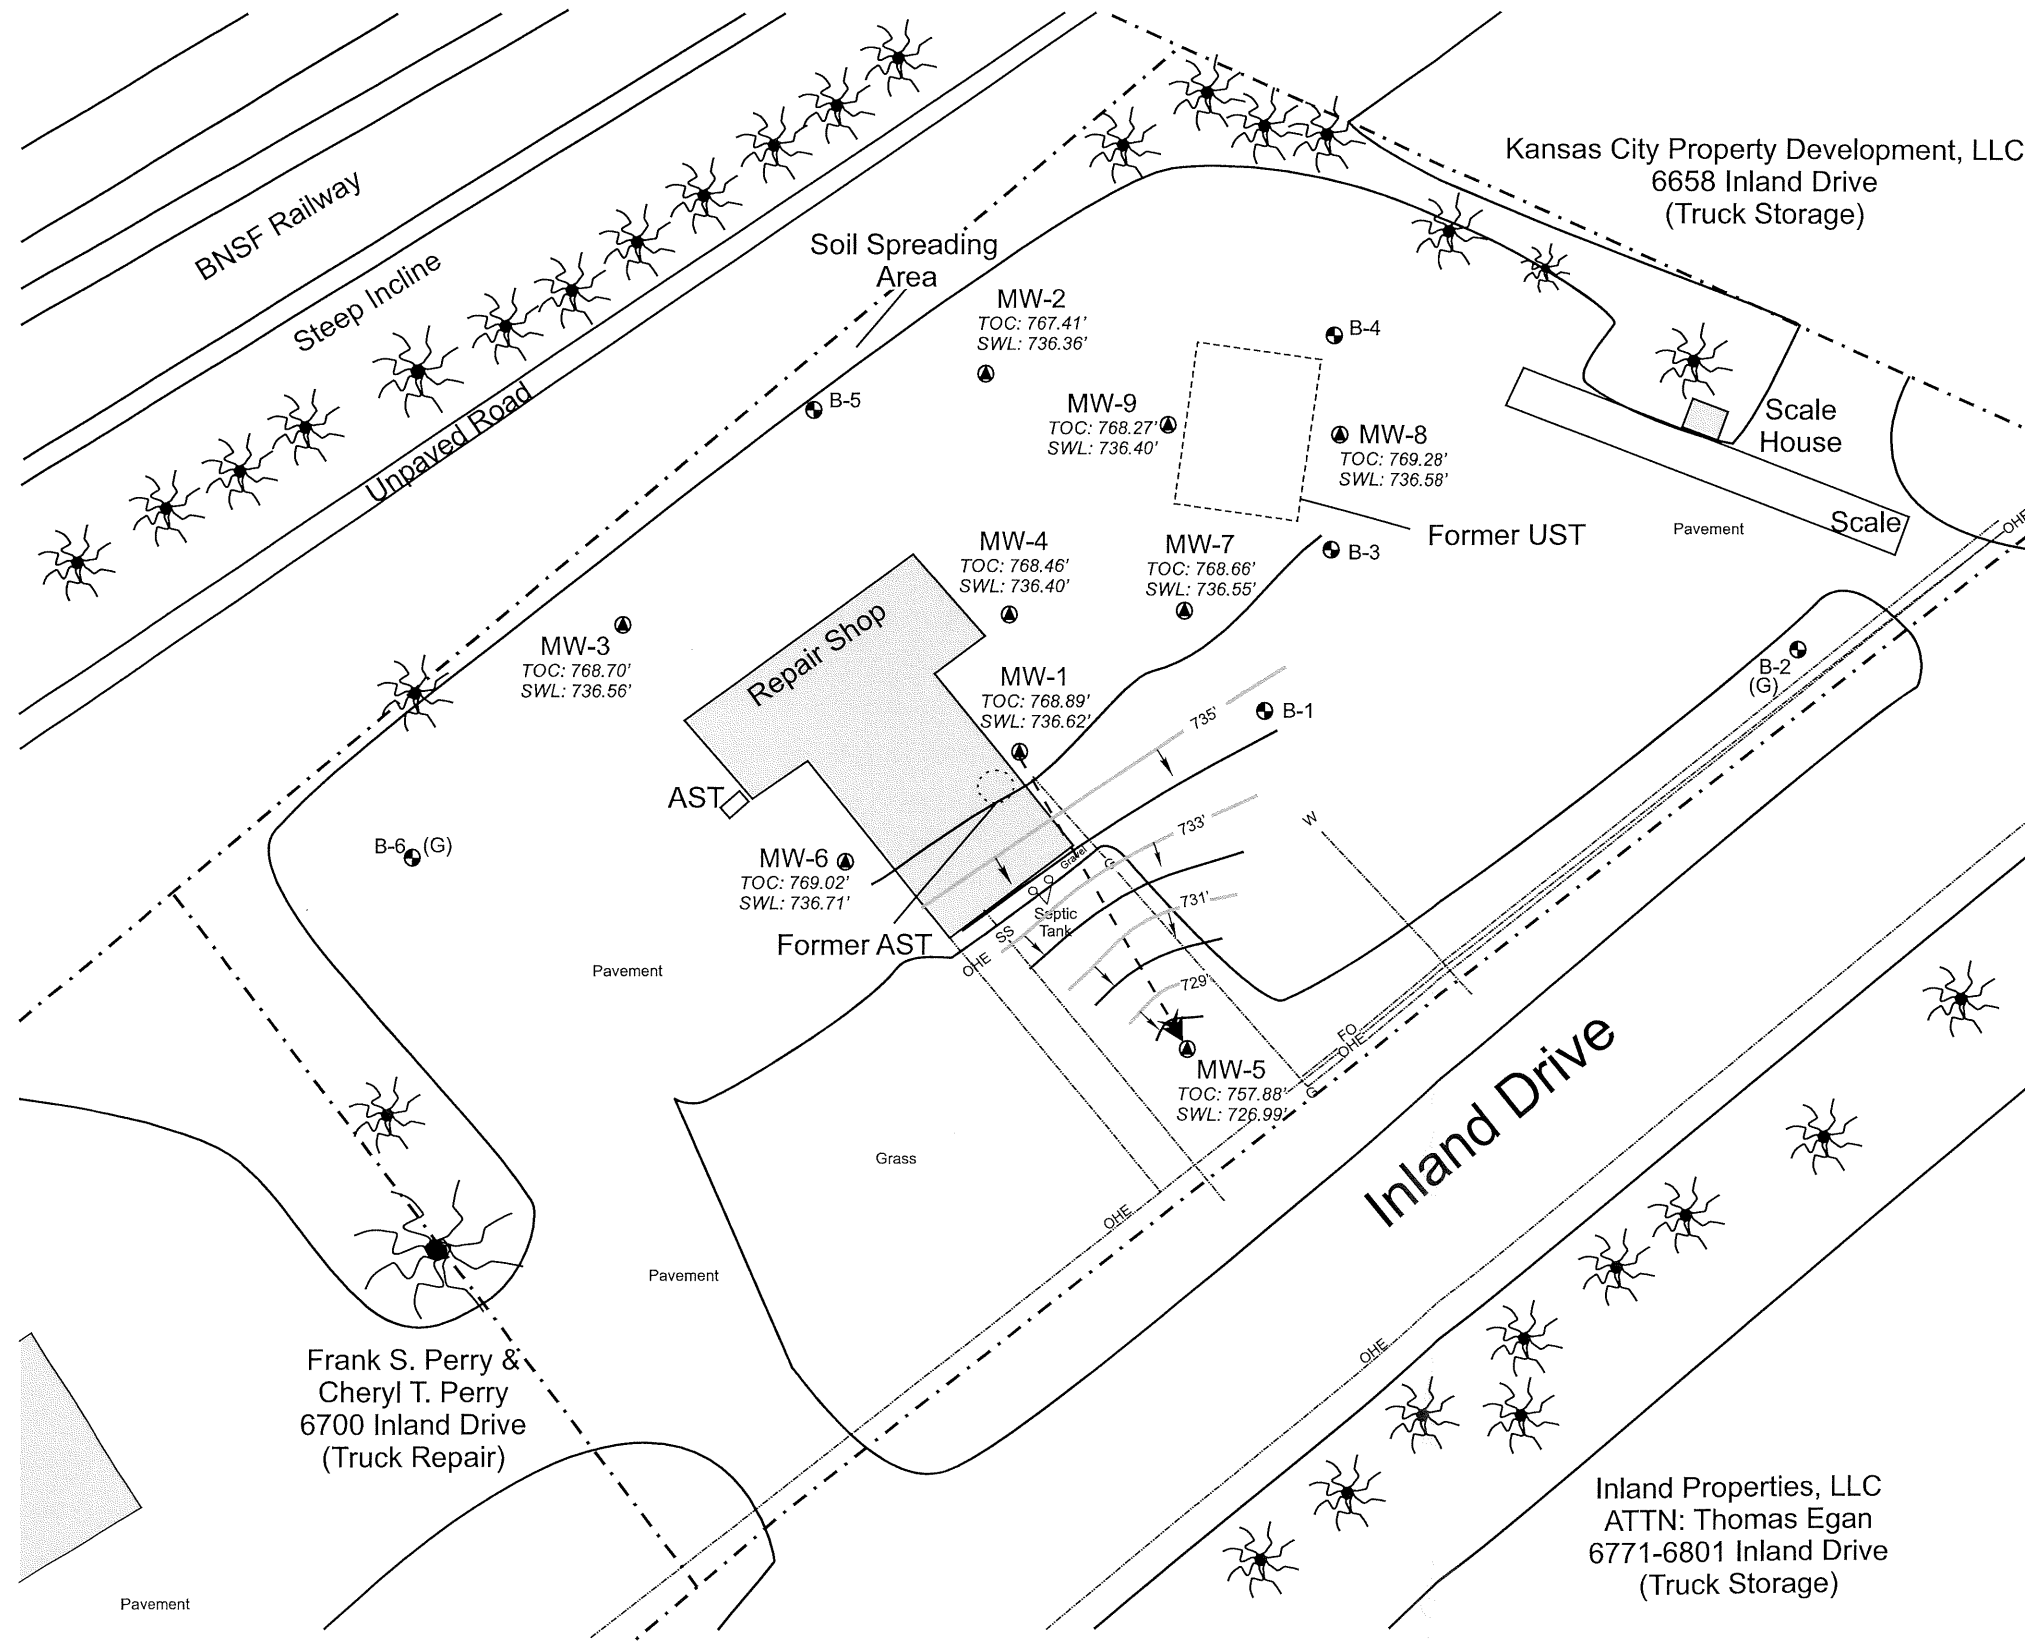

Notes:

- Contour interval - 1.0 foot
 - Contours generated by a linear interpretation of available data.
 - Data used in construction of this map collected January 6, 2020
 - Soil Boring Location (borings denoted with (G) for hydrologic samples)
 - Monitoring Well
 - Product Line Location
 - UST Location
 - 🌳 Tree (approx.)
 - Property Boundary
 - SS Buried Sanitary Sewer Line (3' - 5' depth, approx.)
 - G Buried Gas Line (3' - 5' depth, approx.)
 - OHE Overhead Electric, Cable, & Telephone Line (15' ave height, approx.)
 - FO Buried Fiber Optic Line (3' - 5' depth, approx.)
 - ← Hydraulic gradient flow line
- All wells for site owned by Perry & Perry, LLC

Inferred Groundwater Flow Direction

<p>Knightly Environmental Incorporated Lenexa, Kansas</p>	KEI Job No.: 69-061901-58
	Date: 01/23/20
Figure 3	
<p>Don's Fuel Stop 6666 Inland Drive Kansas City, Kansas KDHE Project A4-105-40492</p>	
<p>Groundwater Flow Map</p>	
<p>Note: Scale Approximate</p>	

Frank S. Perry & Cheryl T. Perry
6700 Inland Drive
(Truck Repair)

Inland Properties, LLC
ATTN: Thomas Egan
6771-6801 Inland Drive
(Truck Storage)