
WATER WELL R	RECORD Form WWC-5	Divis	ion of Water		$\sim 10^{-1}$ MW 7^{-1}	
Original Record			irces App. No.		Well ID	
LOCATION OF W		i i	ion Number	Township Number		
County: Wyandott		SE 1/4	15	T 11 S	R 25 ■ E □ W	
2 WELL OWNER: Last Name: Smith First: Jim Street or Rural Address where well is located (if unknown, distance and direction from nearest town or intersection): If at owner's address, check here:						
Address: 201 Helios Way; 6th Floor 47-51 Kansas Ave; Kansas City, KS						
Address:						
City: Houston State: TX ZIP: 77079						
3 LOCATE WELL WITH "X" IN	4 DEPTH OF COMPLETED WELL:	ft.	5 Latitude	39.00++	(decimal degrees)	
SECTION BOX:	Depth(s) Groundwater Encountered: 1)23		Longitue	de: -94, 6166	(decimal degrees)	
N	2)			ıl Datum: ☐ WGS 84	□ NAD 83 □ NAD 27	
	WELL'S STATIC WATER LEVEL:			Source for Latitude/Longitude: etrck MGPS (unit make/model:		
NW NE	above land surface, measured on (mo-day-			M GPS (unit make/model:) (WAAS enabled? M Yes □ No)		
	Pump test data: Well water was			Land Survey Topographic Map		
WE	after hours pumping	gpm	Online Mapper:			
SW SE	Well water was fi					
	after hours pumping		6 Elevatio	n:ft. [☐ Ground Level ☐ TOC	
S	Bore Hole Diameter:	. ft. and	Source: Land Survey GPS Topographic Map			
mile	in. to	ft.] Other		
7 WELL WATER TO BE USED AS:						
I. Domestic: ☐ Household	5. Public Water Supply: well ID				se	
Lawn & Garden				11. Test Hole: well ID		
Livestock				12. Geothermal: how many bores?		
2. 🔲 Irrigation	rrigation 9. Environmental Remediation: well ID			a) Closed Loop		
3. ☐ Feedlot ☐ Air Sparge ☐ Soil Vapor Extraction 4. ☐ Industrial ☐ Recovery ☐ Injection			b) Open Loop Surface Discharge Inj. of Water			
Was a chemical/bacteriological sample submitted to KDHE? ☐ Yes ■ No If yes, date sample was submitted:						
8 TYPE OF CASING USED: Steel PVC Other						
Casing diameter						
Casing height above land surface						
TYPE OF SCREEN OR PERFORATION MATERIAL:						
	nless Steel Fiberglass PVC			(Specify)		
☐ Brass ☐ Galvanized Steel ☐ Concrete tile ☐ None used (open hole) SCREEN OR PERFORATION OPENINGS ARE:						
☐ Continuous Slot ☐ Mill Slot ☐ Gauze Wrapped ☐ Torch Cut ☐ Drilled Holes ☐ Other (Specify)						
☐ Louvered Shutter ☐ Key Punched ☐ Wire Wrapped ☐ Saw Cut ☐ None (Open Hole)						
SCREEN-PERFORATED INTERVALS: From						
GRAVEL FACK INTERVALS. From						
9 GROUT MATERIAL: Neat cement Cement grout Bentonite Other						
Nearest source of possible contamination:						
Septic Tank						
☐ Sewer Lines ☐ Cess Pool ☐ Sewage Lagoon ☐ Fuel Storage ☐ Abandoned Water Well						
□ Watertight Sewer Lines □ Seepage Pit □ Feedyard □ Fertilizer Storage □ Oil Well/Gas Well						
Direction from well? Un Known Distance from well? Un Known ft.						
10 FROM TO	LITHOLOGIC LOG	FROM			LUGGING INTERVALS	
0 0,5	Concrete				2000111011120	
0.5 18	Silty clay - Brown					
18 35	Sand, fine to coare gain gray					
		1		//		
Notes:						
11 CONTRACTOR'S OR LANDOWNER'S CERTIFICATION: This water well was a constructed or reconstructed or plugged						
11 CONTRACTOR'S OR LANDOWNER'S CERTIFICATION. This water well was constructed, reconstructed, or plugged under my jurisdiction and was completed on (mo-day-year)						
Kansas Water Well Contractor's License No. /.10 This Water Well Record was completed or (mo day-year) 09/01/2018						
under the business name of Below Ground Surface, Inc. Signature Aug. K. Human Mail I white copy along with a fee of \$5.00 for each constructed well to: Kansas Department of Health and Environment, Burdau of Water, GWTS Section,						
1000 SW Jackson St., Suite 420, Topeka, Kansas 66612-1367. Mail one to Water Well Owner and retain one for your records. Telephone 785-296-5524.						
Visit us at http://www.kdhcks.gov/waterwell/index.html KSA 82a-1212 Revised 7/10/2015						

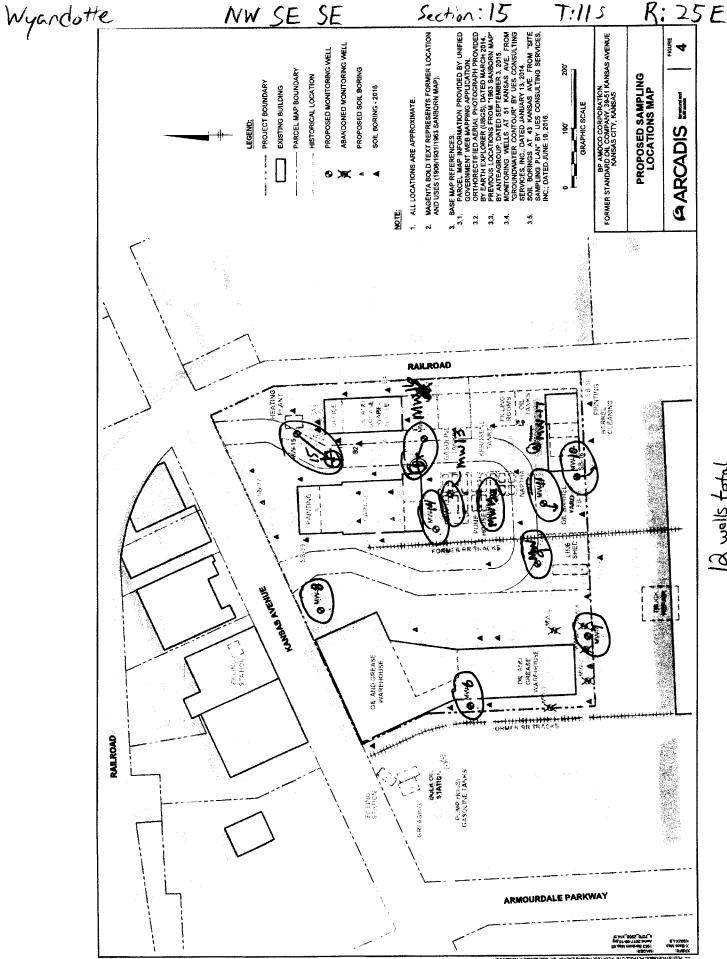

ld wells total