
WATER WELL RECORD Form WWC-5	Division of Water Wall ID
Original Record Correction Change in Well Use	Resources App. No. Well ID
1' LOCATION OF WATER WELL: Fraction County: Wyandotte Fraction % NW % SE %	Section Number Township Number Range Number Range Number R 25 ■ E □ W
County: 7	treet or Rural Address where well is located (if unknown, distance and
	rection from nearest town or intersection): If at owner's address, check here:
Address: 201 Helios Way; 6th Floor	7-51 Kansas Ave; Kansas City, KS
Address:	5 · Nandas / Na, Nandas 5 · N,
	26 20 00205
WITH "X" IN 4 DEPTH OF COMPLETED WELL:	35 ft. 5 Latitude: 39.08805 (decimal degrees) Longitude: -94.6162 + (decimal degrees)
SECTION BOX: Depth(s) Groundwater Encountered: 1) 22	ft. Longitude: 77. (decimal degrees)
2) ft. 3) ft., or 4) \(\bigcup \) WELL'S STATIC WATER LEVEL:	
below land surface, measured on (mo-day-y	
above land surface, measured on (mo-day-y	(WAAS enabled? Yes No)
Pump test data: Well water was	☐ Land Survey ☐ Topographic Map
W E after hours pumping	Online Mapper:
Well water was	nm .
1 1 1 1 1 1 1 1 1 1 1 1 1 1 1 1 1 1 1	1.6 Playation: # Censued Laval 1777
Bore Hole Diameter:	
mile in. to	ft. Other
7 WELL WATER TO BE USED AS: 1. Domestic: 5. □ Public Water Supply: well ID	10 DOLField Water Street Land
1. Domestic: 5. □ Public Water Supply: well ID 6. □ Dewatering: how many wells?	
□ Lawn & Garden 7. □ Aquifer Recharge: well ID	Cased Uncased Geotechnical
2. Irrigation 9. Environmental Remediation: well ID	
3. ☐ Feedlot ☐ Air Sparge ☐ Soil Vapor Ex	traction b) Open Loop Surface Discharge Inj. of Water 13. Other (specify):
Was a chemical/bacteriological sample submitted to KDHE? ☐ Yes ■ No If yes, date sample was submitted:	
8 TYPE OF CASING USED: Steel PVC Other CASING JOINTS: Glued Clamped Welded Threaded	
Casing diameter 2 in to 5, Diameter in to ft. Diameter in to ft.	
Casing diameterin. toft., Diameterin. toin. to	
TYPE OF SCREEN OR PERFORATION MATERIAL:	
☐ Steel ☐ Fiberglass ☐ PVC ☐ Other (Specify) ☐ Brass ☐ Galvanized Steel ☐ Concrete tile ☐ None used (open hole)	
SCREEN OR PERFORATION OPENINGS ARE:	
☐ Continuous Slot ☐ Mill Slot ☐ Gauze Wrapped ☐ Torch Cut ☐ Drilled Holes ☐ Other (Specify)	
Louvered Shutter	
SCREEN-PERFORATED INTERVALS: From	
GRAVEL PACK INTERVALS: From	
9 GROUT MATERIAL: Neat cement Cement grout Bentonite Other.	
Grout Intervals: From	
☐ Septic Tank ☐ Lateral Lines ☐ Pit Privy	☐ Livestock Pens ☐ Insecticide Storage
Sewer Lines Cess Pool Sewage Lage	on
☐ Watertight Sewer Lines ☐ Seepage Pit ☐ Feedyard ☐ Other (Specify) UNKNOWN	☐ Fertilizer Storage ☐ Oil Well/Gas Well
Direction from well?	·· Un Known
10 FROM TO LITHOLOGIC LOG	FROM TO LITHO. LOG (cont.) or PLUGGING INTERVALS
0 0.5 Concrete	
O.C 19 Siller clay board	
18 35 Sand, fine to Conste grain, gray	
	Notaci
	Notes:
11 CONTRACTOR'S OR LANDOWNER'S CERTIFICATION:	This water well was constructed, reconstructed, or plugged
under my jurisdiction and was completed on (mo-day-year) 21.2.	2918 and this record is true to the best of my knowledge and belief.
Kansas Water Well Contractor's License No. 110 This Wat	er Well Record was completed on mo day-year) 09/01/2018
under the business name of Below Ground Surface, Inc. Mail I white copy along with a fee of \$5.00 for each constructed well to: Kansas Department of Health and Environment, Buleau of Water, GWTS Section,	
1000 SW Jackson St., Suite 420, Topeka, Kansas 66612-1367. Mail one to W	
	SA 82a-1212 Revised 7/10/2015

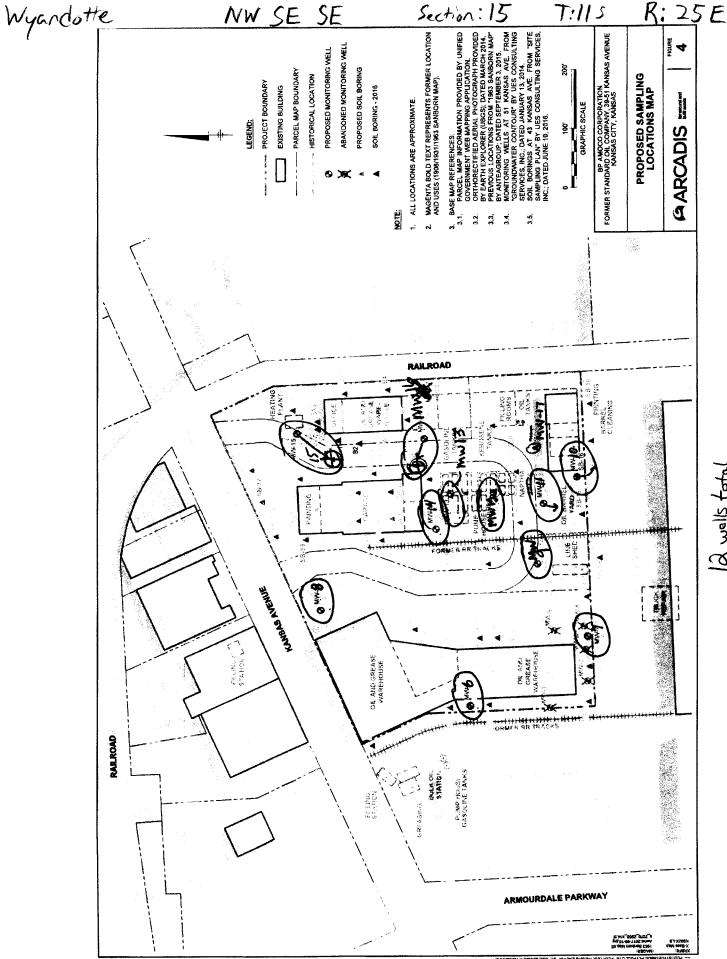

ld wells total