
WATER WELL R			sion of Water	MW 12	
Original Record			irces App. No.	Well ID	
1 LOCATION OF W		1	ion Number	Township Number Range Number	
County: Wyandotte ¼ NW ¼ SE ¼ SE ¼ 15 T 11 S R 25 ■ E □ W					
2 WELL OWNER: Last Name: Smith First: Jim Street or Rural Address where well is located (if unknown, distance and					
Business: BP Products North America, Inc. Address: 201 Helios Way; 6th Floor direction from nearest town or intersection): If at owner's address, check here:					
Address: 201 Helios Way; 6th Floor 47-51 Kansas Ave; Kansas City, KS					
City: Houston	State: TX ZIP: 77079				
3 LOCATE WELL	4 DEPTH OF COMPLETED WELL:	35 ft	5 Latitud	e: 39.08813 (decimal degrees)	
WITH "X" IN	Depth(s) Groundwater Encountered: 1) 2'		Longitu	e:	
SECTION BOX:	2) ft. 3) ft., or 4)		Well Horizontal Datum: \(\sqrt{WGS 84 \sqrt{NAD 83 \sqrt{NAD 27 \sqrt{1}}}		
14	WELL'S STATIC WATER LEVEL:		Source for Latitude/Longitude:		
below land surface, measured on (mo-day-yi		y-yr)	Ci o (cinte mane) in circum,		
above land surface, measured on (mo-day-yr)		/-yr)			
	Pump test data: Well water was		☐ Land Survey ☐ Topographic Map		
W	Well water was		☐ Unii	ine Mapper:	
SW SE	after hours pumping				
X				on:ft. Ground Level TOC	
S	Estimated Yield:			☐ Land Survey ☐ GPS ☐ Topographic Map	
mile	in. to	ft.		Other	
7 WELL WATER TO BE USED AS: 1. Domestic: 5. ☐ Public Water Supply: well ID 10 ☐ Oil Field Water Supply: lease					
Household	5. ☐ Public Water Supply: well ID6. ☐ Dewatering: how many wells? .		10. U Oil F	Field Water Supply: leasele: well ID	
Lawn & Garden	7. Aguifer Recharge: well ID			d Uncased Geotechnical	
Livestock	7. ☐ Aquifer Recharge: well ID 8. ■ Monitoring: well ID	1W- 12		mal: how many bores?	
2. 🔲 Irrigation	9. Environmental Remediation: well 1	D	a) Clos	ed Loop	
3. Feedlot	☐ Air Sparge ☐ Soil Vapor	Extraction		n Loop Surface Discharge Inj. of Water	
4. Industrial Recovery Injection 13. Other (specify):					
Was a chemical/bacteriological sample submitted to KDHE? ☐ Yes ■ No If yes, date sample was submitted:					
Water well disinfected? No					
8 TYPE OF CASING USED: ☐ Steel ☐ PVC ☐ Other					
Casing diameter in. to ft., Diameter in. to ft. Casing height above land surface ft. Weight lbs/ft. Wall thickness or gauge No. 40.					
TYPE OF SCREEN OR PERFORATION MATERIAL:					
☐ Steel ☐ Stainless Steel ☐ Fiberglass ☐ PVC ☐ Other (Specify)					
☐ Brass ☐ Galvanized Steel ☐ Concrete tile ☐ None used (open hole)					
I .	ATION OPENINGS ARE:				
☐ Continuous Slot ☐ Mill Slot ☐ Gauze Wrapped ☐ Torch Cut ☐ Drilled Holes ☐ Other (Specify)					
□ Louvered Shutter □ Key Punched □ Wire Wrapped □ Saw Cut □ None (Open Hole)					
SCREEN-PERFORATED INTERVALS: From 20 ft. to 35 ft., From ft. to ft., From ft. to ft. GRAVEL PACK INTERVALS: From 18 ft. to 35 ft., From ft. to ft.					
9 GROUT MATERIAL: Neat cement Cement grout Bentonite Other.					
Grout Intervals: From					
Nearest source of possible contamination:					
☐ Septic Tank ☐ Lateral Lines ☐ Pit Privy ☐ Livestock Pens ☐ Insecticide Storage					
☐ Sewer Lines ☐ Cess Pool ☐ Sewage Lagoon ☐ Fuel Storage ☐ Abandoned Water Well					
☐ Watertight Sewer Lir	nes Seepage Pit Feedyard		Fertilizer Stora	ge 🔲 Oil Well/Gas Well	
Direction from well?	un Known Distance from	vell? unk	Now	fr	
10 FROM TO	LITHOLOGIC LOG	FROM		ITHO. LOG (cont.) or PLUGGING INTERVALS	
0 0.5	Concrete				
0.5 18	Stilly clay brown				
18 35	Sand , fine to coarse grain , gray				
		Notes:			
Tives.					
11 CONTRACTOR'S OR LANDOWNER'S CERTIFICATION: This water well was constructed, reconstructed, or plugged under my jurisdiction and was completed on (mo-day-year) 131.18 and this record is true to the best of my knowledge and belief. Kansas Water Well Contractor's License No. 7.10 This Water Well Record was completed on mo day-year) 09/01/2018					
Kansas Water Well Cor	ntractor's License No 710 This	ater Well Rec	and was come	eted op (moreday-year) 09/01/2018	
under the business name of Below Ground Surface, Inc. Signature Mail I white copy along with a fee of \$5.00 for each constructed well to: Kansas Department of Health and Environment, Bureau of Water, GWTS Section,					
l .	t., Suite 420, Topeka, Kansas 66612-1367. Mail one to				
Visit us at http://www.kdheks.gov/waterwell/index.html KSA 82a-1212				Revised 7/10/2015	

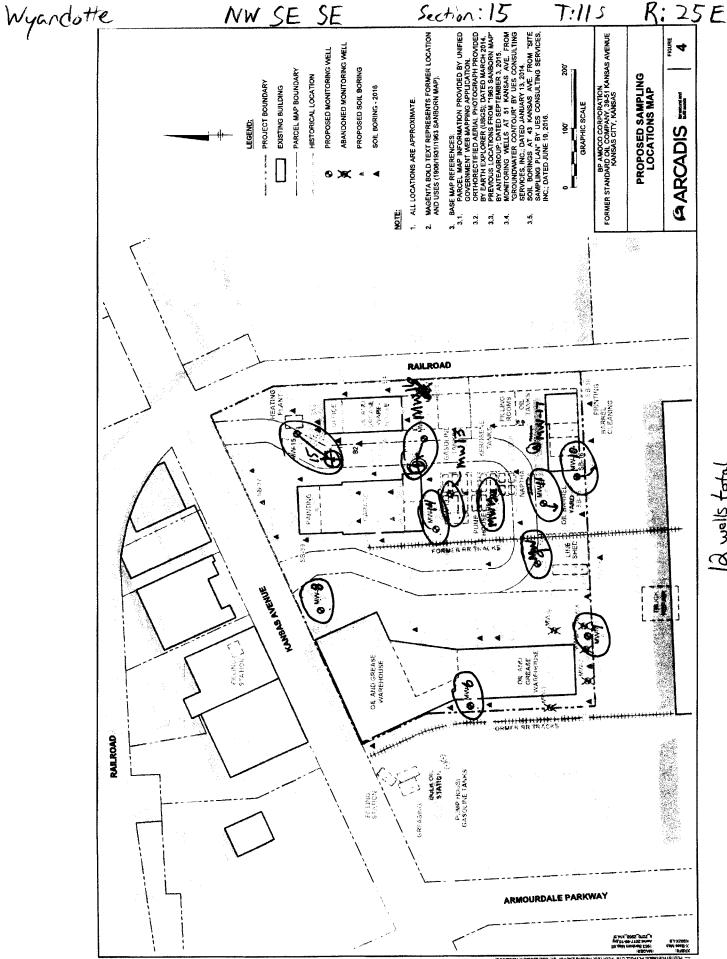

ld wells total