
		RECORD	Form W				ision of Wate	1	MW 15		
			☐ Change				ources App. N		- Well ID		
LOCATION OF WATER WELL: Fraction County: Wyandotte Fraction 1/4 NW 1/4 SE						1 -	tion Numbe	tion Number Township Number Range Number 15 T 11 S R 25 E D W			
			th	First: Jim							
		: Last Name: Smi ducts North Am		First: Jii ii		ral Address where well is located (if unknown, distance and nearest town or intersection): If at owner's address, check here:					
Address: 201 Helios Way; 6th Floor 47-51 K							sas Ave; Kansas City, KS				
Address:								nodo Oky, No			
City: Houston State: TX ZIP: 77079 3 LOCATE WELL 4 DEPTH OF COMPLETED WELL: 35 ft. 5 Latitude: 39.08894 (decimal of											
WITH "X"		4 DEPTH	OF COME	LETED WEL	LL: .	35 ft. 5 Latitude: 39.08894 (decimal degrees)					
	Depth(s) Groundwater Encountered: 1) 2.3 ft.						Longi	Longitude 17. 61999 (decimal degrees)			
N	2) ft. 3) ft., or 4) Dry V WELL'S STATIC WATER LEVEL:						Horizontal Datum: WGS 84 NAD 83 NAD 27 Source for Latitude/Longitude: e+rek GPS (unit make/model: +rek				
			below land surface, measured on (mo-day-yr)				Source	e for Latitude/Longit PS (unit make/mode	ade: etrek		
NW	NE		above land surface, measured on (mo-day-yi						? X Yes No)		
			Pump test data: Well water was ft.					☐ Land Survey ☐ Topographic Map			
w		E after ∵	after hours pumping					nline Mapper:			
SW		after -	after hours pumping								
	\X	l l	1 1 5				6 Elevation:ft. Ground Level TOC				
S		Bore Hole I	Bore Hole Diameter: 8.5 in. to			ft. and	Source:				
1 mile				in. to		ft.		U Other			
7 WELL WATER TO BE USED AS:											
Domestic: □ Househol	ld		 Public Water Supply: well ID Dewatering: how many wells? 								
Lawn & G											
Livestock								12. Geothermal: how many bores?			
2. Irrigation							a) Cl	a) Closed Loop Horizontal Vertical			
3. ☐ Feedlot ☐ Air Sparge ☐ Soil 4. ☐ Industrial ☐ Recovery ☐ Inje						extraction	traction b) Open Loop Surface Discharge Inj. of Water 13. Other (specify):				
Was a chemical/bacteriological sample submitted to KDHE? Yes No If yes, date sample was submitted:											
Water well disinfected? Yes No											
8 TYPE OF CASING USED: Steel PVC Other CASING JOINTS: Glued Clamped Welded Threaded											
Casing diameter											
Casing height above land surface											
TYPE OF SCREEN OR PERFORATION MATERIAL:											
☐ Steel ☐ Stainless Steel ☐ Fiberglass ☐ PVC ☐ Other (Specify)											
SCREEN OR PERFORATION OPENINGS ARE:											
☐ Continuous Slot ☐ Mill Slot ☐ Gauze Wrapped ☐ Torch Cut ☐ Drilled Holes ☐ Other (Specify)											
□ Louvered Shutter □ Key Punched □ Wire Wrapped □ Saw Cut □ None (Open Hole)											
SCREEN-PERFORATED INTERVALS: From 2.0 ft. to 35 ft., From ft. to ft., From ft. to ft.											
GRAVEL PACK INTERVALS: From											
9 GROUT MATERIAL: Neat cement Cement grout Bentonite Other											
Nearest source of possible contamination:											
☐ Septic Tank ☐ Lateral Lines ☐ Pit Privy ☐ Livestock Pens ☐ Insecticide Storage											
Sewer Lin			Cess Pool	☐ Sewag			Fuel Storage		andoned Water Well		
☐ Watertight Sewer Lines ☐ Seepage Pit ☐ Feedyard ☐ Fertilizer Storage ☐ Oil Well/Gas Well ☐ Other (Specify)											
Direction from well?											
10 FROM	TO		ITHOLOG			FROM	TO		t.) or PLUGGING INTERVALS		
	9.5	Concrete									
	18	Silty Cla	, brow	1							
18	35	Sand, Fine	to Coarse	grain, gray							
						Notes:					
	11003										
11 CONTRACTOR'S OR LANDOWNER'S CERTIFICATION: This water well was constructed, reconstructed, or plugged under my jurisdiction and was completed on (mo-day-year) 13 and this record is true to the best of my knowledge and belief.											
under my juri	isdictio	n and was comp	leted on (mo	o-day-year)	113	./.\.8 and	this record	is true to the best of	of my knowledge and belief.		
Linder the bus	Kansas Water Well Contractor's License No. 7.10 This Waler Well Record was completed on more day-year) 09/01/2018 under the business name of Below Ground Surface, Inc										
Mail I v	white cop	y along with a fee of	\$5.00 for each	constructed well to	o: Kar	ışas Departmer	t of Health and	Environment, Bareau	of Water, GWTS Section,		
1000 SW Jackson St., Suite 420, Topeka, Kansas 66612-1367. Mail one to Water Well Owner and retain one for your records. Telephone 785-296-5524.											
Visit us at http://www.kdheks.gov/waterwell/index.html KSA 82a-1212 Revised 7/10/2015											

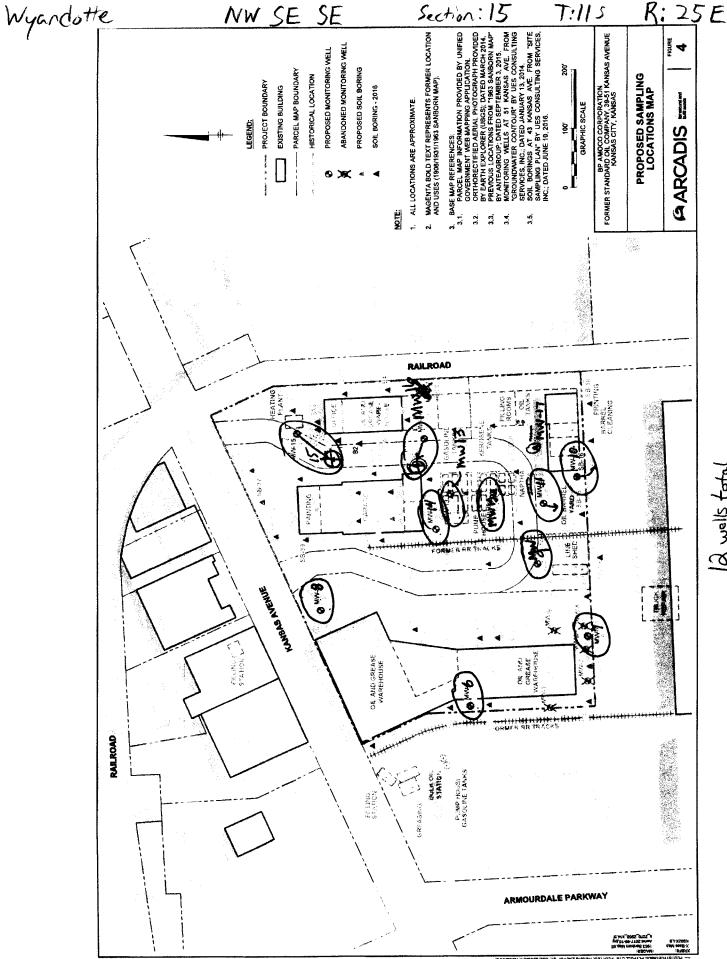

ld wells total