
WATER WELL RECORD Form WWC-5 Original Record Correction Change in Well Use I LOCATION OF WATER WELL: Fraction County: Wyandotte Subject of Rural Address where well is located (if unknown, distant direction from nearest town or intersection): If at owner's address, check address: Original Record Correction Change in Well Use Resources App. No. Well ID I LOCATION OF WATER WELL: Fraction County: Wyandotte Subject of Rural Address where well is located (if unknown, distant direction from nearest town or intersection): If at owner's address, check address: Original Record Correction Change in Well Use Resources App. No. Section Number Township Number Range No. Street or Rural Address where well is located (if unknown, distant direction from nearest town or intersection): If at owner's address, check address: Original Record Correction Change in Well Use Resources App. No. Section Number Township Number Range No. I Street or Rural Address where well is located (if unknown, distant direction from nearest town or intersection): If at owner's address, check address: Original Record Correction Change in Well Use Resources App. No. Section Number Township Number Range No. I Street or Rural Address where well is located (if unknown, distant direction from nearest town or intersection): If at owner's address, check address: Original Record Change In Well Use A DEPTH OF COMPLETED WELL: Original Record Change In Well Use Section Number Township Number Range No. I Section Number Range No	umber E 🔲 W
County: Wyandotte Value V	E U W
2 WELL OWNER: Last Name: Smith First: Jim Business: BP Products North America, Inc. Address: 201 Helios Way; 6th Floor Address: City: Houston State: TX ZIP: 77079 3 LOCATE WELL WITH "X" IN SECTION BOX: Depth(s) Groundwater Encountered: 1) Street or Rural Address where well is located (if unknown, distant direction from nearest town or intersection): If at owner's address, check 47-51 Kansas Ave; Kansas City, KS 5 Latitude: 39.08850 (decim Longitude: 94.61547 (decim Longitu	nce and
Business: BP Products North America, Inc. Address: 201 Helios Way; 6th Floor Address: City: Houston State: TX ZIP: 77079 3 LOCATE WELL WITH "X" IN SECTION BOX. Depth(s) Groundwater Encountered: 1)	
Address: 201 Helios Way; 6th Floor Address: City: Houston State: TX ZIP: 77079 3 LOCATE WELL WITH "X" IN SECTION BOX: Depth(s) Groundwater Encountered: 1) 23 ft. Longitude: 94.61547 (decin	nere:
Address: City: Houston State: TX ZIP: 77079 3 LOCATE WELL WITH "X" IN SECTION BOX: Depth(s) Groundwater Encountered: 1) 23 ft. Longitude: 94.61547 (decin	
3 LOCATE WELL WITH "X" IN SECTION BOX: Depth(s) Groundwater Encountered: 1) 23 ft. Latitude: 39.08850 (decin	
SECTION BOX. Depth(s) Groundwater Encountered: 1)	
SECTION BOX. Depth(s) Groundwater Encountered: 1)	nal degrees)
	nal degrees)
N 2) ft. 3) ft., or 4) ☐ Dry Well Horizontal Datum: ☐ WGS 84 ☐ NAD 83 ☐] NAD 27
WELL'S STATIC WATER LEVEL: ft. Source for Latitude/Longitude: etrek	
below land surface, measured on (mo-day-yr). Below land surface, measured on (mo-day-yr). WAAS enabled? Yes No))
Pump test data: Well water was	
w after hours pumping gpm Online Mapper:	
Well water was ft.	
after nours pumping	±L□ TOC
Estimated Yield:	
mile	
7 WELL WATER TO BE USED AS:	
1. Domestic: 5. Public Water Supply: well ID	
Household 6. □ Dewatering: how many wells?	
□ Lawn & Garden 7. □ Aquifer Recharge: well ID □ Cased □ Uncased □ Geotechnical □ Livestock 8. ■ Monitoring: well ID 12. Geothermal: how many bores?	
2. Irrigation 9. Environmental Remediation: well ID	
3. ☐ Feedlot ☐ Air Sparge ☐ Soil Vapor Extraction b) Open Loop ☐ Surface Discharge ☐ Inj. o	
4. Industrial Recovery Injection 13. Other (specify):	
Was a chemical/bacteriological sample submitted to KDHE? ☐ Yes ■ No If yes, date sample was submitted:	
Water well disinfected? ☐ Yes ■ No	
8 TYPE OF CASING USED: Steel PVC Other CASING JOINTS: Glued Clamped Welded	Threaded
Casing diameter 2 in to 5 ft., Diameter in to ft. Diameter in to ft. Casing height above land surface 6 in Weight 1bs/ft. Wall thickness or gauge No. 40	
TYPE OF SCREEN OR PERFORATION MATERIAL:	
☐ Steel ☐ Stainless Steel ☐ Fiberglass ☐ PVC ☐ Other (Specify)	
☐ Brass ☐ Galvanized Steel ☐ Concrete tile ☐ None used (open hole)	
SCREEN OR PERFORATION OPENINGS ARE:	
☐ Continuous Slot ☐ Mill Slot ☐ Gauze Wrapped ☐ Torch Cut ☐ Drilled Holes ☐ Other (Specify)	
SCREEN-PERFORATED INTERVALS: From 40 ft to 75 ft From ft From ft From ft to 75 ft From ft to 75 ft From ft To 75 ft From	- _{ft}
GRAVEL PACK INTERVALS: From	ft.
9 GROUT MATERIAL: Neat cement Cement grout Bentonite Other. Grout Intervals: From	
Grout Intervals: From	
Nearest source of possible contamination: □ Septic Tank □ Lateral Lines □ Pit Privy □ Livestock Pens □ Insecticide Storage	
☐ Septic Tank ☐ Lateral Lines ☐ Pit Privy ☐ Livestock Pens ☐ Insecticide Storage ☐ Sewer Lines ☐ Cess Pool ☐ Sewage Lagoon ☐ Fuel Storage ☐ Abandoned Water Well	
Waterdickt Course Lines DS - Di	
Other (Specify) UN Known	
Direction from well?	
10 FROM TO LITHOLOGIC LOG FROM TO LITHO. LOG (cont.) or PLUGGING INT	ERVALS
015 13 Silty clay brown	
18 35 Sand, fine to coarse grain, gray	
The course grain, gray	
Notes:	
H. CONTRACTOR OF LANDONSYPPIC	
11 CONTRACTOR'S OR LANDOWNER'S CERTIFICATION: This water well was constructed, reconstructed, or under my jurisdiction and was completed on (mo day year)	plugged
under my jurisdiction and was completed on (mo-day-year) 21.7.1.3. and this record is tract to the best of my knowledge an Kansas Water Well Contractor's License No. 7.10	d belief. 8
under my jurisdiction and was completed on (mo-day-year) 21.7.1.3. and this record is tract to the best of my knowledge an Kansas Water Well Contractor's License No. 7.10	d belief. 8
under my jurisdiction and was completed on (mo-day-year) \$112.1.3. and this record is two to the best of my knowledge an	d belief. 8

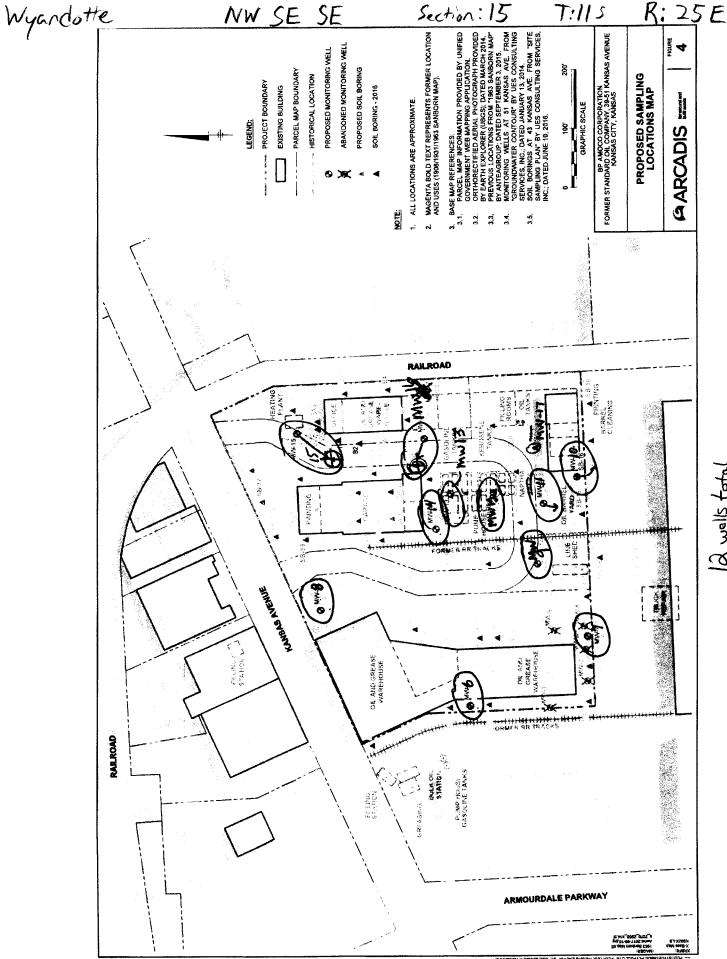

ld wells total