

WATER WELL RECORD

Form WWC-5

Division of Water Resources App. No.

390939

Well ID

MW2

Original Record Correction Change in Well Use

1 LOCATION OF WATER WELL: County Wyandotte Fraction SE 1/4 NE 1/4 SE 1/4 SW 1/4 Section Number 18 Township Number T 11 S Range Number R 25 E

2 WELL OWNER: Last Name: Business: QuikTrip Corporation Address: 4705 S 129th E. Ave. City: Tulsa State: OK ZIP: 74134 Street or Rural Address where well is located (if unknown, distance and direction from nearest town or intersection): 4202 Kansas Ave., Kansas City, KS

3 LOCATE WELL WITH "X" IN SECTION BOX: N NW NE SW SE S W E X

4 DEPTH OF COMPLETED WELL: 45 ft Depth(s) Groundwater Encountered: 1) 45 ft 2) ft 3) ft, or 4) Dry Well WELL'S STATIC WATER LEVEL: 26.9 ft. X below land surface, measured on (mo-day-yr) 7/3/2019

5 Latitude: 39.09039 (decimal degrees) Longitude: 94.67776 (decimal degrees) Horizontal Datum: X WGS 84 GPS (unit make/model): Land Survey

6 Elevation: 762.24 ft TOC Source: X Land Survey

7 WELL WATER TO BE USED AS: 1 Domestic: 2 Irrigation: 3 Feedlot: 4 Industrial: 5 Public Water Supply: well ID: 6 Dewatering: how many wells?: 7 Aquifer Recharge: well ID: 8 Monitoring: well ID MW2: 9 Environmental Remediation: well ID: 10 Oil Field Water Supply: lease: 11 Test Hole: well ID: 12 Geothermal: How many bores?:

Was a chemical/bacteriological sample submitted to KDHE? No If yes, date sample was submitted: Water well disinfected? No

8 TYPE OF CASING USED: PVC CASING JOINTS: Threaded Casing diameter: 2 in. to 25 ft. Diameter: in. to ft. Casing height above land surface: -0.40 in. Weight: lbs./ft. Well thickness or gauge No: TYPE OF SCREEN OR PERFORATION MATERIAL: PVC SCREEN OR PERFORATION OPENINGS ARE: Mill Slot SCREEN-PERFORATED INTERVALS: From 25 ft. to 45 ft. GRAVEL PACK INTERVALS: From 23 ft. to 45 ft.

9 GROUT MATERIAL: Bentonite Other Concrete: 0-0.7' Grout intervals: From 0.7 ft. to 23 ft.

Nearest source of possible contamination: Fuel Storage Direction from well? W Distance from well? ~5 ft

Table with columns: FROM, TO, LITHOLOGIC LOG, FROM, TO, LITHO. LOG (cont.) or PLUGGING INTERVALS. Rows: 0-0.5 Mulch, 0.5-6 Gravel fill w/ coarse sand, 6-28 Silt, 28-34 Medium sand, 34-45 Coarse sand w/ gravel

Notes: KDHE ID: Former Quiktrip #231; U4-105-14927

11 CONTRACTOR'S OR LANDOWNER'S CERTIFICATION: This water well was constructed under my jurisdiction and was completed on (mo-day-yr) 7/2/19 and this record is true to the best of my knowledge and belief. Kansas Water Well Contractor's License No. 757 This Water Well Record was completed on (mo-day-yr) 7/29/19 under the business name of Larsen & Associates, Inc. Signature

Mail 1 white copy along with a fee of \$5.00 for each constructed well to: Kansas Department of Health and Environment, Bureau of Water, GWTS Section, 1000 SW Jackson St., Suite 420, Topeka, Kansas 66612-1367. Mail one to Water Well Owner and retain one for your records. Telephone 785-296-5524.

DENNIS L HANDKE

1820 NW 59th Terrace
TOPEKA, KANSAS 66618
785-286-4047 Home
785-286-1990 Fax

Jess Chapman
Larsen & Associates
1311 E. 25th Street, Suite B
Lawrence, Kansas 66046

July 18, 2019

RE: Monitor Well Elevation Survey
4202 Kansas Ave., Kansas City, Kansas

Proj. 19-00X
Former Quik Trip #231
KDHE ID ~~U4-150-14927~~

U4-105-14927

Bench Mark: Chisled Sq. on NE corner of concrete QT sign base near the SE Corner of property.

Elev: 762.09 North 726.46 West 2736.63 (from SE Cor. Sec. 18-11-25E)

MW-1	rim	763.55	North	715.57	SE1/4,NE1/4,SE1/4,SW1/4
	top pipe	763.26	West	2882.13	Lat = 39.08981 Long = 94.67800
MW-2	rim	762.64	North	925.69	SE1/4,NE1/4,SE1/4,SW1/4
	top pipe	762.24	West	2813.01	Lat = 39.09039 Long = 94.67776
MW-3	rim	761.18	North	719.45	SW1/4,NE1/4,SE1/4,SW1/4
	top pipe	760.26	West	3154.10	Lat = 39.08982 Long = 94.67896
MW-4	rim	763.89	North	986.57	SW1/4,NE1/4,SE1/4,SW1/4
	top pipe	763.59	West	2980.44	Lat = 39.09036 Long = 94.67836
MW-5	rim	761.78	North	783.48	SE1/4,NE1/4,SE1/4,SW1/4
	top pipe	761.51	West	2750.13	Lat = 39.09000 Long = 94.67754
MW-6	rim	761.00	North	1016.86	NE1/4,NE1/4,SE1/4,SW1/4
	top pipe	760.66	West	2724.29	Lat = 39.09064 Long = 94.67745


Elevation derived from KDOT BM 304-B project K-4890-01 NAVD88.

Lat & Long derived from Shawnee 7.5 Quad Map WGS84.


If you have any questions, please feel free to call me. Thank you for the opportunity to be of service to you.

July 18, 2019

Dennis L Handke RS

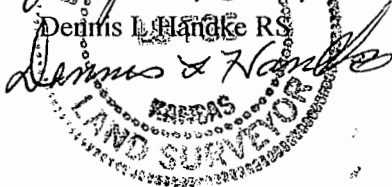

NOTE: Figures exhibited within this report are only to be used within the context of this report. Placement of property lines, wells, structures, and roads is based on the available information from county appraiser maps, surveys, site visits, and/or previous vendor reports and should be considered approximate.

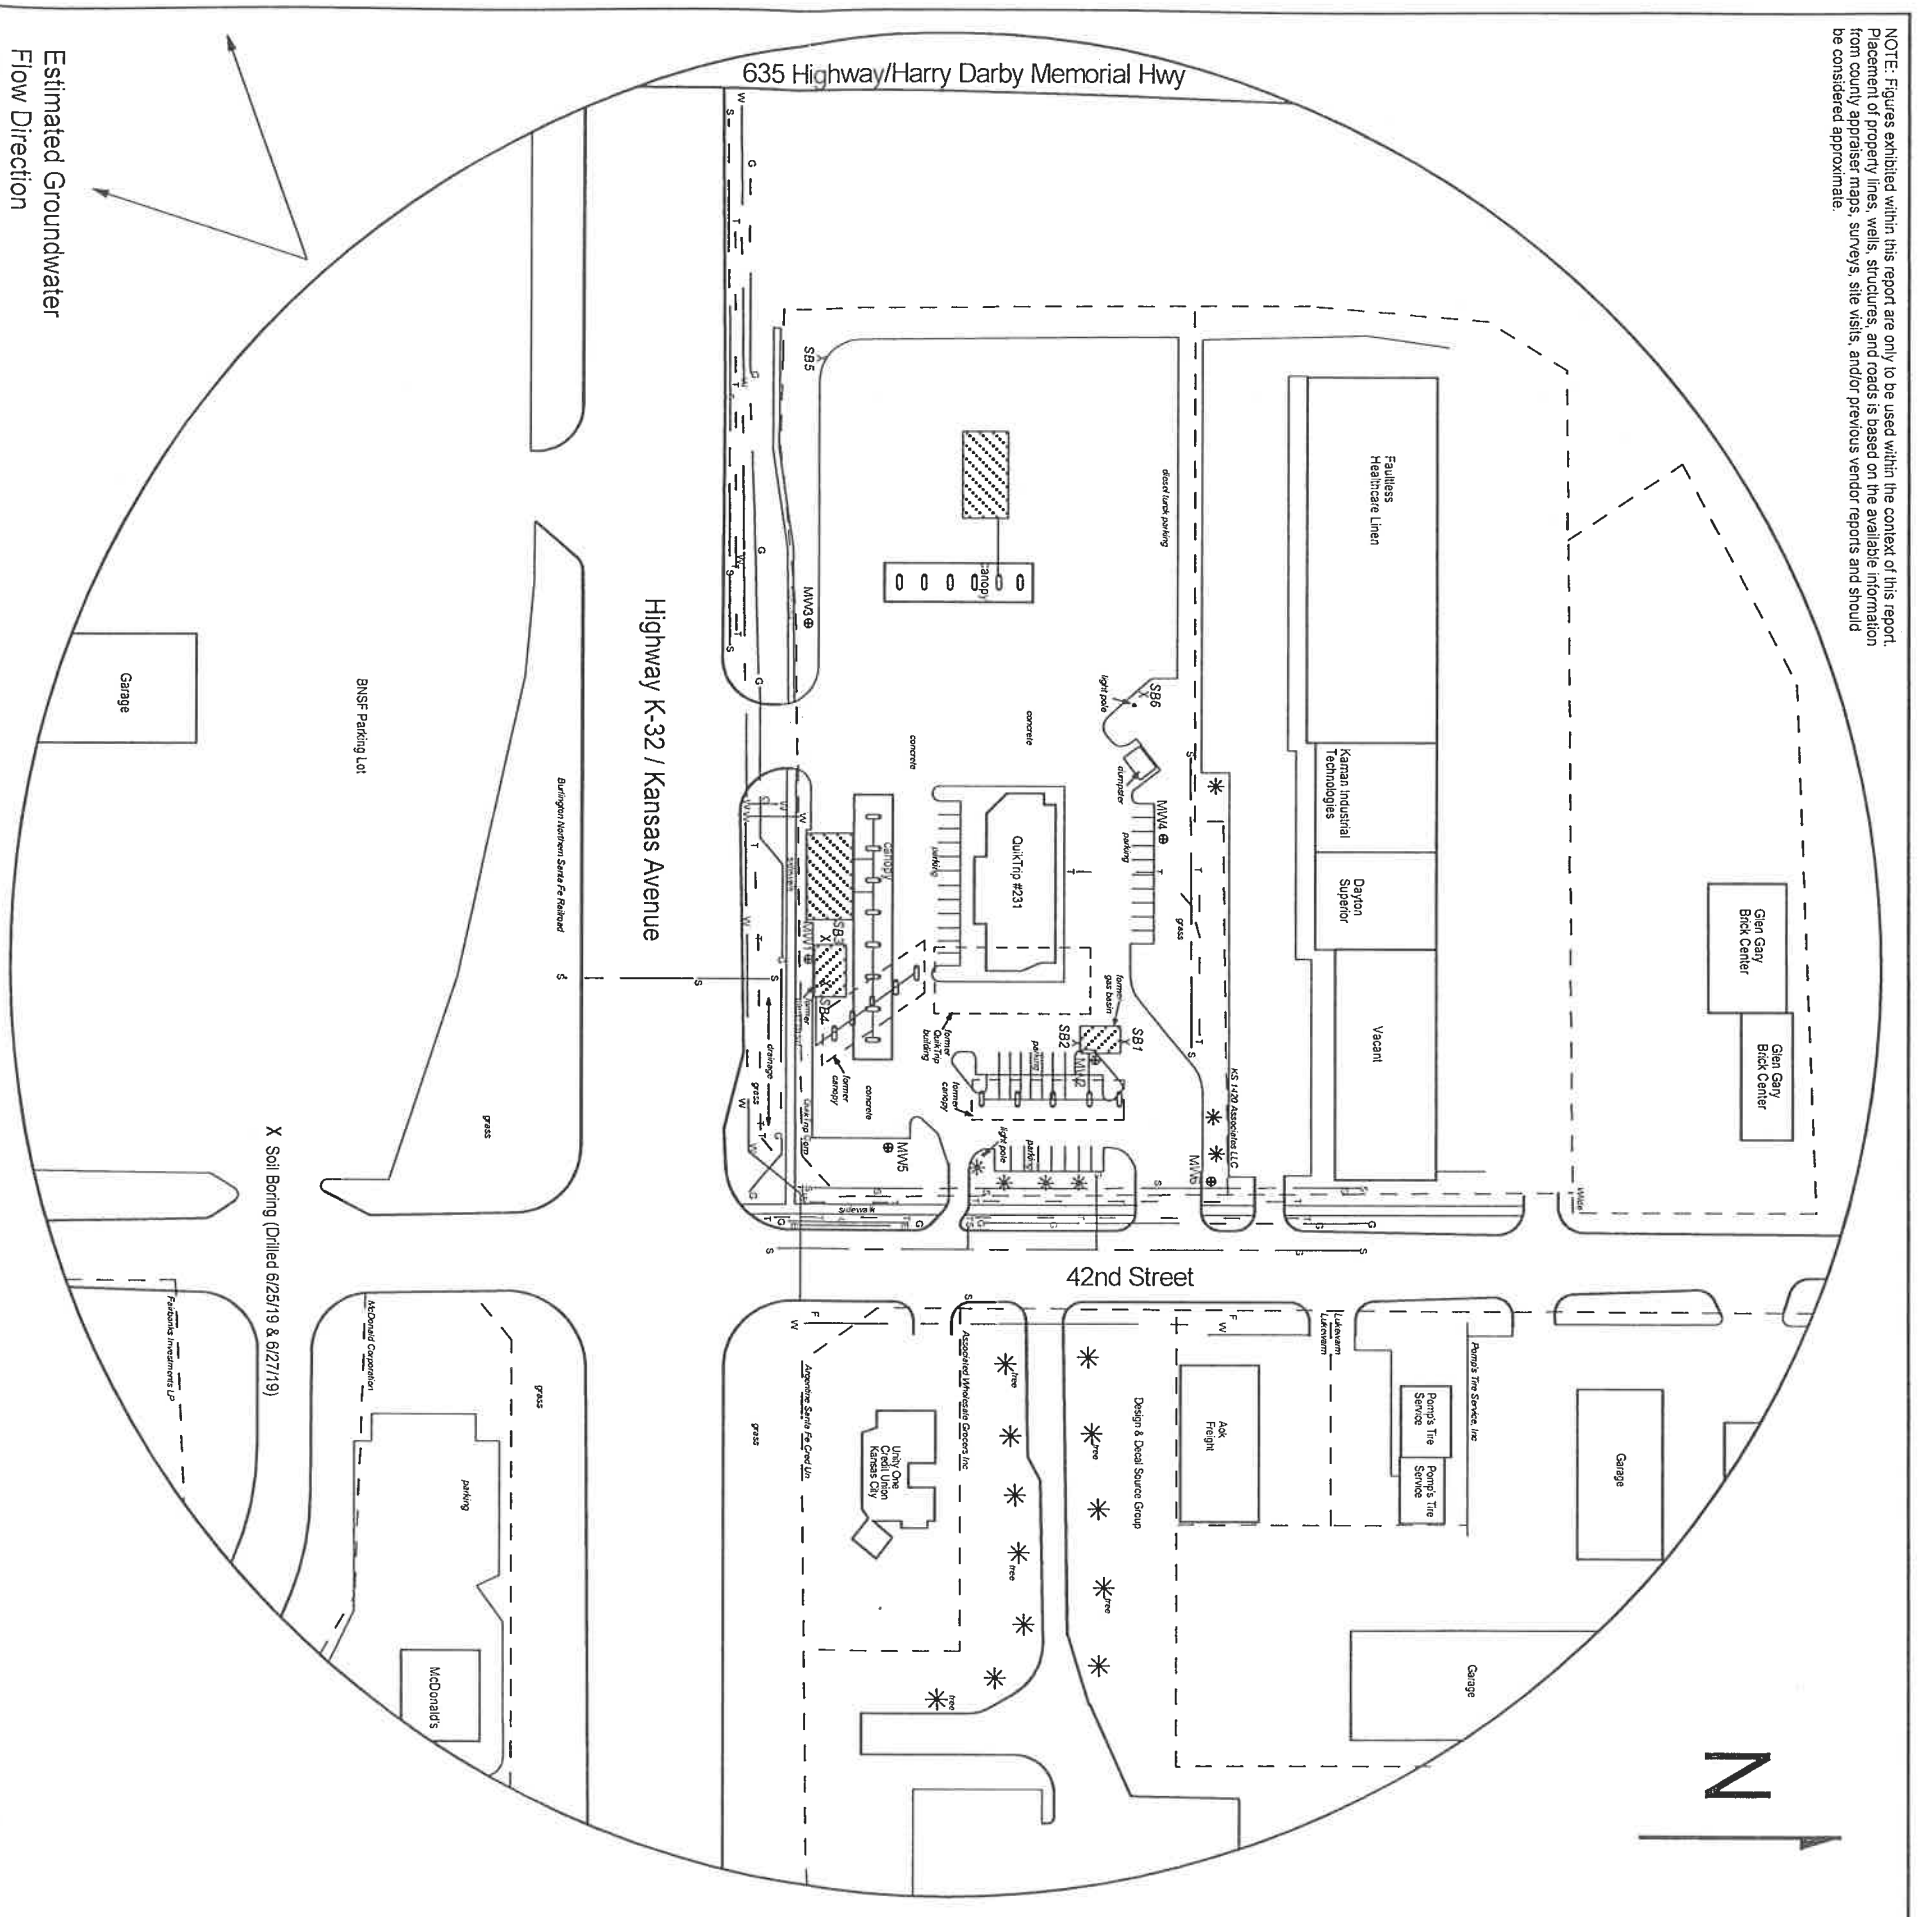


Estimated Groundwater
Flow Direction

FIGURE 2.2 - 700 FT RADIUS AREA BASE MAP


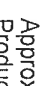

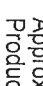

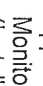

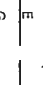
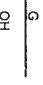
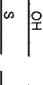

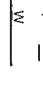
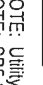

larsen
 & ASSOCIATES, INC.

1311 E 25th St., Suite B 785-841-8707 office
 Lawrence, KS 66046 785-865-4282 fax

PROJECT:
 Former QuikTrip #231
 4202 Kansas Avenue
 Kansas City, KS
 KDHEID: U4-105-14927
 Date: 7/3/19


 0 140 ft

LEGEND

-  Approximate Location of Active UST Basin,
-  Product Lines & Pump Islands
-  Approximate Location of Former UST Basin, Product Lines & Pump Islands
-  Approximate Location of Property Line
-  Monitoring Well (Installed 6/25, 27, 28/19 & 7/2/19)
-  X Soil Boring (Drilled 6/25/19 & 6/27/19)
-  F Fire Hydrant
-  E Electric Lines (1.5 - 3 ft bgs)
-  G Gas Lines (1.5 - 3 ft bgs)
-  OH Overhead Lines (25'-40' high)
-  S Sewer Lines (2 - 6 ft bgs)
-  T Telephone Lines (2 - 6 ft bgs)
-  W Water Lines (2 - 6 ft bgs)

NOTE: Utility depths, heights and locations are approximate.
 NOTE: SB5 & SB6 were drilled to collect hydrologic samples.