

WATER WELL RECORD

Form WWC-5

Division of Water Resources App. No.

Well ID

MW1

Original Record Correction Change in Well Ust

1 LOCATION OF WATER WELL: County Wyandotte Fraction SE 1/4 NE 1/4 SE 1/4 NE 1/4 Section Number 34 Township Number T 11 S Range Number R 25 E W
2 WELL OWNER: Last Name: First: Street or Rural Address where well is located (if unknown, distance and direction from nearest town or intersection): If at owner's address, check here:
3 LOCATE WELL WITH "X" IN SECTION BOX:
4 DEPTH OF COMPLETED WELL: 17 ft
5 Latitude: 39.05308 (decimal degrees) Longitude: 94.61209 (decimal degrees)

7 WELL WATER TO BE USED AS:
1 Domestic: Household Lawn & Garden Livestock Irrigation Feedlot Industrial
2 Public Water Supply: well ID
3 Dewatering: how many wells?
4 Aquifer Recharge: well ID
5 Monitoring: well ID MW1
6 Environmental Remediation: well ID
7 Air Sparge Soil Vapor Extractor Recovery Injection
8 Oil Field Water Supply: lease
9 Test Hole: well ID Cased Uncased Geotechnical
10 Geothermal: How many bores? a) Closed Loop Horizontal Vertical b) Open Loop Surface Discharge Inj. of Water Other (specify):

Was a chemical/bacteriological sample submitted to KDHE? Yes No
Water well disinfected? Yes No
If yes, date sample was submitted:

8 TYPE OF CASING USED: Steel PVC Other CASING JOINTS: Glued Clamped Welded Threaded
Casing diameter 2 in. to 7 ft. Diameter in. to ft. Diameter in. to ft.
Casing height above land surface -0.44 in. Weight lbs./ft. Well thickness or gauge No
TYPE OF SCREEN OR PERFORATION MATERIAL: Steel Stainless Steel Fiberglass PVC Other (Specify)
SCREEN OR PERFORATION OPENINGS ARE: Continuous Slot Mill Slot Gauze Wrapped Torch Cut Drilled Holes Other (Specify)
SCREEN-PERFORATED INTERVALS: From 7 ft. to 17 ft. From ft. to ft. From ft. to ft.
GRAVEL PACK INTERVALS: From 5 ft. to 17 ft. From ft. to ft. From ft. to ft.

9 GROUT MATERIAL: Neat cement Cement grout Bentonite Other Concrete: 0-0.5'
Grout intervals: From 0.5 ft. to 5 ft. From ft. to ft. From ft. to ft.

Nearest source of possible contamination:
Septic Tank Lateral Lines Pit Privy Livestock Pens Insecticide Storage
Sewer Lines Cess Pool Sewage Lagoon Fuel Storage Abandoned Water Well
Watertight Sewer Lines Seepage Pit Feedyard Fertilizer Storage Oil Well / Gas Well
Other (Specify)
Direction from well? Distance from well? ft

Table with 6 columns: FROM, TO, LITHOLOGIC LOG, FROM, TO, LITHO. LOG (cont.) or PLUGGING INTERVALS. Rows show 0-0.5 Concrete, 0.5-14 Clay, 14-17 Shale.

Notes: KDHE ID: Jay Oil Co.; U4-105-15265
Target of monitoring well is shallow groundwater, <20' of grout was installed at the direction of KDHE.

11 CONTRACTOR'S OR LANDOWNER'S CERTIFICATION: This water well was constructed, reconstructed, or plugged under my jurisdiction and was completed on (mo-day-year) 5/2/22 and this record is true to the best of my knowledge and belief. Kansas Water Well Contractor's License No 757 This Water Well Record was completed on (mo-day-year) 5/27/22 under the business name of Larsen & Associates, Inc. Signature

Wyandotte

34-115-2SE

# DENNIS L HANDKE

1820 NW 59th Terrace  
TOPEKA, KANSAS 66618  
785-286-4047 Home

Jess Chapman  
Larsen & Assoc.  
1311 E. 25<sup>th</sup> St., Suite B  
Topeka, Kansas 66046

May 22, 2022

RE: Monitor Well Elevation Survey  
4100 Rainbow Blvd., Kansas City, Kansas

Proj. 22-00BB  
Jay Oil Co.  
KDHE ID U4-105-15265


Bench Mark: Chisled square on SW corner of concrete storm inlet near NE corner of property.  
Elev.: 991.33      North 3456.25      West 28.28      (from SE Cor. Sec. 34-11-25E)

MW-1	rim	995.94	North	3274.63	SE1/4,NE1/4,SE1/4,NE1/4
	top pipe	995.50	West	71.62	Lat = 39.05308    Long = 94.61209
MW-2	rim	994.78	North	3354.08	SE1/4,NE1/4,SE1/4,NE1/4
	top pipe	994.34	West	61.93	Lat = 39.05329    Long = 94.61206
MW-3	rim	995.00	North	3354.44	SE1/4,NE1/4,SE1/4,NE1/4
	top pipe	994.71	West	171.92	Lat = 39.05330    Long = 94.61229
MW-5	rim	995.19	North	3381.79	SW1/4,NW1/4,SW1/4,NW1/4 (Sec. 35-11-25E)
	top pipe	994.85	West	57.65	Lat = 39.05337    Long = 94.61164
MW-6	rim	992.24	North	3436.40	SE1/4,NE1/4,SE1/4,NE1/4
	top pipe	991.90	West	59.42	Lat = 39.05352    Long = 94.61205

Lat & Long derived from Kansas City 7.5' quad map. WGS84.

Elevation derived from Kansas City BM 658-5. NAVD 88.

If you have any questions, please feel free to call me. Thank you for the opportunity to be of service to you.

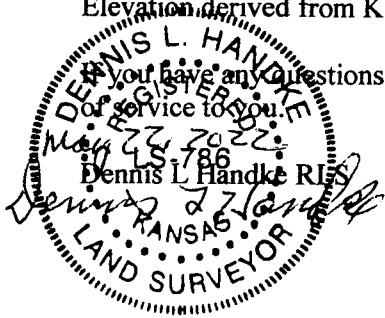

NOTE: Figures exhibited within this report are only to be used within the context of this report. Placement of property lines, wells, structures, and roads is based on the available information from county appraiser maps, surveys, site visits, and/or previous vendor reports and should be considered approximate.

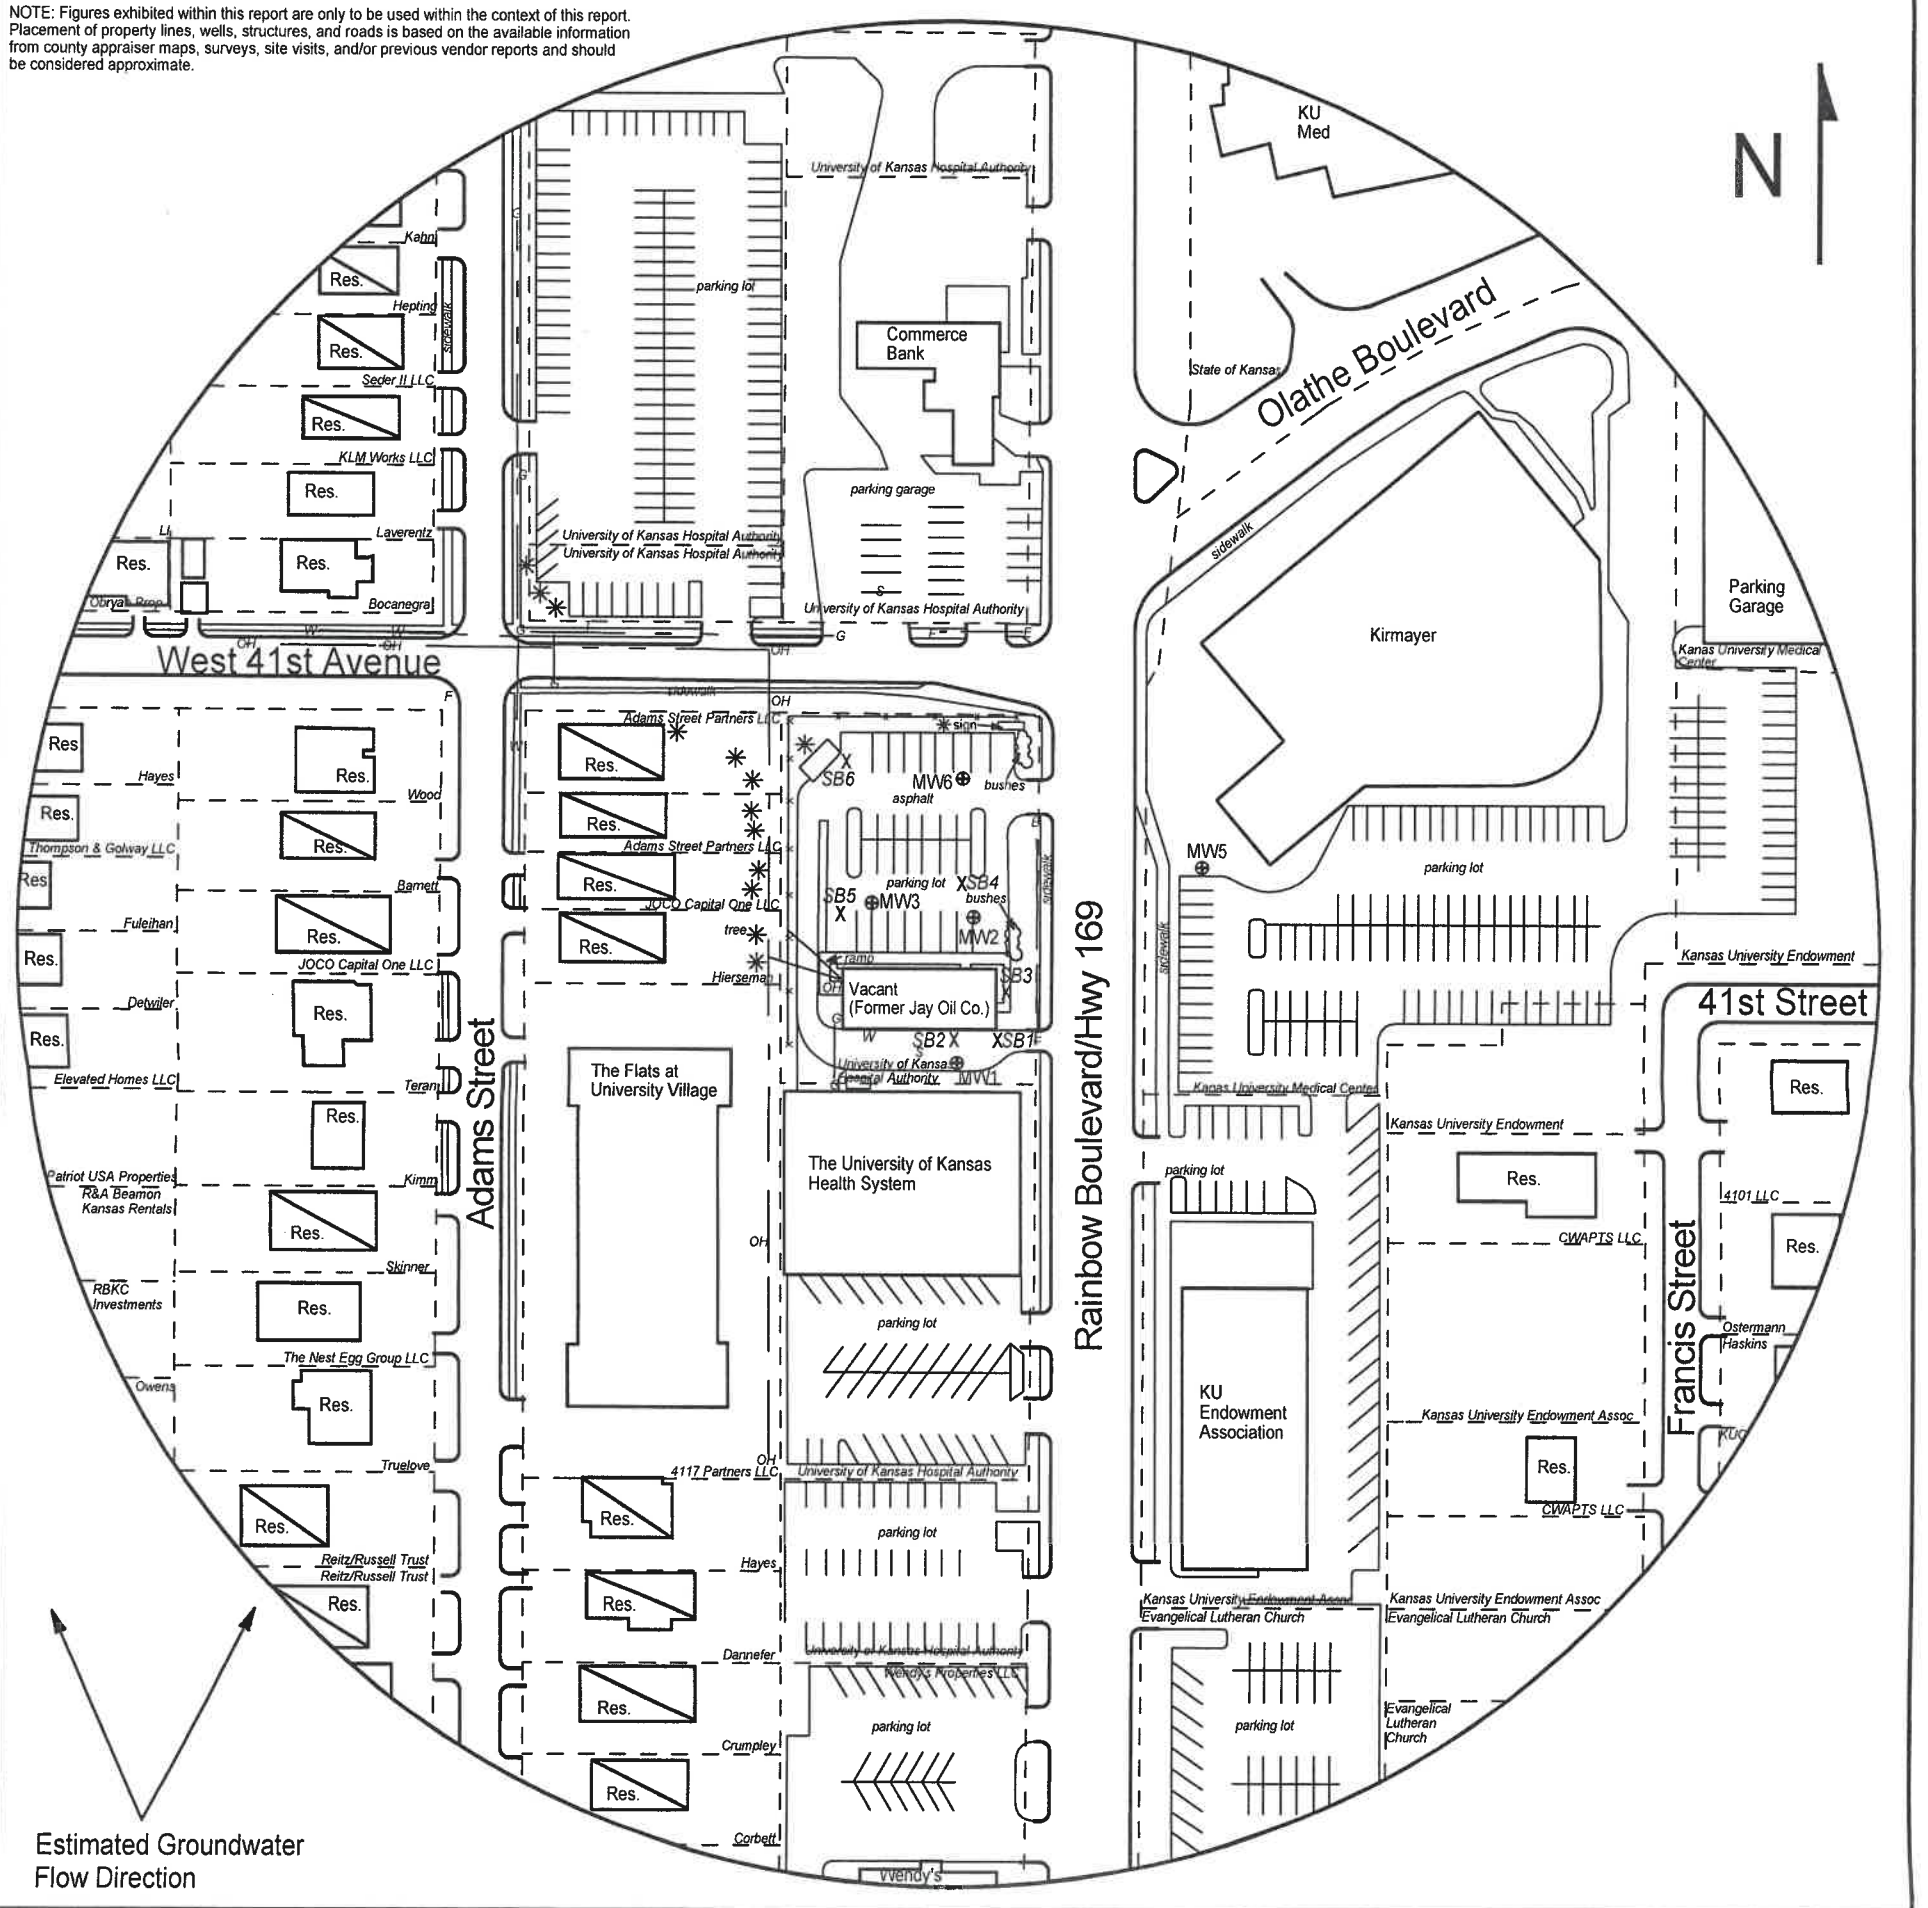


FIGURE 2.1 - 500 FT RADIUS AREA BASE MAP

**LEGEND**

- Building with Basement
- Approximate Location of Property Line
- New Monitoring Well (installed 5/2-4/22)
- Soil Boring (drilled 5/2-4/22)
- Fire Hydrant
- Sewer Inlet
- Telephone Meter
- Electric Lines (1.5 - 3 ft bgs)
- Gas Lines (1.5 - 3 ft bgs)
- Overhead Lines (25'-40' high)
- Water Lines (2 - 6 ft bgs)

NOTE: SB5 & SB6 were drilled to collect hydrologic samples.  
NOTE: Utility depths, heights and locations are approximate.



**PROJECT:**

Jay Oil Co.  
4100 Rainbow Blvd  
Kansas City, KS  
KDHE ID: U4-105-15265  
Date: 5/4/22



1311 E 25th St., Suite B 785-841-8707 office  
Lawrence, KS 66046 785-865-4282 fax