
CONTRACTOR AND ADMINISTRATION OF THE PROPERTY	WATER WELL RECORD	Form WWC-5	KSA 82a-1212		
1 LOCATION OF WATER WELL:	Fraction	Section	Number Town	nship Number	Range Number
County: GARY	SW 1/4 NE 1/4	1/4 3	T	s	R 6 SEW
Distance and direction from nearest town				•	The state of the s
FORT KILLY KS	BLDG388	WP-	8		
2 WATER WELL OWNER: \ US	Army corps of EW	CINEALS.			
RR#, St. Address, Box # : \ 60			Boa	ard of Agriculture, Div	vision of Water Resources
City, State, ZIP Code :	and the second s		Ap	plication Number:	
3 LOCATE WELL'S LOCATION WITH	DEPTH OF COMPLETED WELL	'3O "			Control of the Contro
AN "X" IN SECTION BOX:	Depth(s) Groundwater Encountered _ 1	Z X	. LLLVATION. F.		
	WELL'S STATIC WATER LEVEL	63	I and outlook	urad an maldarium	3-5-38
PLS SUE					
NW NF	Pump test data: Well water			•	01
	Est. Yield gpm: Well wate				
E N	Bore Hole Diameterin. to	30			o
Σ ' ! ! ! ' '	WELL WATER TO BE USED AS:	5 Public water su	pply 8 Air cond	ditioning 11 In	jection well
1	1 Domestic 3 Feedlot	6 Oil field water s	upply 9 Dewate	ring 12 O	ther (Specify below)
244 em em em em em 25 en en	2 Irrigation 4 Industrial	7 Lawn and garde	en only 10 Monitor	ing wellPie.	ZOWET EIL
	Was a chemical/bacteriological sample	submitted to Depar	tment? Yes	.NoX); If yes, n	no/day/yr sample was sub-
discontinue de la contractiva del contractiva de la contractiva del contractiva de la contractiva de l	mitted	·	Water Well Di	isinfected? Yes	No 🔏
5 TYPE OF BLANK CASING USED:	5 Wrought iron	8 Concrete t			Clamped
1 Steel 3 RMP (SR	ū	9 Other (spe		Welded	•
2 PVC 4 ABS	7 Fiberglass	, ,			ed FLUSH
Blank casing diameter					
Casing height above land surface	CA MONTRO				
		Carried States	ios./π. wall this		
TYPE OF SCREEN OR PERFORATION		7 PVC	D. (1900.)	10 Asbestos-cement	
1 Steel 3 Stainless	3	8 RMP (8	SR)	11 Other (specify) .	
2 Brass 4 Galvanize	ed steel 6 Concrete tile	9 ABS		12 None used (oper	n hole)
SCREEN OR PERFORATION OPENING	GS ARE: 5 Gauz	ed wrapped	8 Saw o	out	11 None (open hole)
1 Continuous slot 3 Mil	ll slot 0,0/0 6 Wire	wrapped	9 Drilled	holes	
2 Louvered shutter 4 Ke	y punched 7 Torch	ı cut	10 Other	(specify)	
SCREEN-PERFORATED INTERVALS:	From 3. ft. to .	27	ft., From	, ft. to .	
		Y			
	From ft. to .		ft., From	ft. to .	
GRAVEL PACK INTERVALS:	From		•		
GRAVEL PACK INTERVALS:	Jeg .		ft., From	ft. to.	
GRAVEL PACK INTERVALS: 6 GROUT MATERIAL: 1 Neat or	From ft. to		ft., From ft., From	ft. to	
6 GROUT MATERIAL: 1 Neat co	From	3 Bentonite	ft., From	ft. to. ft. to	ft. ft.
6 GROUT MATERIAL: 1 Neat or Grout Intervals: From	From	3 Bentonite	ft., From	ft. to ft. to	ft. to
6 GROUT MATERIAL: 1 Neat configuration of Grout Intervals: From	From	3 Bentonite	ft., From ft., From 4 Other ft., I 10 Livestock pens	ft. to	ft
6 GROUT MATERIAL: 1 Neat confidence of possible of the second of the sec	From	3 Bentonite ft. to.	ft., From ft., From 4 Other ft., I 10 Livestock pens 11 Fuel storage	ft. to ft. ft. to ft. ft. to ft.	ft. to ft. andoned water well well/Gas well
GROUT MATERIAL: Grout Intervals: From. What is the nearest source of possible of 1 Septic tank 2 Sewer lines 5 Cess	From. ft. to From ft. to ement 2 Cement grout ft. to ft., From contamination: al lines 7 Pit privy pool 8 Sewage lag	3 Bentonite ft. to.	ft., From ft., From 4 Other ft., It. 10 Livestock pens 11 Fuel storage 12 Fertilizer storage	From	ft. to
6 GROUT MATERIAL: 1 Neat or Grout Intervals: From	From. ft. to From ft. to ement 2 Cement grout ft. to 5 ft., From contamination: al lines 7 Pit privy pool 8 Sewage lag	3 Bentonite ft. to.	ft., From 4 Other ft., It., It., It., It., It., It., It., I	From	ft. to
6 GROUT MATERIAL: 1 Neat or Grout Intervals: From	From	3 Bentonite ft. to	ft., From 4 Other 10 Livestock pens 11 Fuel storage 12 Fertilizer storag 13 Insecticide stora How many feet?	From	ft. to
6 GROUT MATERIAL: 1 Neat or Grout Intervals: From	From. ft. to From ft. to ement 2 Cement grout ft. to ft., From contamination: al lines 7 Pit privy pool 8 Sewage lag	3 Bentonite ft. to	ft., From 4 Other ft., It., It., It., It., It., It., It., I	From	ft. to
6 GROUT MATERIAL: 1 Neat or Grout Intervals: From	From	3 Bentonite	ft., From 4 Other 10 Livestock pens 11 Fuel storage 12 Fertilizer storag 13 Insecticide stora How many feet?	From	ft. to
6 GROUT MATERIAL: 1 Neat or Grout Intervals: From	From	3 Bentonite	ft., From 4 Other 10 Livestock pens 11 Fuel storage 12 Fertilizer storag 13 Insecticide stora How many feet?	From	ft. to
6 GROUT MATERIAL: 1 Neat or Grout Intervals: From	From ft. to From ft. to ement 2 Cement grout ft. to 3 ft., From contamination: al lines 7 Pit privy pool 8 Sewage lag age pit 9 Feedyard LITHOLOGIC LOG	3 Bentonite	ft., From 4 Other 10 Livestock pens 11 Fuel storage 12 Fertilizer storag 13 Insecticide stora How many feet?	From	ft. to
6 GROUT MATERIAL: 1 Neat or Grout Intervals: From	From	3 Bentonite	ft., From 4 Other 10 Livestock pens 11 Fuel storage 12 Fertilizer storag 13 Insecticide stora How many feet?	From	ft. to
6 GROUT MATERIAL: 1 Neat or Grout Intervals: From	From ft. to From ft. to ement 2 Cement grout ft. to 3 ft., From contamination: al lines 7 Pit privy pool 8 Sewage lag age pit 9 Feedyard LITHOLOGIC LOG	3 Bentonite	ft., From 4 Other 10 Livestock pens 11 Fuel storage 12 Fertilizer storag 13 Insecticide stora How many feet?	From	ft. to
6 GROUT MATERIAL: 1 Neat or Grout Intervals: From	From ft. to From ft. to ement 2 Cement grout ft. to 3 ft., From contamination: al lines 7 Pit privy pool 8 Sewage lag age pit 9 Feedyard LITHOLOGIC LOG	3 Bentonite	ft., From 4 Other 10 Livestock pens 11 Fuel storage 12 Fertilizer storag 13 Insecticide stora How many feet?	From	ft. to
GROUT MATERIAL: Grout Intervals: From What is the nearest source of possible of 1 Septic tank Sep	From	3 Bentonite	ft., From 4 Other 10 Livestock pens 11 Fuel storage 12 Fertilizer storag 13 Insecticide stora How many feet?	From	ft. to
GROUT MATERIAL: Grout Intervals: From What is the nearest source of possible of 1 Septic tank Sep	From	3 Bentonite	ft., From 4 Other 10 Livestock pens 11 Fuel storage 12 Fertilizer storag 13 Insecticide stora How many feet?	From	ft. to
GROUT MATERIAL: Grout Intervals: From What is the nearest source of possible of 1 Septic tank Sewer lines Watertight sewer lines Watertight sewer lines MODIFICATION FROM TO CONTRACTOR'S OR LANDOWNER completed on (mo/day/year).	From ft. to From ft. to From ft. to Ement 2 Cement grout If. to 5 ft., From Contamination: al lines 7 Pit privy pool 8 Sewage lag age pit 9 Feedyard LITHOLOGIC LOG TOTIVES ASSIGNMENT CONTROL LITION CONTR	3 Bentonite ft. to	ft., From 4 Other 10 Livestock pens 11 Fuel storage 12 Fertilizer storag 13 Insecticide stora How many feet? TO	From	ft. to
GROUT MATERIAL: 1 Neat of Grout Intervals: From	From ft. to From ft. to From ft. to From ft. to From ft. to From ft. to From ft. to From ft. to Contamination: I lines 7 Pit privy Freedyard LITHOLOGIC LOG FUSH WSTOCCO LITINGS FINE CERTIFICATION: This water well was a contamination. FINE CERTIFICATION: This water well was a contamination.	Jamentonite ft. to FROM Poon vas (1) constructed and Vell Record was co	ft., From 4 Other 10 Livestock pens 11 Fuel storage 12 Fertilizer storage 13 Insecticide stora How many feet? TO 1, (2) reconstructed, If this record is true to completed on (mo/da)	From	ft. to
GROUT MATERIAL: 1 Neat or Grout Intervals: From	From ft. to From ft. to ement 2 Cement grout ft. to ft., From contamination: al lines 7 Pit privy pool 8 Sewage lag age pit 9 Feedyard LITHOLOGIC LOG TOTAL CITIVOS A'S CERTIFICATION: This water well v	Bentonite ft. to FROM Poon FROM Constructed and Well Record was constructed was constructed and cons	ft., From 4 Other 10 Livestock pens 11 Fuel storage 12 Fertilizer storag 13 Insecticide stora How many feet? TO 1, (2) reconstructed, and this record is true to	From	ft. to

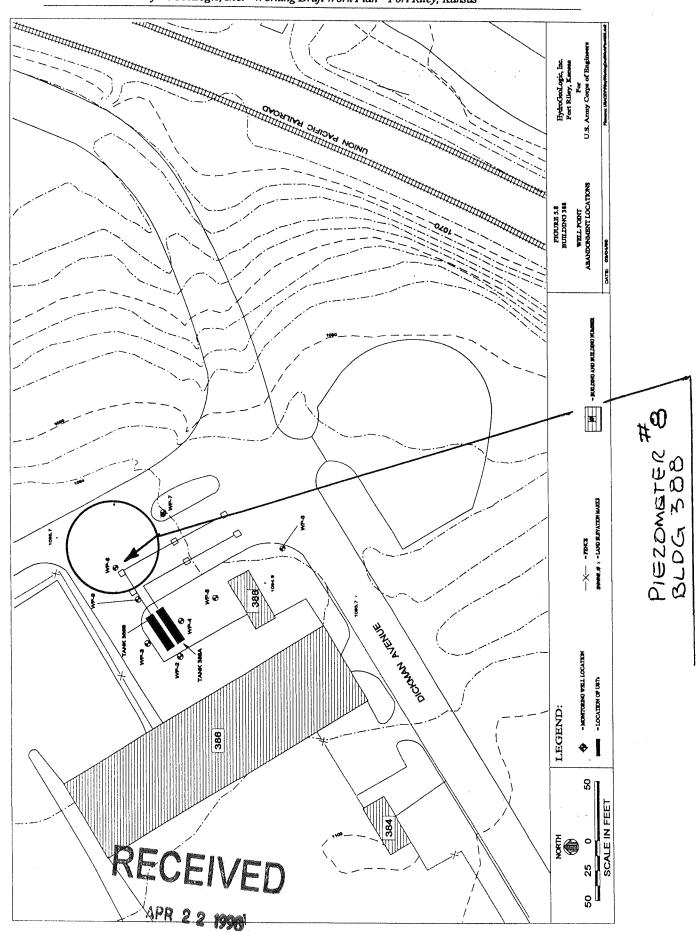

BUREAU OF MARKET STATES AND STATES OF LANGE ST