

WATER WELL RECORD Form WWC-5


Division of Water Resources App. No.

Well ID 1637-03

Original Record Correction Change in Well Use

1 LOCATION OF WATER WELL: County: <u>Riley</u>	Fraction <u>NE 1/4 NW 1/4 SE 1/4 NW 1/4</u>	Section Number <u>13</u>	Township Number <u>T 11 S</u>	Range Number <u>R 6</u> <input checked="" type="checkbox"/> E <input type="checkbox"/> W
--	--	-----------------------------	----------------------------------	---

2 WELL OWNER: Last Name: <u>US Army DPW Environmental Division</u> First: <u> </u> Business: <u>US Army DPW Environmental Division</u> Address: <u>404 Pershing Court</u> Address: <u> </u> City: <u>Fort Riley</u> State: <u>KS</u> ZIP: <u>66442</u>	Street or Rural Address where well is located (if unknown, distance and direction from nearest town or intersection): If at owner's address, check here: <input type="checkbox"/> <u>Approximately 350 ft. S & 100 ft. E of intersection of 8th Street and L St.</u>
---	---

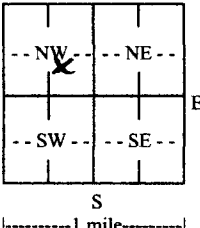3 LOCATE WELL WITH "X" IN SECTION BOX: 	4 DEPTH OF COMPLETED WELL: <u>35</u> ft. Depth(s) Groundwater Encountered: 1) <u>20.0</u> ft. 2) <u> </u> ft. 3) <u> </u> ft., or 4) <input type="checkbox"/> Dry Well WELL'S STATIC WATER LEVEL: <u> </u> ft. <input type="checkbox"/> below land surface, measured on (mo-day-yr) <u> </u> <input type="checkbox"/> above land surface, measured on (mo-day-yr) <u> </u> Pump test data: Well water was <u> </u> ft. after <u> </u> hours pumping <u> </u> gpm Well water was <u> </u> ft. after <u> </u> hours pumping <u> </u> gpm Estimated Yield: <u> </u> gpm Bore Hole Diameter: <u>8.75</u> in. to <u>35</u> ft. and <u> </u> in. to <u> </u> ft.	5 Latitude: <u>39.098252</u> (decimal degrees) Longitude: <u>-96.719008</u> (decimal degrees) Horizontal Datum: <input checked="" type="checkbox"/> WGS 84 <input type="checkbox"/> NAD 83 <input type="checkbox"/> NAD 27 Source for Latitude/Longitude: <input type="checkbox"/> GPS (unit make/model: <u> </u>) (WAAS enabled? <input type="checkbox"/> Yes <input type="checkbox"/> No) <input checked="" type="checkbox"/> Land Survey <input type="checkbox"/> Topographic Map <input type="checkbox"/> Online Mapper: <u> </u>
6 Elevation: <u>NA</u> ft. <input type="checkbox"/> Ground Level <input type="checkbox"/> TOC Source: <input type="checkbox"/> Land Survey <input type="checkbox"/> GPS <input type="checkbox"/> Topographic Map <input type="checkbox"/> Other <u> </u>		

7 WELL WATER TO BE USED AS:

1. Domestic: <input type="checkbox"/> Household <input type="checkbox"/> Lawn & Garden <input type="checkbox"/> Livestock 2. <input type="checkbox"/> Irrigation 3. <input type="checkbox"/> Feedlot 4. <input type="checkbox"/> Industrial	5. <input type="checkbox"/> Public Water Supply: well ID <u> </u> 6. <input type="checkbox"/> Dewatering: how many wells? <u> </u> 7. <input type="checkbox"/> Aquifer Recharge: well ID <u> </u> 8. <input checked="" type="checkbox"/> Monitoring: well ID <u>1637-03</u> 9. Environmental Remediation: well ID <u> </u> <input type="checkbox"/> Air Sparge <input type="checkbox"/> Soil Vapor Extraction <input type="checkbox"/> Recovery <input type="checkbox"/> Injection	10. <input type="checkbox"/> Oil Field Water Supply: lease <u> </u> 11. Test Hole: well ID <u> </u> <input type="checkbox"/> Cased <input type="checkbox"/> Uncased <input type="checkbox"/> Geotechnical 12. Geothermal: how many bores? <u> </u> a) Closed Loop <input type="checkbox"/> Horizontal <input type="checkbox"/> Vertical b) Open Loop <input type="checkbox"/> Surface Discharge <input type="checkbox"/> Inj. of Water 13. <input type="checkbox"/> Other (specify): <u> </u>
---	--	---

Was a chemical/bacteriological sample submitted to KDHE? Yes No If yes, date sample was submitted:
 Water well disinfected? Yes No

8 TYPE OF CASING USED: Steel PVC Other CASING JOINTS: Glued Clamped Welded Threaded
 Casing diameter 2 in. to 20 ft., Diameter in. to ft., Diameter in. to ft.
 Casing height above land surface 0 in. Weight lbs./ft. Wall thickness or gauge No. SCH 40
TYPE OF SCREEN OR PERFORATION MATERIAL:
 Steel Stainless Steel Fiberglass PVC Other (Specify)
 Brass Galvanized Steel Concrete tile None used (open hole)
SCREEN OR PERFORATION OPENINGS ARE:
 Continuous Slot Mill Slot Gauze Wrapped Torch Cut Drilled Holes Other (Specify)
 Louvered Shutter Key Punched Wire Wrapped Saw Cut None (Open Hole)
SCREEN-PERFORATED INTERVALS: From 20 ft. to 35 ft., From ft. to ft., From ft. to ft.
GRAVEL PACK INTERVALS: From 18 ft. to 35 ft., From ft. to ft., From ft. to ft.

9 GROUT MATERIAL: Neat cement Cement grout Bentonite Other
 Grout Intervals: From 0 ft. to 18 ft., From ft. to ft., From ft. to ft.
Nearest source of possible contamination:
 Septic Tank Lateral Lines Pit Privy Livestock Pens Insecticide Storage
 Sewer Lines Cess Pool Sewage Lagoon Fuel Storage Abandoned Water Well
 Watertight Sewer Lines Seepage Pit Feedyard Fertilizer Storage Oil Well/Gas Well
 Other (Specify) Pol. Sites
 Direction from well? Distance from well? ft.

10 FROM	TO	LITHOLOGIC LOG	FROM	TO	LITHO. LOG (cont.) or PLUGGING INTERVALS
0	6	Clay, dark gray, stiff			
6	7	Silt, brown, damp			
7	10	Sand, brown, fine grain, damp			
10	16	Sand, brown, medium grain, moist			
16	35	Sand, brown, coarse grain, moist to wet			
Notes:					

11 CONTRACTOR'S OR LANDOWNER'S CERTIFICATION: This water well was constructed, reconstructed, or plugged under my jurisdiction and was completed on (mo-day-year) 11-14-2019 and this record is true to the best of my knowledge and belief. Kansas Water Well Contractor's License No. 604 This Water Well Record was completed on (mo-day-year) 1/3/20 under the business name of Environmental Priority Service, Inc. Signature P. H. [Signature]

Riley

14-11-6E

Figure 2.7
FTRI-063
(POL Site 1044)

- Legend
- ◆ Performance Monitoring Well
 - ▲ Extraction Well
 - ◆ Perimeter Monitoring Well (Gauge only)
 - Site Boundary
 - Discharge Piping
 - Piping/Trench Runs
 - Treatment System Enclosure
 - Underground Storage System

Notes:
 DPE= dual phase extraction
 DTP= direct-push technology
 MW= Monitoring well
 POL= petroleum, oil, and lubricant


RECEIVED

JAN 15 2020

BUREAU OF WATER



Los Alamos Technical Associates, Inc.

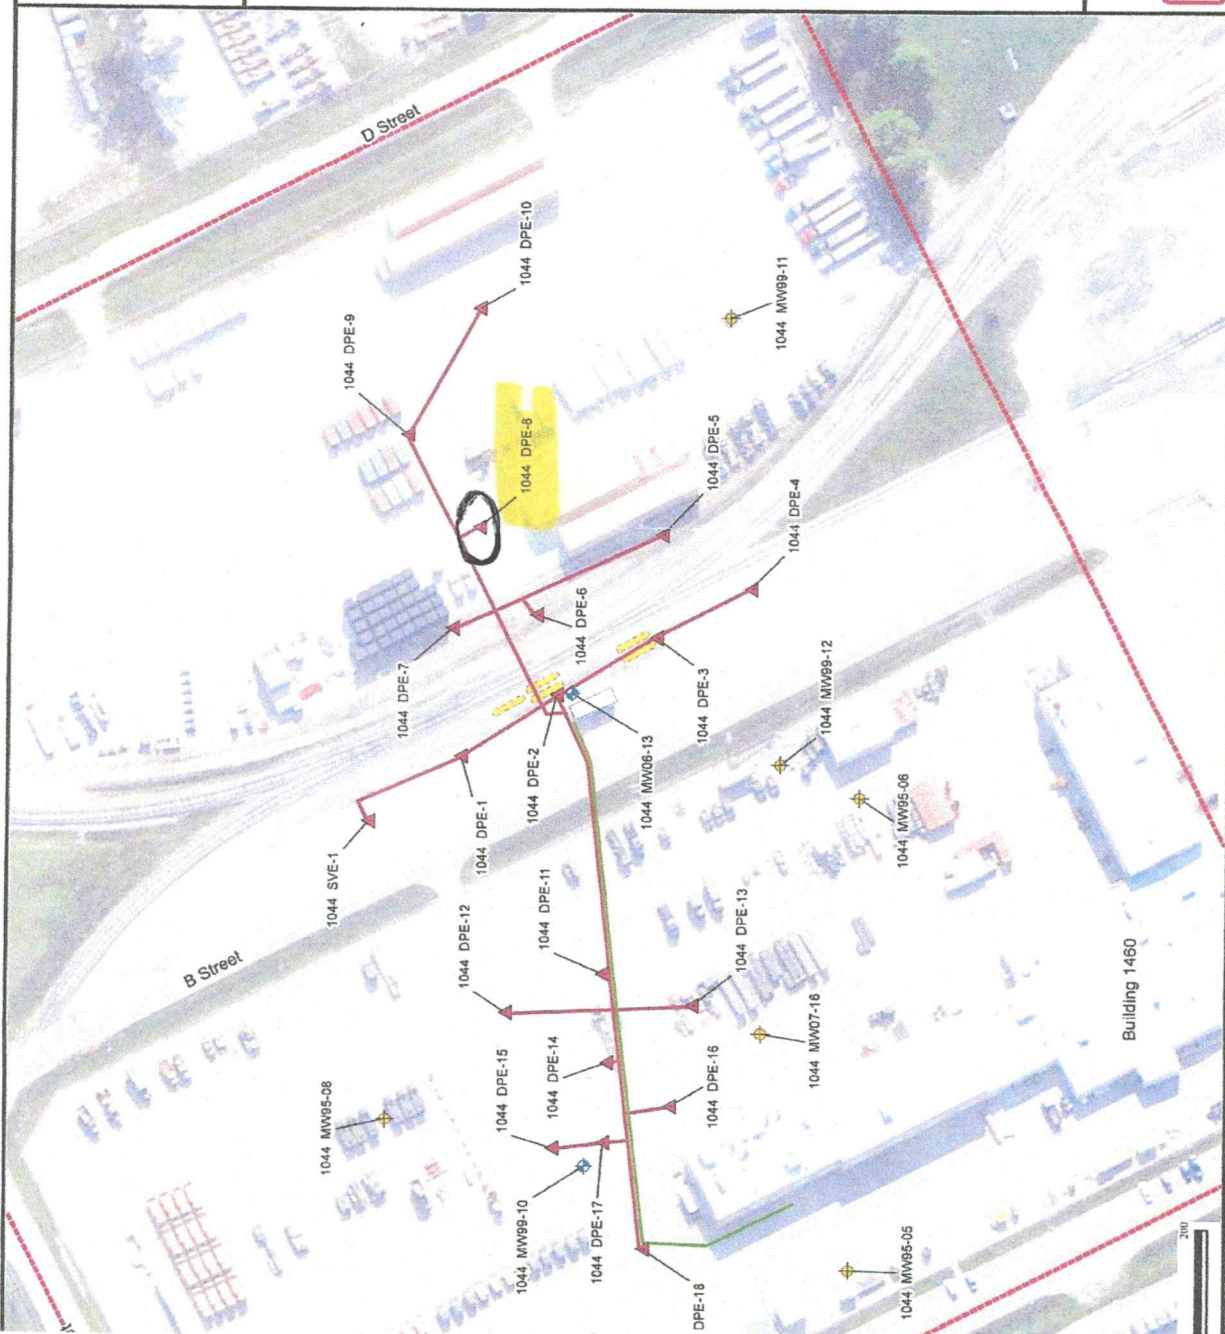

7
1
210
FTRI-063 (POL Site 1044) Sample Locations.mxd

Riley

14-11-6E

