

WATER WELL RECORD Form WWC-5

Original Record Correction Change in Well Use

Division of Water Resources App. No.

[Empty Box]

Well ID

INJ-354-23-1

1 LOCATION OF WATER WELL: County: Geary Fraction SE 1/4 SE 1/4 NW 1/4 SW 1/4 Section Number 28 Township Number T 11 S Range Number R 6 E W

2 WELL OWNER: Last Name: Jones First: David Street or Rural Address where well is located (if unknown, distance and direction from nearest town or intersection): If at owner's address, check here: Fort Riley Building #354 Fort Riley, KS 66442

3 LOCATE WELL WITH "X" IN SECTION BOX: [Diagram] 4 DEPTH OF COMPLETED WELL: 40.0 ft. 5 Latitude: 39.0628321 Longitude: -96.7769047 6 Elevation: 1096.35 ft.

7 WELL WATER TO BE USED AS: 1. Domestic: Household, Lawn & Garden, Livestock, Irrigation, Feedlot, Industrial. 2. Public Water Supply, Dewatering, Aquifer Recharge, Monitoring, Environmental Remediation, Air Sparge, Recovery, Injection. 10. Oil Field Water Supply, Test Hole, Geothermal, Other.

Was a chemical/bacteriological sample submitted to KDHE? Yes No If yes, date sample was submitted:


8 TYPE OF CASING USED: Steel PVC Other CASING JOINTS: Glued Clamped Welded Threaded Casing diameter 2 in. to 30.0 ft. Diameter N/A in. to N/A ft. Diameter N/A in. to N/A ft. Casing height above land surface 0 in. Weight N/A lbs./ft. Wall thickness or gauge No. Sch. 40. TYPE OF SCREEN OR PERFORATION MATERIAL: Steel Stainless Steel Fiberglass PVC Other (Specify). SCREEN OR PERFORATION OPENINGS ARE: Continuous Slot Mill Slot Gauze Wrapped Torch Cut Drilled Holes Other (Specify). SCREEN-PERFORATED INTERVALS: From 30.0 ft. to 40.0 ft. GRAVEL PACK INTERVALS: From 27.0 ft. to 40.0 ft.

9 GROUT MATERIAL: Neat cement Cement grout Bentonite Other Concrete 0-2 feet Grout Intervals: From 2 ft. to 27.0 ft. Nearest source of possible contamination: Septic Tank Lateral Lines Pit Privy Livestock Pens Insecticide Storage Sewer Lines Cess Pool Sewage Lagoon Fuel Storage Abandoned Water Well Watertight Sewer Lines Seepage Pit Feedyard Fertilizer Storage Oil Well/Gas Well Other (Specify) Solvent storage at former Building 354. Direction from well? Northeast Distance from well? 275 ft.

Table with 6 columns: FROM, TO, LITHOLOGIC LOG, FROM, TO, LITHO. LOG (cont.) or PLUGGING INTERVALS. Row 1: 0, 1, Asphalt/fill. Row 2: 1, 40, Light brown fine-grained sand. Includes a Notes section.

11 CONTRACTOR'S OR LANDOWNER'S CERTIFICATION: This water well was constructed, reconstructed, or plugged under my jurisdiction and was completed on (mo-day-year) 9/5/2023 and this record is true to the best of my knowledge and belief. Kansas Water Well Contractor's License No. 759. This Water Well Record was completed on (mo-day-year) 9/18/2023 under the business name of RAZEK Environmental, LLC. Signature [Signature]




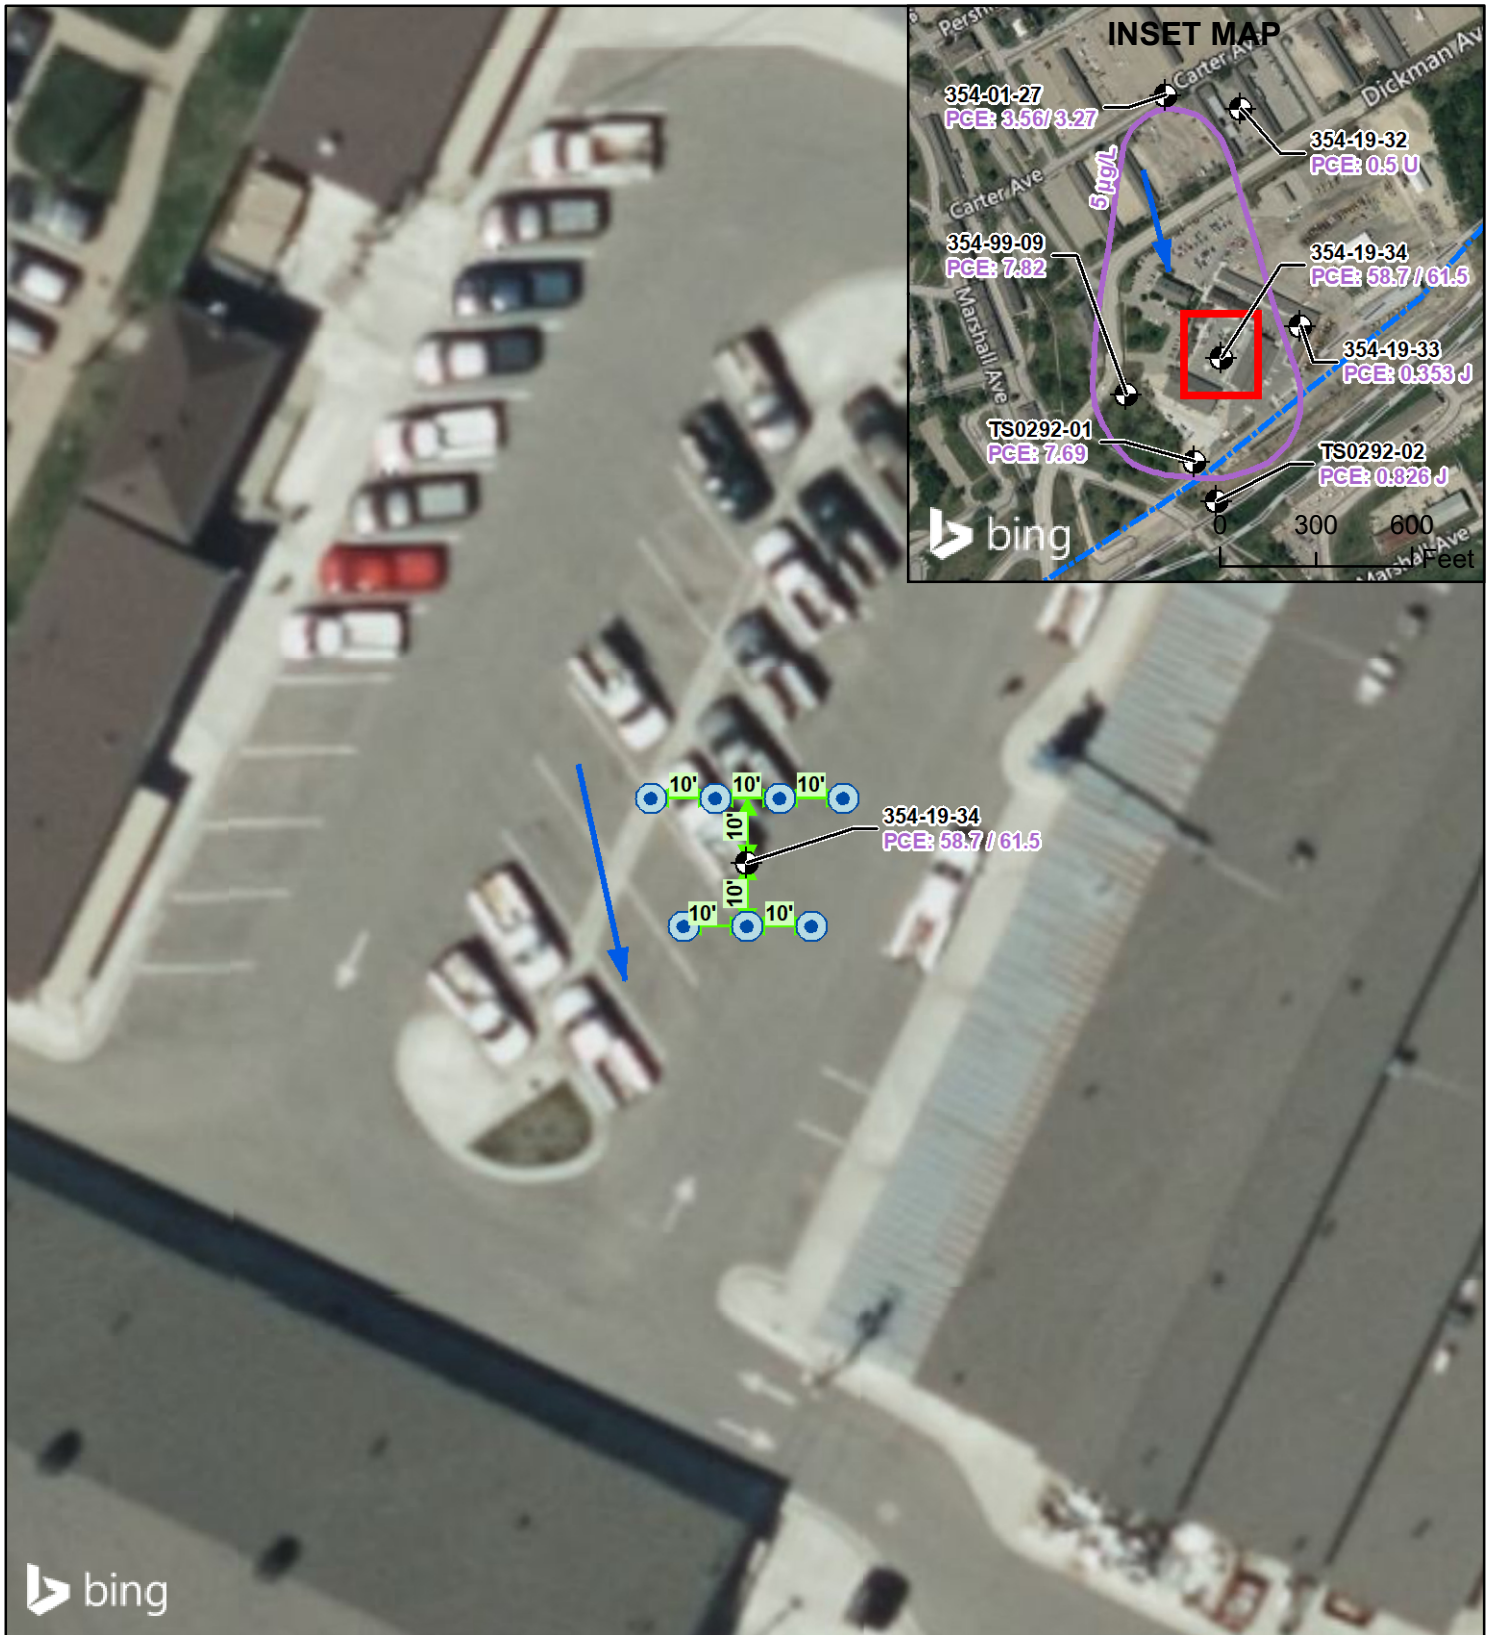


**Legend**

- Proposed Injection Points
- Monitoring Well
- Groundwater Flow Direction
- PCE Isoconcentration Contour
- Aquifer Boundary
- Distance (FT)

**NOTES**

1. Coordinate System: NAD 1983 State Plane Kansas North in US Feet
2. PCE = tetrachloroethene
3. All results in micrograms per liter ( $\mu\text{g/L}$ ).
4. PCE PAL in groundwater is  $5 \mu\text{g/L}$ .
5. When two results are shown, the second is the duplicate result.
6. J = estimated value
7. U = compound was not detected
8.  $\mu\text{g/L}$  = micrograms per liter

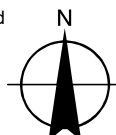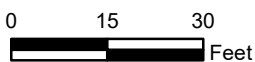

**U.S. ARMY FORT RILEY  
FORT RILEY, KANSAS**

**INJECTION CONFIGURATION  
354 AREA SOLVENT DETECTIONS SITE**



**U.S. Army  
Fort Riley**  
Home of the 1st  
Infantry Division

FIGURE  
**1**