

WATER WELL RI		WWC-5		ision of Water		INJ-354-23-7	
Original Record		ge in Well Use		urces App. No.		Well ID	
1 LOCATION OF WA	ATER WELL:	Fraction SE 1/4 SE 1/4 NW 1/4		tion Number	Township Number		
2 WELL OWNER: Last Name: Jones First: David Street or Rural Address where well is located (if unknown, distance and							
Business: Fort Rilev Address: Shoridan Hall Building 407 Perching Court							
Address: Sheridan Hall Building 407 Pershing Court Fort Riley Building #354							
City: Fort Riley State: KS ZIP: 66442 Fort Riley, KS 66442							
3 LOCATE WELL					30 063833	1	
4 DEPIH OF COMPLETED WELL:							
Depth(s) Groundwater Encountered: 1)				. ft. Longitude: -96.7769047 (decimal degrees)			
2)N/A ft. 3)N/A ft., or 4) \(\subseteq \text{Dry V} \) WELL'S STATIC WATER LEVEL:							
below land surface, measured on (mo-day-yr)				Source for Latitude/Longitude: GPS (unit make/model:)			
The standard from the standard from day year				(WAAS enabled? Yes No)			
NWNE	Pump test data: Well water was N/A ft				Land Survey Topographic Map		
W	Pump test data: Well water was				Online Mapper:		
	Well water wasN/A ft.						
SW SE	after. N/A hour	s pumpingN/A	. gpm		1096 35	E.G. 11 -1 E.TOG	
	Estimated Vield: N/A gram 6 Elevation:					Ground Level TOC	
S	Bore Hole Diameter:	7.25 in. to 40.0	ft. and	Source: Land Survey GPS Topographic Map			
1 mile N/A in to N/A ft. Uniter							
7 WELL WATER TO BE USED AS:							
1. Domestic:	5. Public Water Supply: well ID						
☐ Household	6. Dewatering: how many wells?						
☐ Lawn & Garden	7. ☐ Aquifer Recharge: well ID						
Livestock							
2. Irrigation							
3. Feedlot	☐ Air Sparg						
Was a chemical/bacteriological sample submitted to KDHE? Yes No If yes, date sample was submitted:							
Water well disinfected? Yes No							
8 TYPE OF CASING USED: Steel PVC Other CASING JOINTS: Glued Clamped Welded Threaded							
Casing diameter 2 in to 30.0 ft., Diameter N/A in to N/A ft. Casing height above land surface 0 in. Weight N/A lbs./ft. Wall thickness or gauge No. Sch. 40							
Casing height above land surface							
TYPE OF SCREEN OR PERFORATION MATERIAL: Steel							
_ Stool _ Stamped Stool							
SCREEN OR PERFORATION OPENINGS ARE: ☐ Continuous Slot Mill Slot ☐ Gauze Wrapped ☐ Torch Cut ☐ Drilled Holes ☐ Other (Specify)							
Louvered Shutter Key Punched Wire Wrapped Saw Cut None (Open Hole) SCREEN-PERFORATED INTERVALS: From .30.0 ft. to .40.0 ft., From .N/A ft. to .N/A ft. to .N/A ft. to .N/A ft.							
GRAVEL PACK INTERVALS: From 27.0. ft. to 40.0. ft., From WA ft. to .							
OKAVEL PACK INTERVALS. FIGHT							
9 GROUT MATERIAL: Neat cement Cement grout Bentonite Other Concrete 0-2 feet Grout Intervals: From 2 ft. to 27.0 ft., From N/A ft. to N/A ft., From N/A ft.							
Rearest source of possible contamination:							
Nearest source of possible Septic Tank	e contamination: Lateral Lin	es	i i	Livestock Pens	☐ Insectici	de Storage	
Septic Tank Septi							
☐ Watertight Sewer Lin				Fertilizer Stora			
Both of Charactery Solvent storage at former Building 35/							
Direction from well? Northeast Distance from well? .4/.5							
10 FROM TO	LITHOLO	GIC LOG	FROM	TO L	ITHO. LOG (cont.) or	PLUGGING INTERVALS	
The state of the s	\sphalt/fill				the second of th		
	ight brown fine-grain	ned sand					
	and the state of t						
		and the second s					
			Notes:				
11 CONTRACTOR'S OR LANDOWNER'S CERTIFICATION: This water well was constructed, reconstructed, or plugged							
under my jurisdiction and was completed on (mo-day-year) 9/6/2023 and this record is true to the best of my knowledge and belief.							
Kansas Water Well Contractor's License No. 759 This Water Well Record was completed on (mo-day-year) 9/18/2023 Under the business name of RAZEK Environmental LLC Signature							
under the business name	of RAZEK Enviror	mental, LLC		ignature			
Mail 1 white copy along with a fee of \$5.00 for each constructed well to: Kansas Department of Health and Environment, Bureau of Water, GWTS Section,							
1000 SW Jackson St., Suite 420, Topeka, Kansas 66612-1367. Mail one to Water Well Owner and retain one for your records. Telephone 785-296-5524.							
Visit us at http://www.kdheks.gov/waterwell/index.html KSA 82a-1212 Revised 7/10/2015							

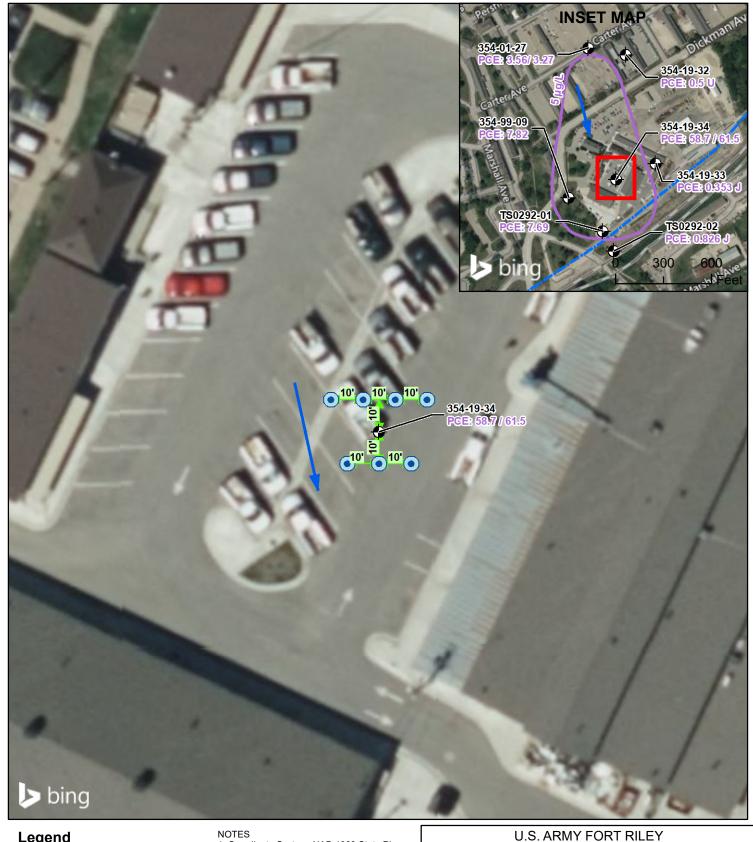

Legend

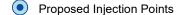

Monitoring Well

Groundwater Flow Direction

PCE Isoconcentration Contour

Aquifer Boundary

Distance (FT)

- 1. Coordinate System: NAD 1983 State Plane Kansas North in US Feet
- 2. PCE = tetrachloroethene
- All results in micrograms per liter (μg/L).
 PCE PAL in groundwater is 5 μg/L.
- 5. When two results are shown, the second is the duplicate result.
- 6. J = estimated value
 7. U = compound was not detected
 8. µg/L = micrograms per liter

15 30



INJECTION CONFIGURATION 354 AREA SOLVENT DETECTIONS SITE

FORT RILEY, KANSAS

U.S. Army Fort Riley Home of the 1st Infantry Division

FIGURE