

WATER WELL RI		WWC-5		sion of Water		INJ-354-23-2	
Original Record		ge in Well Use		urces App. No.		Vell ID	
1 LOCATION OF WA	ATER WELL:	Fraction		ion Number	Township Number	Range Number	
County: Geary	SE¼ SE¼ NW ¼				R 6 ME W		
2 WELL OWNER: Last Name: Jones First: David Street or Rural Address where well is located (if unknown, distance and							
Business: Fort Riley  Address: Sheriden Hell Building 407 Perching Court							
Address: Sheridan Hall Building 407 Pershing Court Address: Fort Riley Building #354							
City: Fort Riley	State: KS		Fort Riley, K				
3 LOCATE WELL	1			1	20 0629321		
WITH "X" IN	4 DEPTH OF CON	MPLETED WELL:	<del>4.</del> ү,ү ft.	5 Latitude	06 776004	(decimal degrees)	
SECTION BOX:  Depth(s) Groundwater Encountered: 1)34				Longitude: -96.7769047 (decimal degrees) Horizontal Datum: □ WGS 84 ■ NAD 83 □ NAD 27			
N	WELL'S STATIC WATER LEVEL: ft.				Source for Latitude/Longitude:		
	below land surface, measured on (mo-day-yr)				GPS (unit make/model:)		
NW NE					(WAAS enabled? Yes No)		
NW NE	Pump test data: Well v	water wasN/A	ft.	■ Land Survey ☐ Topographic Map			
$ \mathbf{w} $	afterN/A hours pumping N/A gpm				Online Mapper:		
	Well water wasN/A ft.						
XW SE	after N/A hours pumping N/A gpm  6 Elevation: 1096.35 ft. Ground Level						
	Estimated Yield:N/	Agpm 7.25		Source: Land Survey GPS Topographic Map			
S	Estimated Yield:N/Agpm  Bore Hole Diameter:7.25 in. toN/A ft.  6 Elevation:1090.35ft.						
1 mile1							
7 WELL WATER TO BE USED AS: 1. Domestic: 5.  Public Water Supply: well ID							
1. Domestic:							
☐ Household ☐ Lawn & Garden	O						
Livestock	en 7. Aquifer Recharge: well ID						
2. Irrigation	9. Environmental Remediation: well ID						
3. ☐ Feedlot	☐ Air Sparg	ge Soil Vapor	Extraction	b) Oper	Loop Surface Disch	arge  Inj. of Water	
4. ☐ Industrial	☐ Recovery	Injection		13. 🔲 Othe	r (specify):		
Was a chemical/bacteriological sample submitted to KDHE? ☐ Yes ■ No If yes, date sample was submitted:							
Water well disinfected?  \( \text{Yes} \) No							
O TYPE OF CASING LISED. T Steel Proc T Other CASING JOINTS: T Glued T Clamped T Welded Threaded							
Casing diameter 2 in to 30.0 ft Diameter N/A in to N/A ft. Diameter N/A in to N/A ft.							
Casing diameter 2 in to 30.0 ft., Diameter N/A in to N/A ft. Casing height above land surface 0 in. Weight N/A lbs./ft. Wall thickness or gauge No. Sch. 40							
TYPE OF SCREEN OR PERFORATION MATERIAL:							
☐ Steel ☐ Stainless Steel ☐ Fiberglass ☐ PVC ☐ Other (Specify)							
☐ Brass ☐ Galvanized Steel ☐ Concrete tile ☐ None used (open hole)							
SCREEN OR PERFORATION OPENINGS ARE:							
☐ Continuous Slot ☐ Mill Slot ☐ Gauze Wrapped ☐ Torch Cut ☐ Drilled Holes ☐ Other (Specify)							
Louvered Shutter    Key Punched    Wire Wrapped    Saw Cut    None (Open Hole)							
SCREEN-PERFORATED INTERVALS: From .30.0 ft. to .40.0 ft., From .N/A ft. to .N/A ft. From .N/A ft. to .N/A ft.							
GRAVEL PACK INTERVALS: From 27.0. ft. to 40.0. ft., From N/A ft. to N/A ft., From N/A ft. to N/A ft.							
9 GROUT MATERIAL: Neat cement Cement grout Bentonite Other Concrete 0-2 feet Grout Intervals: From 2 ft. to .27.0 ft., From .N/A ft. to N/A ft. from .N/A ft. to N/A ft.							
Nearest source of possible contamination:  ☐ Septic Tank ☐ Lateral Lines ☐ Pit Privy ☐ Livestock Pens ☐ Insecticide Storage							
☐ Septic Tank       ☐ Lateral Lines       ☐ Pit Privy       ☐ Livestock Pens       ☐ Insecticide Storage         ☐ Sewer Lines       ☐ Cess Pool       ☐ Sewage Lagoon       ☐ Fuel Storage       ☐ Abandoned Water Well							
☐ Watertight Sewer Lin				Fertilizer Stora			
Other (Specify) So	went storage at form	er Building 354					
Direction from well? .No.	rtheast	Distance from v	well? .27.5		ft.		
10 FROM TO	LITHOLO	OGIC LOG	FROM	TO L	ITHO. LOG (cont.) or P	LUGGING INTERVALS	
	Asphalt/fill					**************************************	
1 40 L	ight brown fine-grain	ned sand					
		and the second s					
		alance to the second consequence of the seco					
				LL			
	Notes:						
11 CONTRACTOR'S OR LANDOWNER'S CERTIFICATION: This water well was constructed, reconstructed, or plugged under my jurisdiction and was completed on (mo-day-year) 9/5/2023 and this record is true to the best of my knowledge and belief.							
Kansas Water Well Contractor's License No. 759 This Water Well Record was completed on (mo-day-year) 9/18/2023							
under the business name of RAZEK Environmental, LLC Signature							
Mail I white copy along with a fee of \$5.00 for each constructed well to: Kansas Department of Health and Environment, Bureau of Water, GWTS Section,							
1000 SW Jackson St., Suite 420, Topeka, Kansas 66612-1367. Mail one to Water Well Owner and retain one for your records. Telephone 785-296-5524.							
Visit us at http://www.kdheks.gov/waterwell/index.html KSA 82a-1212 Revised 7/10/2015							

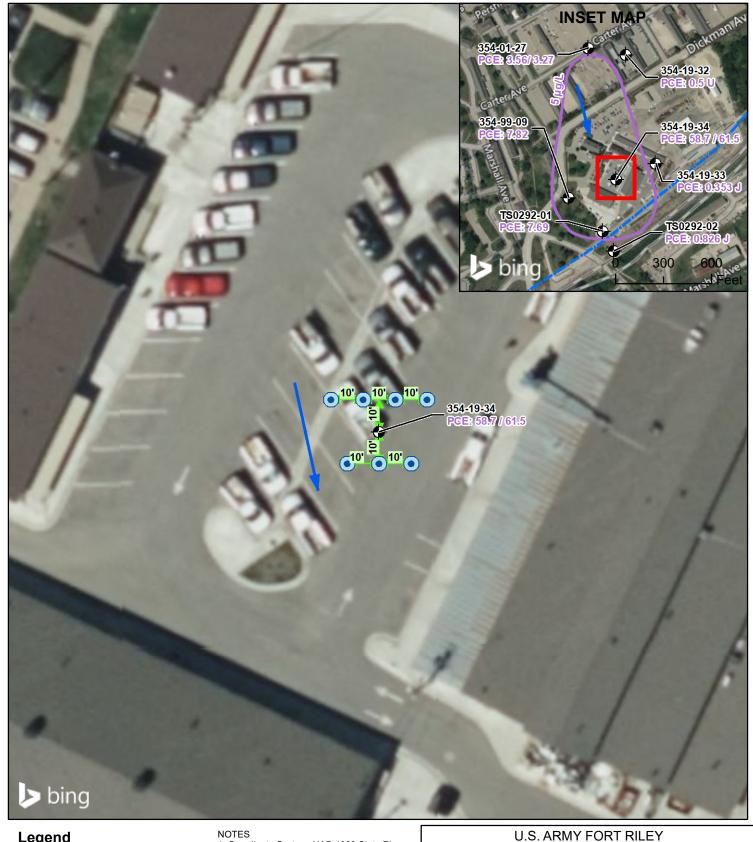

## Legend

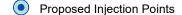

Monitoring Well

**Groundwater Flow Direction** 

PCE Isoconcentration Contour

Aquifer Boundary

Distance (FT)

- 1. Coordinate System: NAD 1983 State Plane Kansas North in US Feet
- 2. PCE = tetrachloroethene
- All results in micrograms per liter (μg/L).
   PCE PAL in groundwater is 5 μg/L.
- 5. When two results are shown, the second is the duplicate result.
- 6. J = estimated value
  7. U = compound was not detected
  8. µg/L = micrograms per liter

15 30





354 AREA SOLVENT DETECTIONS SITE

U.S. Army Fort Riley Home of the 1st Infantry Division

FORT RILEY, KANSAS

INJECTION CONFIGURATION

**FIGURE**