
WATER WELL R		WWC-5		sion of Water		MVV-6		
Original Record		ge in Well Use		urces App. No.		Well ID		
		Fraction	I	tion Number	Township Numb	per Range Number R 15 ■ E □ W		
2 WELL OWNER: Last Name: First: Business: Kansasland Tire - Gas For Less			Street or Rural Address where well is located (if unknown, distance and direction from nearest town or intersection): If at owner's address, check here:					
	Wanamaker Road			·				
Address: 28				2855 SW Wanamaker Road				
				Topeka, KS 66614				
3 LOCATE WELL	1 4 11 E E T L L L L L L L L L L L L L L L L L				ft. 5 Latitude: 39.015425(decimal degrees)			
WITH "X" IN SECTION BOX:	Double (a) Construction Engagement (b) 13							
N 2) N/A ft. 3) N/A ft., or 4) \square Dry \square				Well Horizontal Datum: ☐ WGS 84 ■ NAD 83 ☐ NAD 27				
WELL'S STATIC WATER LEVEL:				Source for Latitude/Longitude:				
	below land surface, measured on (mo-day-yr)6-6							
NW NE	VNE above land surface, measured on (mo-day-yr) Pump test data: Well water wasN/A ft.				(
w E	Ι Ι Ι Ι Ι ΝΙ/Δ ΝΙ/Δ				☐ Land Survey Topographic Map ☐ Online Mapper:			
	' Well water was N/A ft				Offine Wapper			
1 0 10	after. N/A hours pumping N/A gpm				000			
	Estimated Yield:N/Agpm				6 Elevation: 990			
	Bore Hole Diameter: 8.25 in. to 18.5 ft. and				Source: Land Survey GPS Topographic Map			
1 mile N/A in to N/A ft.								
7 WELL WATER TO BE USED AS: 1. Domestic: 5. □ Public Water Supply: well 1D								
Household				10. ☐ Oil Field Water Supply: lease				
Lawn & Garden	6. ☐ Dewatering: how many wells?			☐ Cased ☐ Uncased ☐ Geotechnical				
Livestock	8. Monitorir	W-6	12. Geothermal: how many bores?					
2. 🗌 Irrigation	Environment	tal Remediation: well I	D	a) Closed Loop				
3. Feedlot					b) Open Loop Surface Discharge Inj. of Water			
4. Industrial Recovery Injection 13. Other (specify):								
Was a chemical/bacteriological sample submitted to KDHE? Yes No If yes, date sample was submitted:								
Water well disinfected? ☐ Yes ■ No								
8 TYPE OF CASING USED: ☐ Steel ■ PVC ☐ Other CASING JOINTS: ☐ Glued ☐ Clamped ☐ Welded ■ Threaded								
Casing diameter 2 in to 8.5 ft., Diameter N/A in to N/A ft., Diameter N/A in to N/A ft. Casing height above land surface 0 in Weight N/A lbs/ft. Wall thickness or gauge No. Sch. 40								
TYPE OF SCREEN OR PERFORATION MATERIAL: Weight								
Steel Stainless Steel Fiberglass ■ PVC Other (Specify)								
☐ Brass ☐ Galvanized Steel ☐ Concrete tile ☐ None used (open hole)								
SCREEN OR PERFORATION OPENINGS ARE:								
☐ Continuous Slot ■ Mill Slot ☐ Gauze Wrapped ☐ Torch Cut ☐ Drilled Holes ☐ Other (Specify)								
☐ Louvered Shutter ☐ Key Punched ☐ Wire Wrapped ☐ Saw Cut ☐ None (Open Hole)								
SCREEN-PERFORATED INTERVALS: From .8.5								
GRAVEL PACK INTERVALS: From 6.5 ft. to 18.5 ft., From N/A ft. to N/A ft., From N/A ft. to N/A ft.								
9 GROUT MATERIAL: ☐ Neat coment ☐ Cement grout ■ Bentonite ■ Other Concrete 0 to 2								
Grout Intervals: From								
Nearest source of possible contamination: ☐ Septic Tank ☐ Livestock Pens ☐ Insecticide Storage								
□ Septic Tank □ Lateral Lines □ Pit Privy □ Livestock Pens □ Insecticide Storage □ Sewer Lines □ Cess Pool □ Sewage Lagoon ■ Fuel Storage □ Abandoned Water Well								
☐ Watertight Sewer Lines ☐ Seepage Pit ☐ Feedyard ☐ Fertilizer Storage ☐ Oil Well/Gas Well								
☐ Other (Specify) Direction from well? Southeast Distance from well? 240 ft.								
Direction from well? . 50	utneast	Distance from v	vell? .240					
10 FROM TO	LITHOLO	GIC ŁOG	FROM	TO L	ITHO, LOG (cont.) o	r PLUGGING INTERVALS		
	Fop soil/gravel	alaale n==!=#						
	Clay (CH) dark gray/b							
	Clay (CH) gray brown	i, saturated						
10.5	Sandstone (Refusal)		_					
			-					
			Notoss					
Notes:								
11 CONTRACTOR'S OR LANDOWNER'S CERTIFICATION: This water well was constructed, reconstructed, or plugged								
under my jurisdiction and was completed on (mo-day-year) 6-6-2018 and this record is true to the best of my knowledge and belief.								
Kansas Water Well Cor	ntractor's License No	759 This W	ater Well Rec	ord was comp	oleted on (mo-day-y	year) .7-8-2018		
under the business name	e of RAZEK Environ	mental LLC	Si	gnature	Mr. Jew!	V-1 CWTC 6		
Mail 1 white copy along with a fee of \$5.00 for each constructed well to: Kansas Department of Health and Environment, Bureau of Water, GWTS Section, 1000 SW lackson, St., Suite 420, Tepeka, Kansas 66612-1367. Mail one to Water Well Owner and retain one for your records. Telephone 785-296-5524.								
Visit us at http://www.kdhek		6 00012-136/. Mail one to	Water Well Owr KSA 82a-12		for your records. Telep	Revised 7/10/2015		
Tion us chintp.//www.kullek	s.gov/ water well/lildex.iitlill		135/1 024-12	1 4		ACTISCU //IV/2010		

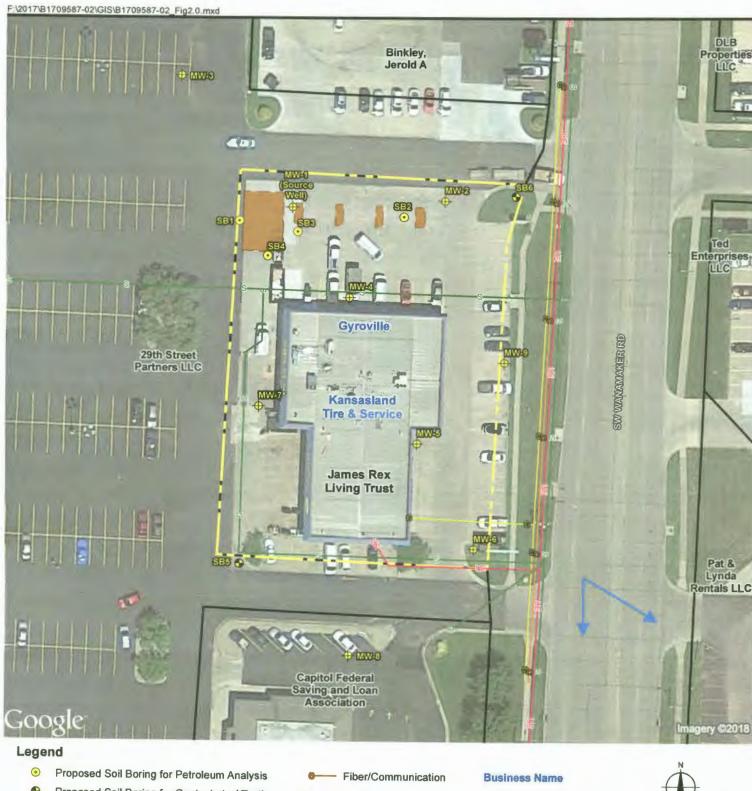

Proposed Soil Boring for Geotechnical Testing

Proposed Monitoring Well

Former UST Basin and Pump Island

Approximate Shawnee County Parcels

Approximate Site Boundary

Gas Line

Overhead/Electric

Sewer Line

Property Owner

Some Offsite utilities are unknown at this time



1 inch = 60 feet

BRAUN

The Science You Build On.

11001 Hampshire Avenue S Minnespolis, MN 55438 952.995.2000 braunintertee com Project No: B1709587,02

Drawing No: B1709587-02_Fig2.0

 Drawn By:
 CMF

 Date Drawn:
 3/5/2018

 Checked By:
 DR

 Last Modified:
 4/2/2018

Kansasland Tire - Gas For Less

Estimated Direction of Groundwater Flow

KDHE Project Code # U4-089-15027

2855 SW Wanamaker Road

Topeka, Kansas

Site Map

igure 2 0