
WATER WELL		m WWC-5	Div	ision of Water		MW	<i>I-</i> 7	
Original Record [ange in Well Use	Reso	urces App. No.		Well ID		
1 LOCATION OF V		Fraction		tion Number	Township Numb			
County: Shawne		1/4 SE 1/4 SE						
2 WELL OWNER:	Last Name:			(if unknown, distance an	_			
	and Tire - Gas For L V Wanamaker Road		direction from r	rection from nearest town or intersection): If at owner's address, check here:				
Address: 2000 SV	v vvanamaker Road		2855 SW W	855 SW Wanamaker Road				
City: Topeka State: KS ZIP: 66614 To				Topeka, KS 66614				
3 LOCATE WELL	4 DEPTH OF C				39.0156	34		
WITH "X" IN SECTION BOX: 4 DEPTH OF COMPLETED WELL: 24.5 ft. Depth(s) Groundwater Encountered: 1) 9.60 ft. Longitude: -95.763161 (decimal degree Longitude: -95.763161)								
SECTION BOA.							egrees)	
NN	WELL'S STATIC	WATER LEVEL:	ft.	Source for Latitude/Longitude:				
below land surface, measured on (mo-day-yr)). 6-6-2018. GPS (unit make/model:				
NW NE	IW NE above land surface, measured on (mo-day-yr)				······ (WAAS enabled? ☐ Yes ☐ No)			
	Pump test data: Well water was				☐ Land Survey ■ Topographic Map			
W	afterW.A h	ours pumping '	gpm	n Online Mapper:				
w after N/A hours pumping N/A gpm Online Mapper: Well water was								
L X	Estimated Vield: N/A gram					. 🔳 Ground Level 🔲		
S					Source: ☐ Land Survey ☐ GPS ■ Topographic Map			
mile		N/A in. toN/A	ft.		Other			
7 WELL WATER T								
1. Domestic:		Water Supply: well ID		10. ☐ Oil Fi	ield Water Supply: 1	ease		
☐ Household ☐ Lawn & Garden	6. ☐ Dewat	ering: how many wells?			e: well ID			
Livestock					Cased Uncased Geotechnical			
2. ☐ Irrigation 9. Environmental Remediation: well ID.				a) Closed Loop Horizontal Vertical				
3. Feedlot	☐ Air Sp					scharge Inj. of Wa	ater	
4. 🗌 Industrial	☐ Recov			13. ☐ Other	(specify):			
Was a chemical/bacteriological sample submitted to KDHE? ☐ Yes ■ No If yes, date sample was submitted:								
Water well disinfected? Yes No								
8 TYPE OF CASING	G USED: ☐ Steel ■	PVC Other	CASIN	NG JOINTS: E	Glued Clampe	Welded Thre	aded	
Casing diameter 2 in. to 14.5 ft., Diameter N/A in. to N/A ft., Diameter N/A in. to N/A ft. Casing height above land surface 0 in. Weight N/A lbs./ft. Wall thickness or gauge No. Sch. 40								
Casing height above land surface								
TYPE OF SCREEN OR PERFORATION MATERIAL:								
☐ Steel ☐ Stainless Steel ☐ Fiberglass ☐ PVC ☐ Other (Specify)								
☐ Brass ☐ Galvanized Steel ☐ Concrete tile ☐ None used (open hole) SCREEN OR PERFORATION OPENINGS ARE:								
☐ Continuous Slot ■ Mill Slot ☐ Gauze Wrapped ☐ Torch Cut ☐ Drilled Holes ☐ Other (Specify)								
Louvered Shutter								
SCREEN-PERFORATED INTERVALS: From .14.5 ft. to .24.5 ft., From .N/A ft. to .N/A ft., From .N/A ft. to .N/A ft.								
GRAVEL PACK INTERVALS: From12.5. ft. to24.5. ft., FromN/Aft. toN/Aft. toN/Aft. toN/Aft.								
9 GROUT MATERIAL: Neat cement Cement grout Bentonite Other Concrete 0 to 2								
Grout Intervals: From								
Nearest source of possi								
☐ Septic Tank ☐ Sewer Lines	☐ Lateral I ☐ Cess Po			Livestock Pens		eide Storage		
☐ Sewer Lines ☐ Cess Pool ☐ Sewage Lagoon ☐ Fuel Storage ☐ Abandoned Water Well ☐ Watertight Sewer Lines ☐ Seepage Pit ☐ Feedyard ☐ Fertilizer Storage ☐ Oil Well/Gas Well								
Other (Specify)								
Direction from well? . N		Distance from	well? .115		ft			
10 FROM TO	LITHO	OGIC LOG	FROM			PLUGGING INTERV	VALS	
0 0.5	Concrete							
0.5	Clay (CH) dark bro							
11 16	Clay (CH) orange I							
16 18	Clay (CH) brown, r							
18 20		ne sandstone gravel						
20 24.5	Clay (CH) brown, r							
24.5	Sandstone (Refusa	al)	Notes:					
11 CONTRACTORS OR LANDOWNERS CERTIFICATION TO								
11 CONTRACTOR'S OR LANDOWNER'S CERTIFICATION: This water well was constructed, reconstructed, or plugged under my jurisdiction and was completed on (mo-day-year) .6-5-2018 and this record is true to the best of my knowledge and belief.								
Kansas Water Well Contractor's License No. 759 This Water Well Record was completed on (mo-day-year) 7-8-2018								
under the business name of RAZEK Environmental LLC. Signature								
Mail I white copy along with a fee of \$5.00 for each constructed well to Kansas Department of Health and Environment, Bureau of Water, GWTS Section, 1000 SW Jackson, St., Swite 420, Vopeka, Kansas 66612-1367. Mail one to Water Well Owner and retain one for your records. Telephone 785-296-5524.								
					or your records. Teleph	none 785-296-5524. Revised 7/10/20 1	15	
Visit us at http://www.kdhe	ks.gov/waterwell/index.htr	111	KSA 82a-12	14		Reviseu //10/20	1.0	

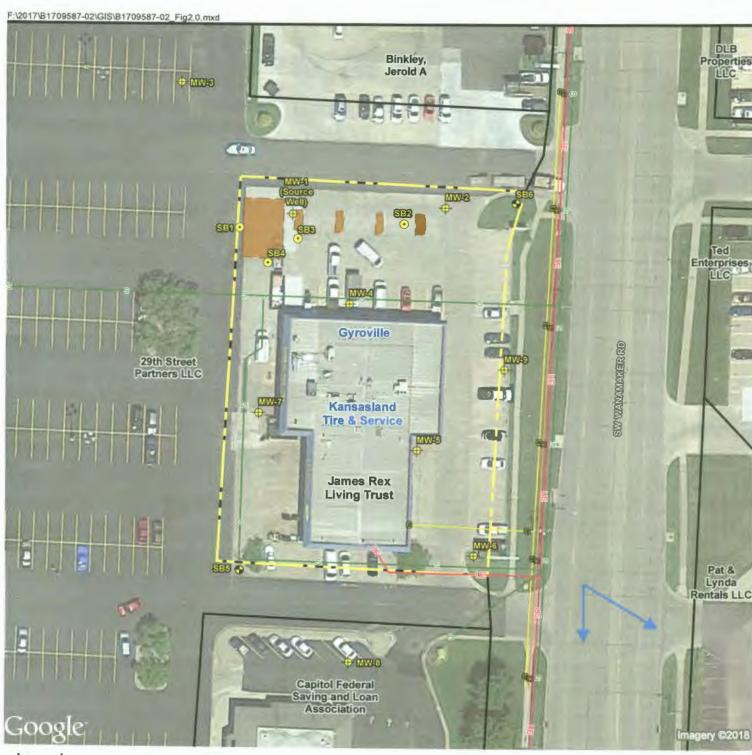

Legend

Proposed Soil Boring for Petroleum Analysis

Proposed Soil Boring for Geotechnical Testing

Proposed Monitoring Well

Former UST Basin and Pump Island

Approximate Shawnee County Parcels

Approximate Site Boundary

Fiber/Communication

Gas Line

Overhead/Electric

Sewer Line

Business Name

Property Owner

Some Offsite utilities are unknown at this time



1 inch = 60 feet

BRAUN

The Coloner Very D. 24 O.

11001 Hampshire Avenue S Minneapolis, MN 55438 952,995,2000 braunintertec.com Project No: B1709587.02

Drawing No: B1709587-02_Fig2.0

 Drawn By:
 CMF

 Date Drawn:
 3/5/2018

 Checked By:
 DR

 Last Modified:
 4/2/2018

Kansasland Tire - Gas For Less

Estimated Direction of Groundwater Flow

KDHE Project Code # U4-089-15027

2855 SW Wanamaker Road

Topeka, Kansas

Site Map

Figure 2.0