

WATER WELL RECORD

Form WWC-5

Division of Water Resources App. No.

Well ID

MW3

Original Record Correction Change in Well Use

1 LOCATION OF WATER WELL: Fraction Section Number Township Number Range Number

2 WELL OWNER: Last Name: Business: Address: City: State: ZIP: Street or Rural Address where well is located

3 LOCATE WELL WITH "X" IN SECTION BOX: 4 DEPTH OF COMPLETED WELL: 5 Latitude: Longitude: Elevation: Source

7 WELL WATER TO BE USED AS: 1 Domestic: 2 Irrigation: 3 Feedlot: 4 Industrial: 5 Public Water Supply: 6 Dewatering: 7 Aquifer Recharge: 8 Monitoring: 9 Environmental Remediation: 10 Oil Field Water Supply: 11 Test Hole: 12 Geothermal:

Was a chemical/bacteriological sample submitted to KDHE? Water well disinfected?

8 TYPE OF CASING USED: CASING JOINTS: TYPE OF SCREEN OR PERFORATION MATERIAL: SCREEN OR PERFORATION OPENINGS ARE: SCREEN-PERFORATED INTERVALS: GRAVEL PACK INTERVALS:

9 GROUT MATERIAL: Grout intervals:

Nearest source of possible contamination: Direction from well? Distance from well?

Table with 6 columns: FROM, TO, LITHOLOGIC LOG, FROM, TO, LITHO. LOG (cont.) or PLUGGING INTERVALS

Notes: KDHE ID: K-Mart #3236; U4-089-00090 Target of monitoring well is shallow groundwater.

11 CONTRACTOR'S OR LANDOWNER'S CERTIFICATION: This water well was constructed/reconstructed/plugged under my jurisdiction...

STRAWNE E

NW 35

1-12-10E

# DENNIS L HANDKE

1820 NW 59th Terrace  
TOPEKA, KANSAS 66618  
785-286-4047 Home  
785-286-1990 Fax

Jessica Chapman  
Larsen & Associates  
1311 E. 25<sup>th</sup> Street, Suite B  
Lawrence, Kansas, 66046

April 28, 2018

RE: Monitor Well Elevation Survey  
240 E. 29<sup>th</sup> St., Topeka, Kansas

Proj. 18-00M  
K-Mart #3236  
U4-089-00090

Bench Mark: Chisled Sq. on concrete sidewalk at Southeast corner of building.  
Elev: 948.12      North 472      West 1489      (from SE Cor. Sec. 7-12-16E)

MW-1	rim	947.33	North	524	NE1/4,SE1/4,SW1/4,SE1/4
	top pipe	946.84	West	1479	Lat= 39.01674 Long = 95.67542
MW-2	rim	947.15	North	574	NE1/4,SE1/4,SW1/4,SE1/4
	top pipe	946.71	West	1445	Lat= 39.01687 Long = 95.67529
MW-3	rim	948.65	North	496	NE1/4,SE1/4,SW1/4,SE1/4
	top pipe	948.09	West	1409	Lat= 39.01666 Long = 95.67517
MW-4	rim	947.48	North	700	SE1/4,NE1/4,SW1/4,SE1/4
	top pipe	947.18	West	1582	Lat= 39.01723 Long = 95.67577
MW-5	rim	946.55	North	422	NE1/4,SE1/4,SW1/4,SE1/4
	top pipe	946.19	West	1496	Lat= 39.01646 Long = 95.67548

Lat & Long derived existing Topeka 7.5' quad map. WGS 84.

Elevation established from City of Topeka BM #9 NAVD 27.

If you have any questions, please feel free to call me. Thank you for the opportunity to be of service to you.

Dennis L Handke R.L.S.  
 LS-786  
 KANSAS SURVEYOR

RECEIVED  
 MAY 12 2018  
 BUREAU OF WATER

SHAWNEE

NOTE: Figures exhibited within this report are only to be used within the context of this report. Placement of property lines, wells, structures, and roads is based on the available information from county appraiser maps, surveys, site visits, and/or previous vendor reports and should be considered approximate.

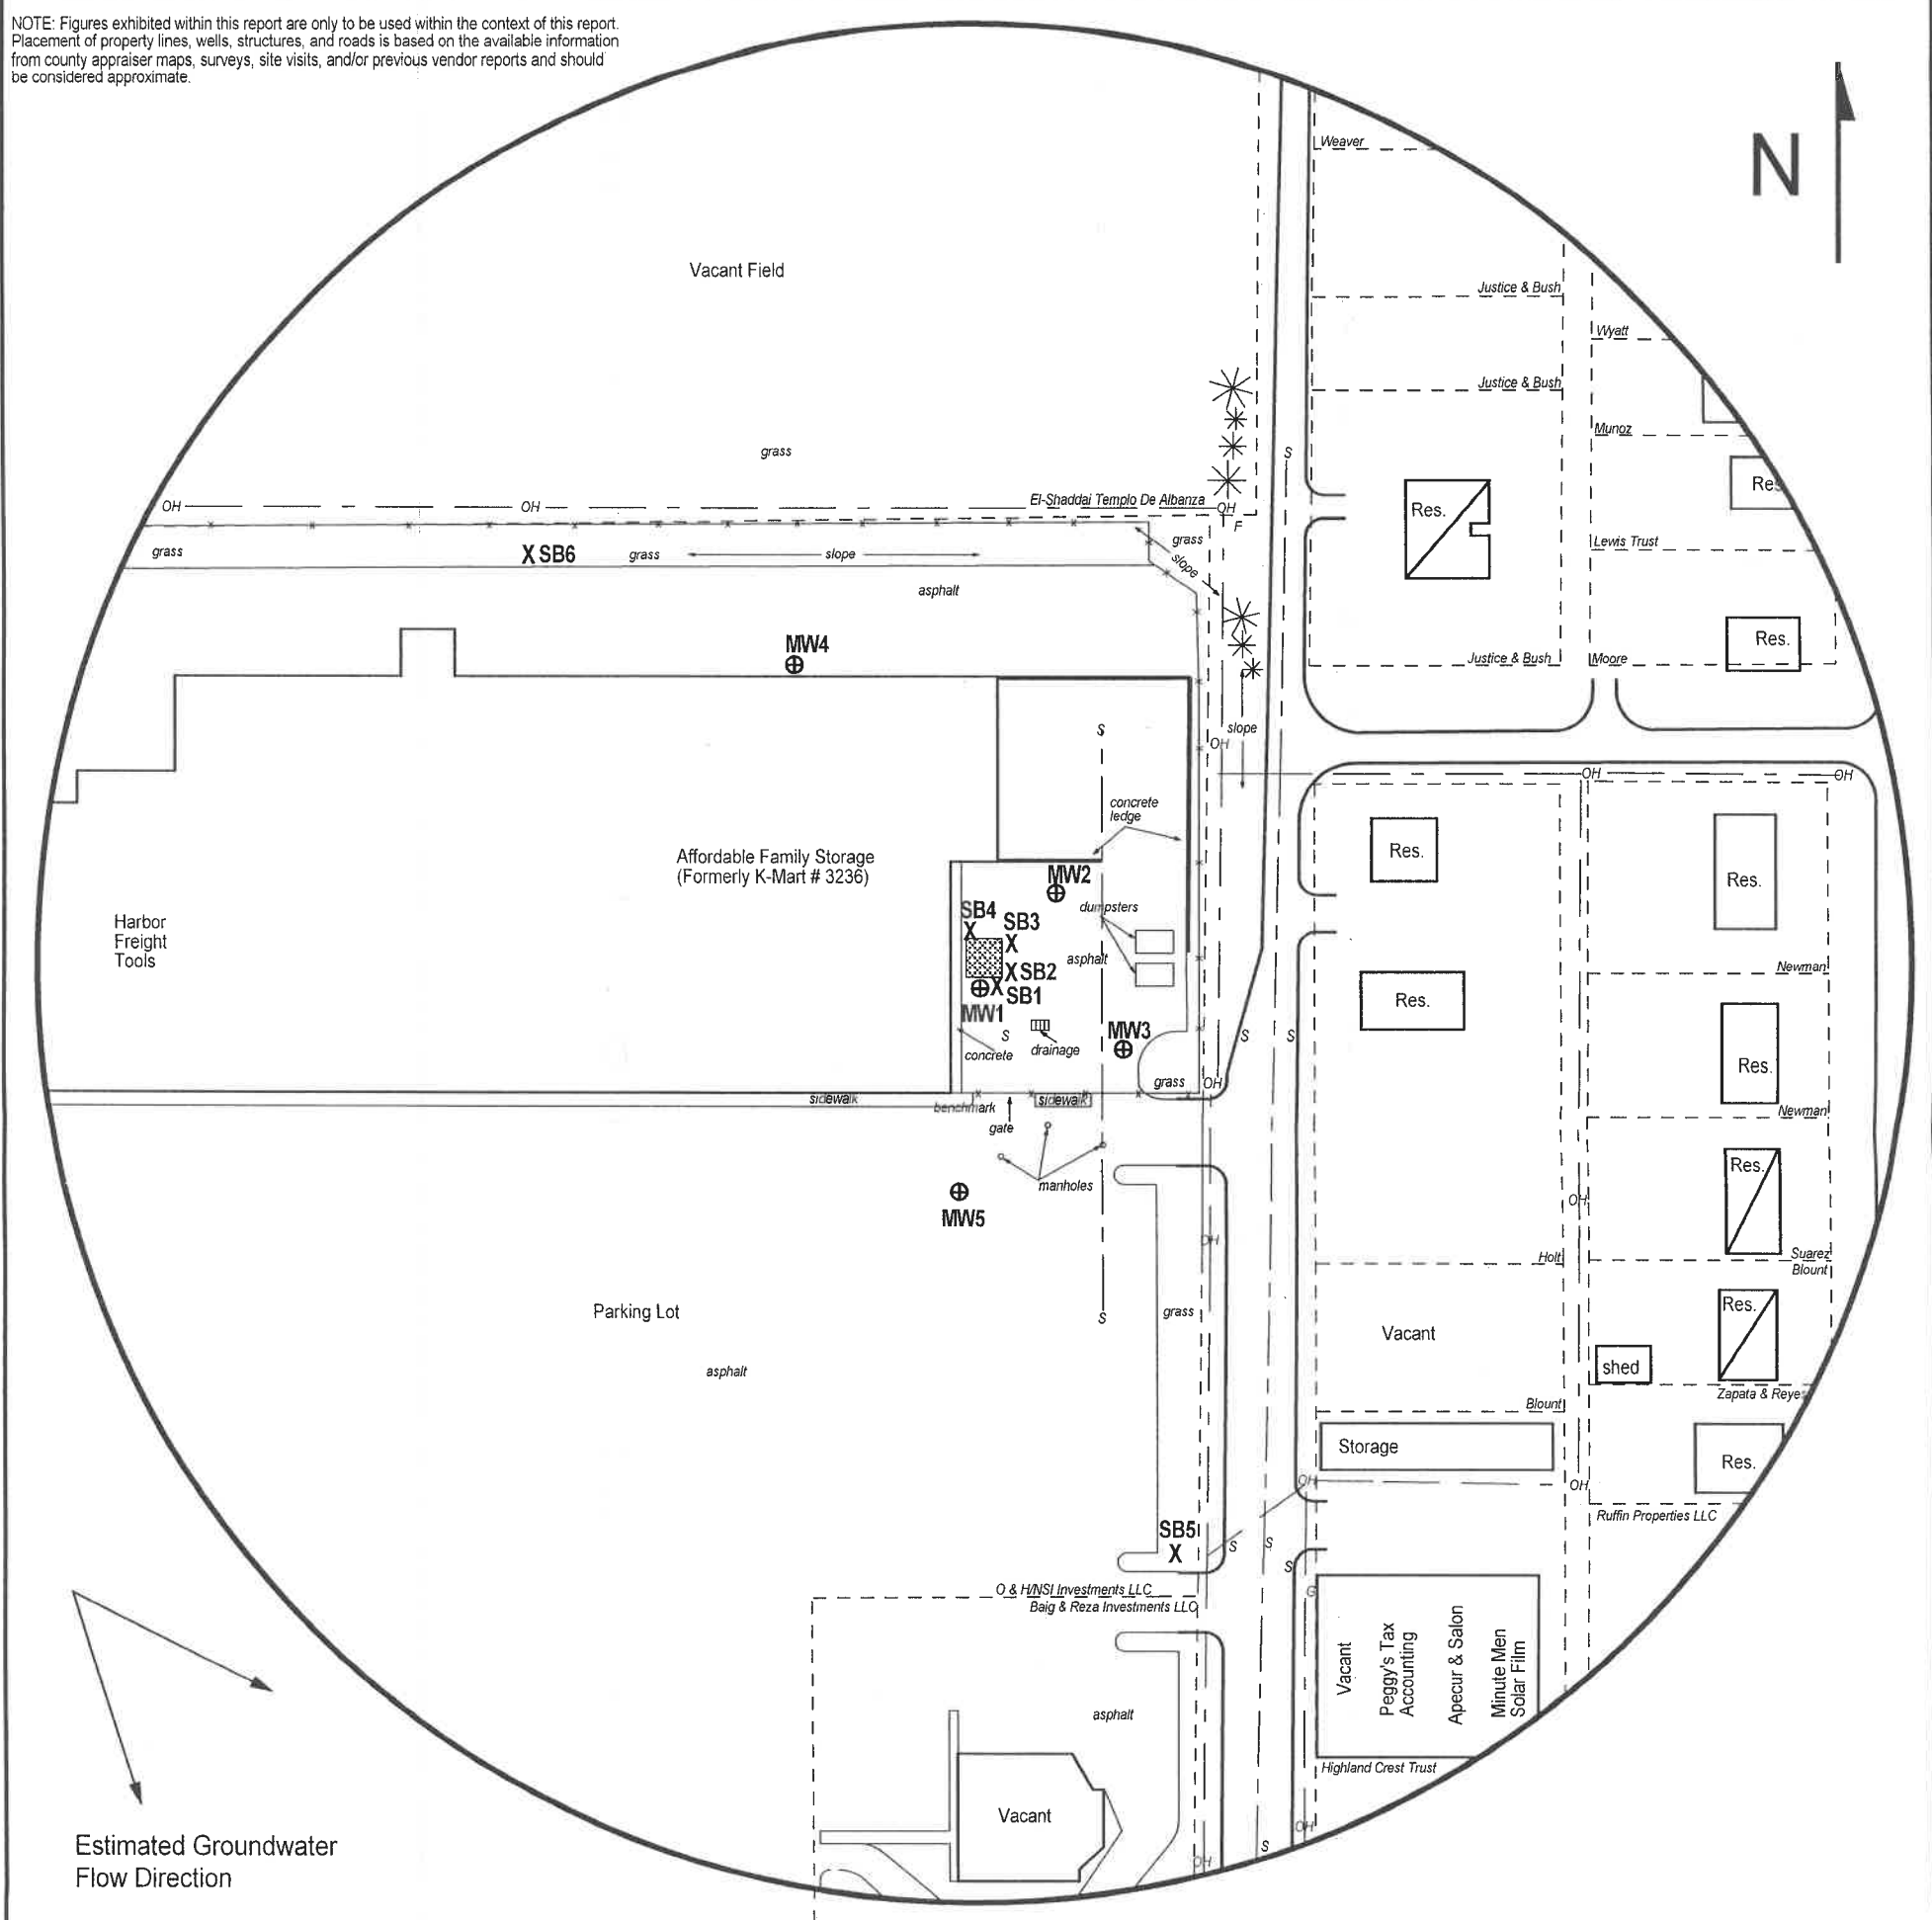


FIGURE 2.2 - 500 FT RADIUS AREA BASE MAP


LEGEND:

- Approximate Location of Former Used Oil UST
- Building with Basement
- Approximate Location of Property Line
- Monitoring Well (Installed 4/4/18)
- Soil Boring (Drilled 3/27/18)
- Overhead Lines (25-40 ft high)
- Sanitary Sewer (2 - 6 ft BGS)

NOTE: SB5 & SB6 were drilled to collect hydrologic samples.  
NOTE: Utility depths, heights and locations are approximate.



PROJECT:  
K-Mart #3236  
240 SE. 29th St.  
Topeka, KS  
KDHE ID: U4-089-00090  
Date: 4/10/18

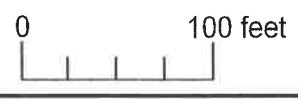

1311 E 25th St., Suite B (785) 841-8707 office  
Lawrence, KS 66046 (785) 865-4282 fax

RECEIVED  
MAY 12 2018  
BUREAU OF WATER

SW SE

7-12-16E