WATER WELL RE X Original Record	Division of Water Resources App. No. Well ID MW15				MW15					
1 LOCATION OF County Shawnee	WATER WELL:	Fraction SE ¼ SW ¼	SW 1/4 SE 1/4		Township Nun		Number 6 X E W			
2 WELL OWNER: Business: KDHE (I Address: 1000 SW Address: City T	Former Sinclair) / Jackson opeka State: KS	First: S ZIP: 66612	Street or Rural Address where well is located (if unknown, distance and direction from nearest town or intersection): If at owner's address, check here: 400 SE 29th St, Topeka, KS 66605							
3 LOCATE WELL WITH "X" IN SECTION BOX: N NW NE W SW SE SE I mile T WELL WATER T	Depth(s) Ground 2) WELL'S STATI X below la above la Pump test dat after after Estimated Yie Bore Hole Dia	of COMPLETED WELL: dwater Encountered: 1) ft 3) ft, or 4) C WATER LEVEL: 6 and surface, measured on (mo-cond surface, measured	ft Dry Well 95 ft. lay-yr) lay-yr) ft gpm ft gpm ft ft, and	GPS (u (WA X Land S Online 6 Elevation Source X	Datum: WGS Latitude/Longitude nit make/model: AAS enabled? Urvey Topog Mapper	GG3 (de 84 NAD : N	evel X TOC Topographic Map			
Domestic: Household Lawn & Garden Livestock Irrigation Feedlot Industrial	5 Public W 6 Dewateri 7 Aquifer F 8 X Monitorii		1	Test Hole: well	Uncased w many bores? Horizontal Surface D	Geotechnic	nl Inj. of Water			
Was a chemical/bacteriological sample submitted to KDHE? Yes X No If yes, date sample was submitted: Water well disinfected? Yes X No										
8 TYPE OF CASING USED: Steel X PVC Other CASING JOINTS: Glued Clampled Welded X Threaded Casing diameter 2 in. to 5 ft, Diameter in. to ft, From ft. to ft. The first Park Fi										
9 GROUT MATERIAL Grout intervals: From	: Neat cement	Cement grout X Ber	ntonite X Other	Concrete: 0-0.5						
Nearest source of possible Septic Tank Sewer Lines Watertight Sewer L Other (Specity) Direction from well? SW	ole contamination: Lateral Li Cess Pool	Sewage Lagor	Lives X Fuel Fertil	nft. t tock Pens Storage izer Storage	Insecticide	d Water Well				
10 FROM TO 0.5		OLOGIC LOG	FROM	ТО	LITHO. LOG (cor	nt.) or PLUGGIN	G INTERVALS			
0.5 5	Asphalt Clay									
5 9 9 11	Shale Shale, limestone layers									
11 12 12 12.3	Limestone									
12.3 14.5	Limestone	Shale Limestone Notes: KDHE ID: Former Sinclair; U4-089-15033								
14.5 15	14.5 15 Shale Target of monitoring well is shallow groundwater, <20' of grout was installed at									
the direction of KDHE. CONTRACTOR'S OR LANDOWNER'S CERTIFICATION: This water well was X constructed, or plueged under my jurisdiction and was completed on (mo-day-year) 1/28/20 and this record is true to the best of my knowledge and belief. Kansas Water Wolf Contractor's License No 757 This Water Well Record was completed on (mo-day-year) 2/11/20 under the business name of Larsen & Associates, Inc. Mail I white copy along with a fee of \$5.00 for each constructed well to: Kansas Department of Health and Environment, Bureau & Water GWS Section,										
1000 SW	Jackson St., Suite 420, Topek	n, Kansas 66612-1367. Mail one to	Water Well Owner and			785-296-5524.	`&			
Visit us at http://www.l	dheks.gov/waterwell/index.htt	nl KSA 82	2a-1212			Revised	7/10/2015			

DENNIS L HANDKE

1820 NW 59th Terrace TOPEKA, KANSAS 66618 785-286-4047 Home 785-286-1990 Fax

Jessica Chapman Larsen & Associates 1311 E. 25th Street, Suite B Lawrence, Kansas, 66046

February 8, 2020

RE: Monitor Well Elevation Survey 311 SE 29th St., Topeka, Kansas

Proj. 20-00G Former Sinclair U4-089-15033

Bench Mark: Chisled Sq. on SE corner of concrete signal light base at Northwest corner of property.

Elev: 941.80

North 5214

West 1263


(from SE Cor. Sec. 18-12-16E)

MW-14	rim	957.72	North	5530	SE1/4,SW1/4,SW1/4,SE1/4 (Sec. 7-12-16E)
	top pipe	957.42	West	971	Lat= 39.01592 Long = 95.67364
MW-15	rim	954.99	North	5385	SE1/4,SW1/4,SW1/4,SE1/4 (Sec. 7-12-16E)
	top pipe	954.63	West	964	Lat= 39.01552 Long = 95.67363

Lat & Long derived from Topeka 7.5' quad map. WGS 84.

Elevation established from existing project.

If you have any questions, please feel free to call me. Thank you for the opportunity to be of service to you!

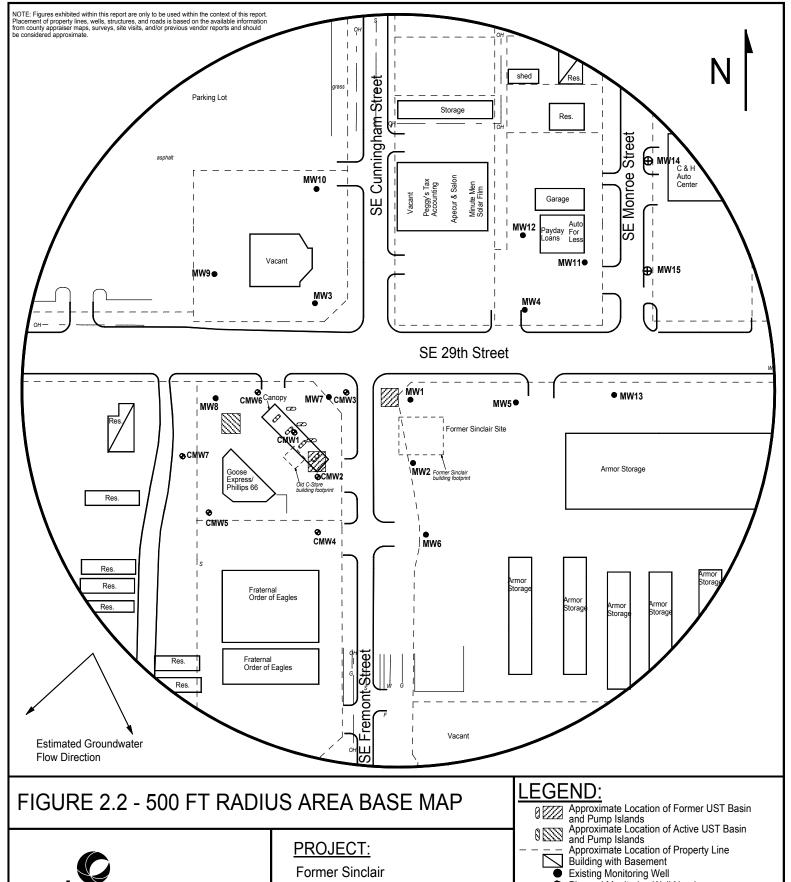



ASSOCIATES, INC.

1311 E 25th St., Suite B Lawrence, KS 66046

(785) 841-8707 office (785) 865-4282 fax

Former Sinclair 311 SE 29th Street Topeka, KS KDHE ID: U4-089-15033 Date: 10/26/18

100 feet

- Plugged Monitoring Well Nearby Site Clark #1345 (U4-089-1605)
- Proposed Monitoring Well

Fire Hydrant

Electric Lines (2 - 6 ft BGS) Gas Lines (2 - 6 ft BGS) Overhead Lines (25-40 ft high) Sewer Lines (2 - 6 ft BGS)

NOTE: Utility depths, heights and locations are approximate