

Shawnee

31-11-16E



Legend

- = Proposed Well
 - = Proposed Soil Boring
 - = Monitoring Well
 - = Destroyed Well
 - = Easement
 - = Parcel
 - = Building Footprint
 - = Grassy Area
 - = Former UST
 - = Former Pump Island
 - = Electric Line
 - = Gas Line
 - = Sewer Line
 - = Water Line
 - = Fiber Optic Line
 - = Power Pole
 - = Trees
- *Estimated buried utilities depth >= 4 ft bgs




FIGURE: 3.0	FIGURE NAME: Aerial Photo
DATE: 01/07/2022	PROJECT NUMBER: 2174145
DRAWN BY: HS	PROJECT MANAGER: RE

Montgomery Ward & Co., Inc.
 320 Kansas Avenue
 Topeka, Kansas
 KDEE #U4-089-00772



ALL LOCATIONS AND BOUNDARIES ARE APPROXIMATE

31-11-166

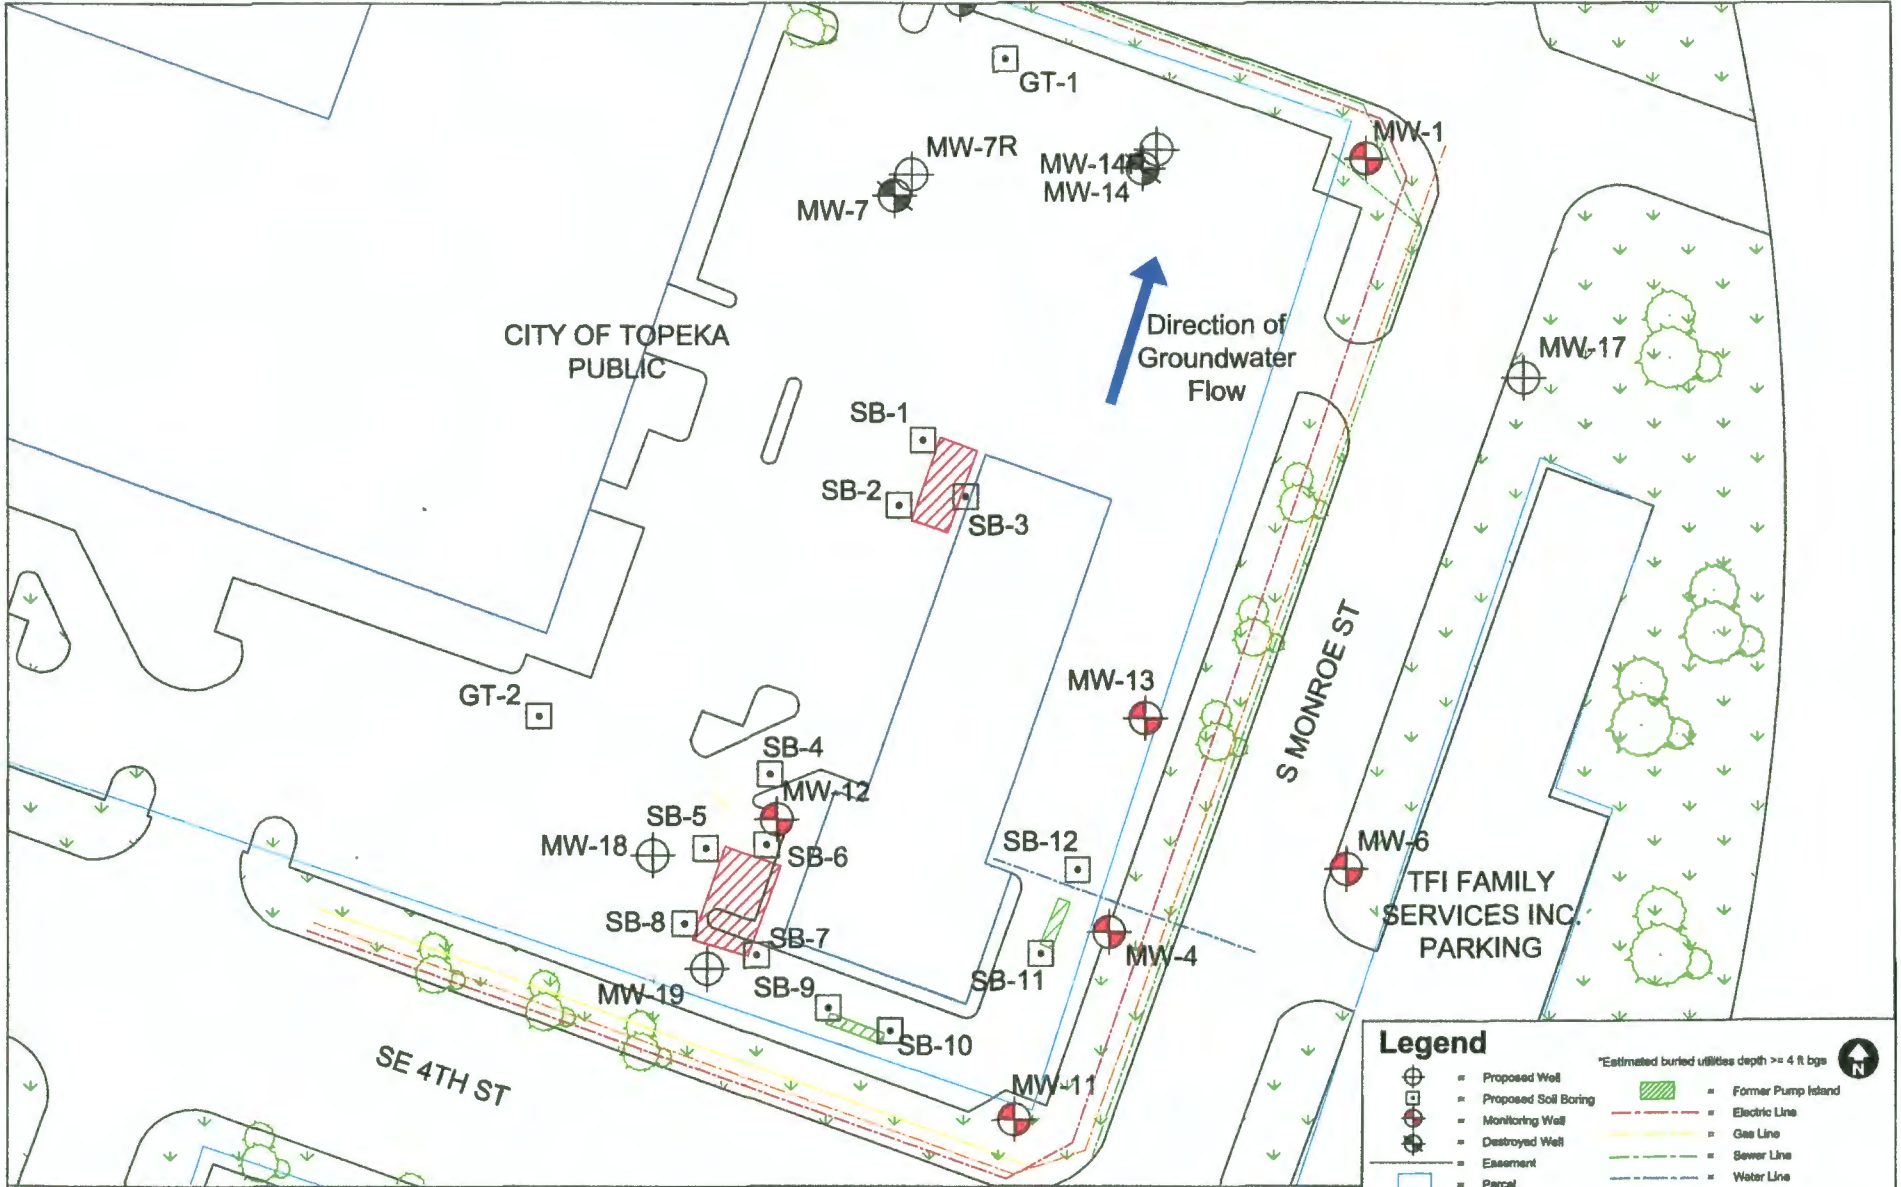

Legend

	= Proposed Well		= Former Pump Island
	= Proposed Soil Boring		= Electric Line
	= Monitoring Well		= Gas Line
	= Destroyed Well		= Sewer Line
	= Easement		= Water Line
	= Parcel		= Fiber Optic Line
	= Building Footprint		= Power Pole
	= Grassy Area		= Trees
	= Former UST		

*Estimated buried utilities depth >= 4 ft bgs


ALL LOCATIONS AND BOUNDARIES ARE APPROXIMATE



FIGURE: 2.0
 DATE: 01/07/2022
 DRAWN BY: HS

FIGURE NAME: Site Map - Scale 1"=50'
 PROJECT NUMBER: 2174145
 PROJECT MANAGER: RE

Montgomery ward & Co., Inc.
 320 Kansas Avenue
 Topeka, Kansas
 KDHE #U4-089-00772

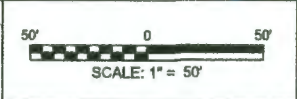

WATER WELL RECORD Form WWC-5


Original Record Correction Change in Well Use

Division of Water Resources App. No.

Well ID MW-18

1 LOCATION OF WATER WELL: County: Shawnee	Fraction NE ¼ NE ¼ SE ¼ NE ¼	Section Number 31	Township Number T 11 S	Range Number R 16 <input checked="" type="checkbox"/> E <input type="checkbox"/> W
--	--	-----------------------------	----------------------------------	--

2 WELL OWNER: Last Name: Business: KDHE Address: 1000 SW Jackson St Address: City: Topeka State: KS ZIP:	First: Street or Rural Address where well is located (if unknown, distance and direction from nearest town or intersection): If at owner's address, check here: <input type="checkbox"/> Approx. 200' W. + 75' N. of intersection of SE 4th St. + S. Munroe St.	
--	---	--

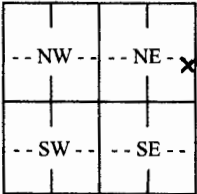3 LOCATE WELL WITH "X" IN SECTION BOX: N  W E S -----1 mile-----	4 DEPTH OF COMPLETED WELL: 25.0 ft. Depth(s) Groundwater Encountered: 1) 23.21 ft. 2) ft. 3) ft., or 4) <input type="checkbox"/> Dry Well WELL'S STATIC WATER LEVEL: ft. <input type="checkbox"/> below land surface, measured on (mo-day-yr)..... <input type="checkbox"/> above land surface, measured on (mo-day-yr)..... Pump test data: Well water was ft. after..... hours pumping gpm Well water was ft. after..... hours pumping gpm Estimated Yield: gpm Bore Hole Diameter: 8.75 in. to 25.0 ft. and in. to ft.	5 Latitude: 37.05439 (decimal degrees) Longitude: -95.66990 (decimal degrees) Horizontal Datum: <input checked="" type="checkbox"/> WGS 84 <input type="checkbox"/> NAD 83 <input type="checkbox"/> NAD 27 Source for Latitude/Longitude: <input type="checkbox"/> GPS (unit make/model:) (WAAS enabled? <input type="checkbox"/> Yes <input type="checkbox"/> No) <input checked="" type="checkbox"/> Land Survey <input type="checkbox"/> Topographic Map <input type="checkbox"/> Online Mapper:
		6 Elevation: 898.77 ft. <input type="checkbox"/> Ground Level <input checked="" type="checkbox"/> TOC Source: <input checked="" type="checkbox"/> Land Survey <input type="checkbox"/> GPS <input type="checkbox"/> Topographic Map <input type="checkbox"/> Other

7 WELL WATER TO BE USED AS:

1. Domestic: <input type="checkbox"/> Household <input type="checkbox"/> Lawn & Garden <input type="checkbox"/> Livestock 2. <input type="checkbox"/> Irrigation 3. <input type="checkbox"/> Feedlot 4. <input type="checkbox"/> Industrial	5. <input type="checkbox"/> Public Water Supply: well ID 6. <input type="checkbox"/> Dewatering: how many wells? 7. <input type="checkbox"/> Aquifer Recharge: well ID 8. <input type="checkbox"/> Monitoring: well ID MW-18 9. Environmental Remediation: well ID <input type="checkbox"/> Air Sparge <input type="checkbox"/> Soil Vapor Extraction <input type="checkbox"/> Recovery <input type="checkbox"/> Injection	10. <input type="checkbox"/> Oil Field Water Supply: lease 11. Test Hole: well ID <input type="checkbox"/> Cased <input type="checkbox"/> Uncased <input type="checkbox"/> Geotechnical 12. Geothermal: how many bores? a) Closed Loop <input type="checkbox"/> Horizontal <input type="checkbox"/> Vertical b) Open Loop <input type="checkbox"/> Surface Discharge <input type="checkbox"/> Inj. of Water 13. <input type="checkbox"/> Other (specify):
---	---	---

Was a chemical/bacteriological sample submitted to KDHE? Yes No If yes, date sample was submitted:

Water well disinfected? Yes No

8 TYPE OF CASING USED: Steel PVC Other CASING JOINTS: Glued Clamped Welded Threaded
 Casing diameter **2** in. to **25.0** ft., Diameter in. to ft., Diameter in. to ft.
 Casing height above land surface **0** in. Weight lbs./ft. Wall thickness or gauge No. **sch 40**

TYPE OF SCREEN OR PERFORATION MATERIAL:
 Steel Stainless Steel Fiberglass PVC Other (Specify)
 Brass Galvanized Steel Concrete tile None used (open hole)

SCREEN OR PERFORATION OPENINGS ARE:
 Continuous Slot Mill Slot Gauze Wrapped Torch Cut Drilled Holes Other (Specify)
 Louvered Shutter Key Punched Wire Wrapped Saw Cut None (Open Hole)

SCREEN-PERFORATED INTERVALS: From **15.0** ft. to **25.0** ft., From ft. to ft., From ft. to ft.
GRAVEL PACK INTERVALS: From **13.0** ft. to **25.0** ft., From ft. to ft., From ft. to ft.

9 GROUT MATERIAL: Neat cement Cement grout Bentonite Other
 Grout Intervals: From **1** ft. to **13.0** ft., From **0** ft. to **1** ft., From ft. to ft.

Nearest source of possible contamination:
 Septic Tank Lateral Lines Pit Privy Livestock Pens Insecticide Storage
 Sewer Lines Cess Pool Sewage Lagoon Fuel Storage Abandoned Water Well
 Watertight Sewer Lines Seepage Pit Feedyard Fertilizer Storage Oil Well/Gas Well
 Other (Specify) **Contaminated Site**

Direction from well? Distance from well? ft.

10 FROM	TO	LITHOLOGIC LOG	FROM	TO	LITHO. LOG (cont.) or PLUGGING INTERVALS
0	0.5	Asphalt			
0.5	5	Silty Clay, black, damp, petroleum odor			
5	8	Clay, black, moist, silty, petroleum odor			
8	10	Silty Clay, gray, moist, petroleum odor			
10	15	Silty Clay, gray, damp, plastic, strong petroleum odor			
15	20	Silty Clay, gray-brown, moist, petroleum odor			Notes:
20	25	Sandy Clay, light brown, moist			

11 CONTRACTOR'S OR LANDOWNER'S CERTIFICATION: This water well was constructed, reconstructed, or plugged under my jurisdiction and was completed on (mo-day-year) **2-1-2022** and this record is true to the best of my knowledge and belief. Kansas Water Well Contractor's License No. **604** This Water Well Record was completed on (mo-day-year) **3/24/22** under the business name of **Environmental Priority Service, Inc.** Signature **P. H. J.**

31-11-16E

DENNIS L HANDKE

1820 NW 59th Terrace
TOPEKA, KANSAS 66618
785-286-4047 Home

Kelse Wheeler
GSI
4503 E. 47th Street
Wichita, Kansas, 67210

February 17, 2022

RE: Monitor Well Elevation Survey
320 SE Kansas, Topeka, Kansas

Proj. 22-00L
Montgomery Ward Co. Inc.
KDHE ID U4-089-00772

Bench Mark: Chisled Square on North center of concrete storm inlet on South side of 3rd St. & West of Monroe Street.

Elev: 888.04 North 3991.28 East 99.21 (from SE Cor. Sec. 31-11-16E)

✓ MW-7R	rim	892.38	North	3952.46	NE1/4,NE1/4,SE1/4,NE1/4
	top pipe	891.89	West	86.91	Lat= 37.05506 Long = 95.66954
✓ MW-14R	rim	890.81	North	3952.48	NW1/4,NW1/4,SW1/4,NW1/4 (Sec. 6-12-16E)
	top pipe	890.26	East	17.39	Lat= 37.05506 Long = 95.66917
✓ MW-17	rim	890.27	North	3881.50	NW1/4,NW1/4,SW1/4,NW1/4 (Sec. 6-12-16E)
	top pipe	889.51	East	167.38	Lat= 37.05487 Long = 95.66864
✓ MW-18	rim	899.24	North	3706.02	NE1/4,NE1/4,SE1/4,NE1/4
	top pipe	898.77	West	187.82	Lat= 37.05439 Long = 95.66990
✓ MW-19	rim	899.55	North	3627.60	SE1/4,NE1/4,SE1/4,NE1/4
	top pipe	898.73	West	171.75	Lat= 37.05417 Long = 95.66984

Lat & Long derived from Topeka 7.5' quad map. WGS 84.

Elevation established from existing proj. NAVD 88

If you have any questions, please feel free to call me. Thank you for the opportunity to be of service.

Dennis L Handke RLS

