

WATER WELL RECORD Form WWC-5

Original Record Correction Change in Well Use

Division of Water Resources App. No.


Well ID

1 LOCATION OF WATER WELL:

Fraction Section Number Township Number Range Number

2 WELL OWNER: Last Name: Business: Address: City: State: ZIP: Street or Rural Address where well is located

3 LOCATE WELL WITH 'X' IN SECTION BOX:

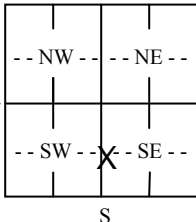

4 DEPTH OF COMPLETED WELL:

Depth(s) Groundwater Encountered: 1) ... ft. 2) ... ft. 3) ... ft., or 4) Dry Well

5 Latitude: (decimal degrees)

Longitude: (decimal degrees) Datum: WGS 84 NAD 83 NAD 27 Source for Latitude/Longitude: GPS Land Survey Topographic Map Online Mapper

6 Elevation: ft. Ground Level TOC

Source: Land Survey GPS Topographic Map Other

7 WELL WATER TO BE USED AS:

- 1. Domestic: Household Lawn & Garden Livestock Irrigation Feedlot Industrial
5. Public Water Supply: well ID
6. Dewatering: how many wells?
7. Aquifer Recharge: well ID
8. Monitoring: well ID
9. Environmental Remediation: well ID
10. Oil Field Water Supply: lease
11. Test Hole: well ID
12. Geothermal: how many bores?
13. Other (specify):

Was a chemical/bacteriological sample submitted to KDHE? Yes No If yes, date sample was submitted: Water well disinfected? Yes No

8 TYPE OF CASING USED: Steel PVC Other CASING JOINTS: Glued Clamped Welded Threaded

Casing diameter in. to ft., Diameter in. to ft., Diameter in. to ft. Casing height above land surface in. Weight lbs./ft. Wall thickness or gauge No.

TYPE OF SCREEN OR PERFORATION MATERIAL: Steel Stainless Steel Fiberglass PVC Other (Specify) Brass Galvanized Steel Concrete tile None used (open hole)

SCREEN OR PERFORATION OPENINGS ARE: Continuous Slot Mill Slot Gauze Wrapped Torch Cut Drilled Holes Other (Specify) Louvered Shutter Key Punched Wire Wrapped Saw Cut None (Open Hole)

SCREEN-PERFORATED INTERVALS: From ft. to ft., From ft. to ft., From ft. to ft. GRAVEL PACK INTERVALS: From ft. to ft., From ft. to ft., From ft. to ft.

9 GROUT MATERIAL: Neat cement Cement grout Bentonite Other

Grout Intervals: From ft. to ft., From ft. to ft., From ft. to ft. Nearest source of possible contamination: No potential source of contamination within 200 ft.

Septic Tank Lateral Lines Pit Privy Livestock Pens Insecticide Storage Sewer Lines Cess Pool Sewage Lagoon Fuel Storage Abandoned Water Well Watertight Sewer Lines Seepage Pit Feedyard Fertilizer Storage Oil Well/Gas Well Other (Specify)

Table with columns: 10 FROM TO LITHOLOGIC LOG FROM TO LITHO. LOG (cont.) or PLUGGING INTERVALS. Includes a Notes section.

11 CONTRACTOR'S OR LANDOWNER'S CERTIFICATION: This water well was constructed, reconstructed, or plugged under my jurisdiction and was completed on (mo-day-year) and this record is true to the best of my knowledge and belief.




LEGEND

- MW1 MONITOR WELL
- SVE1 SOIL VAPOR EXTRACTION WELL
- OBW1 SOIL VAPOR OBSERVATION WELL
- AS1 AIR SPARGE WELL
- DRAINAGE DIRECTION
- SS SANITARY SEWER LINE
- T UNDERGROUND TELEPHONE LINE
- METAL FENCE
- WOOD FENCE
- SITE BENCHMARK
- POWER POLE
- PP/T POWER POLE W/TRANSFORMER
- DEADMAN ANCHOR
- WS WATER SPIGOT
- CABLE TV PEDESTAL
- SANITARY MANHOLE
- TELEPHONE PEDESTAL
- TB PUBLIC TELEPHONE
- OE OVERHEAD ELECTRIC LINE
- V WATER LINE
- G GAS LINE

NE INDUSTRIAL LANE
CONCRETE SURFACING

3RD STREET
ASPHALT SURFACING

ONE STORY BUILDING
CONC BUILDING
10.5' HEIGHT

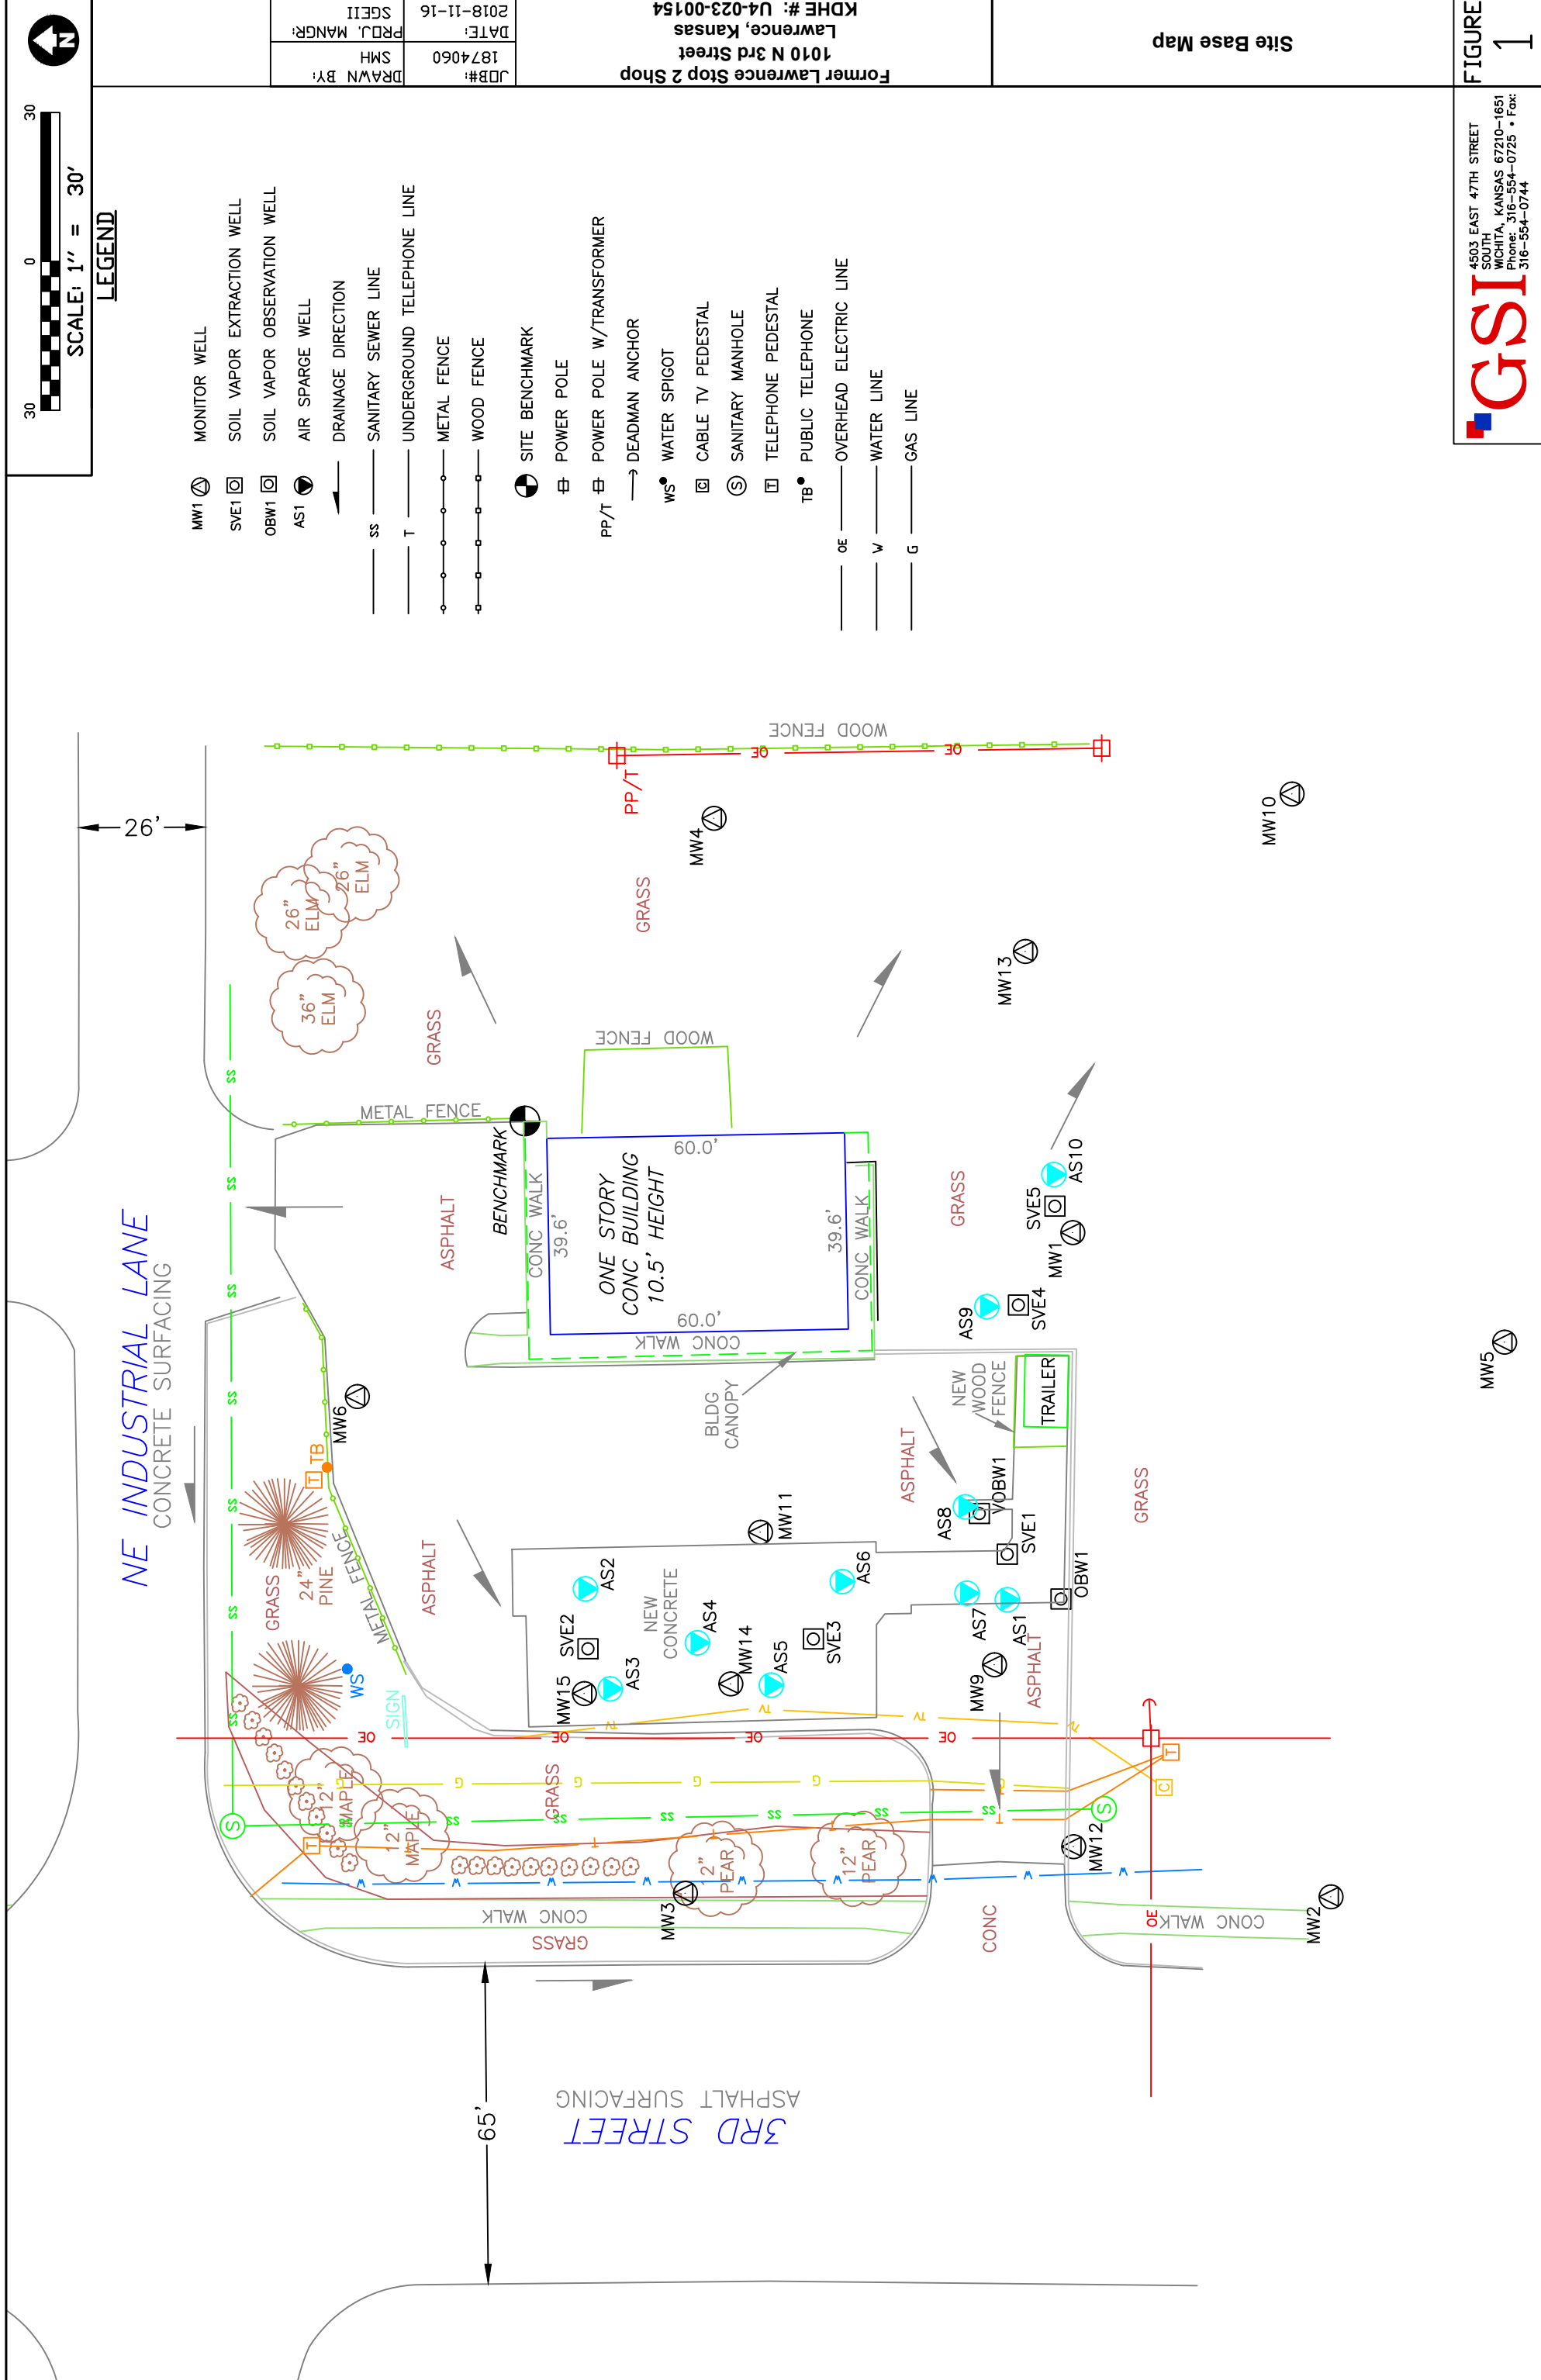

Former Lawrence Stop 2 Shop
1010 N 3rd Street
Lawrence, Kansas
KDHE #: U4-023-00154

JOB#: 1874060
DRAWN BY: SMH
DATE: 2018-11-16
PROJ. MANGR: SGETI

Site Base Map

FIGURE
1

GSI
4503 EAST 47TH STREET
SUITE 100
WICHITA, KANSAS 67210-1651
PHONE: 316-554-0725 • FAX:
316-554-0744

MW5